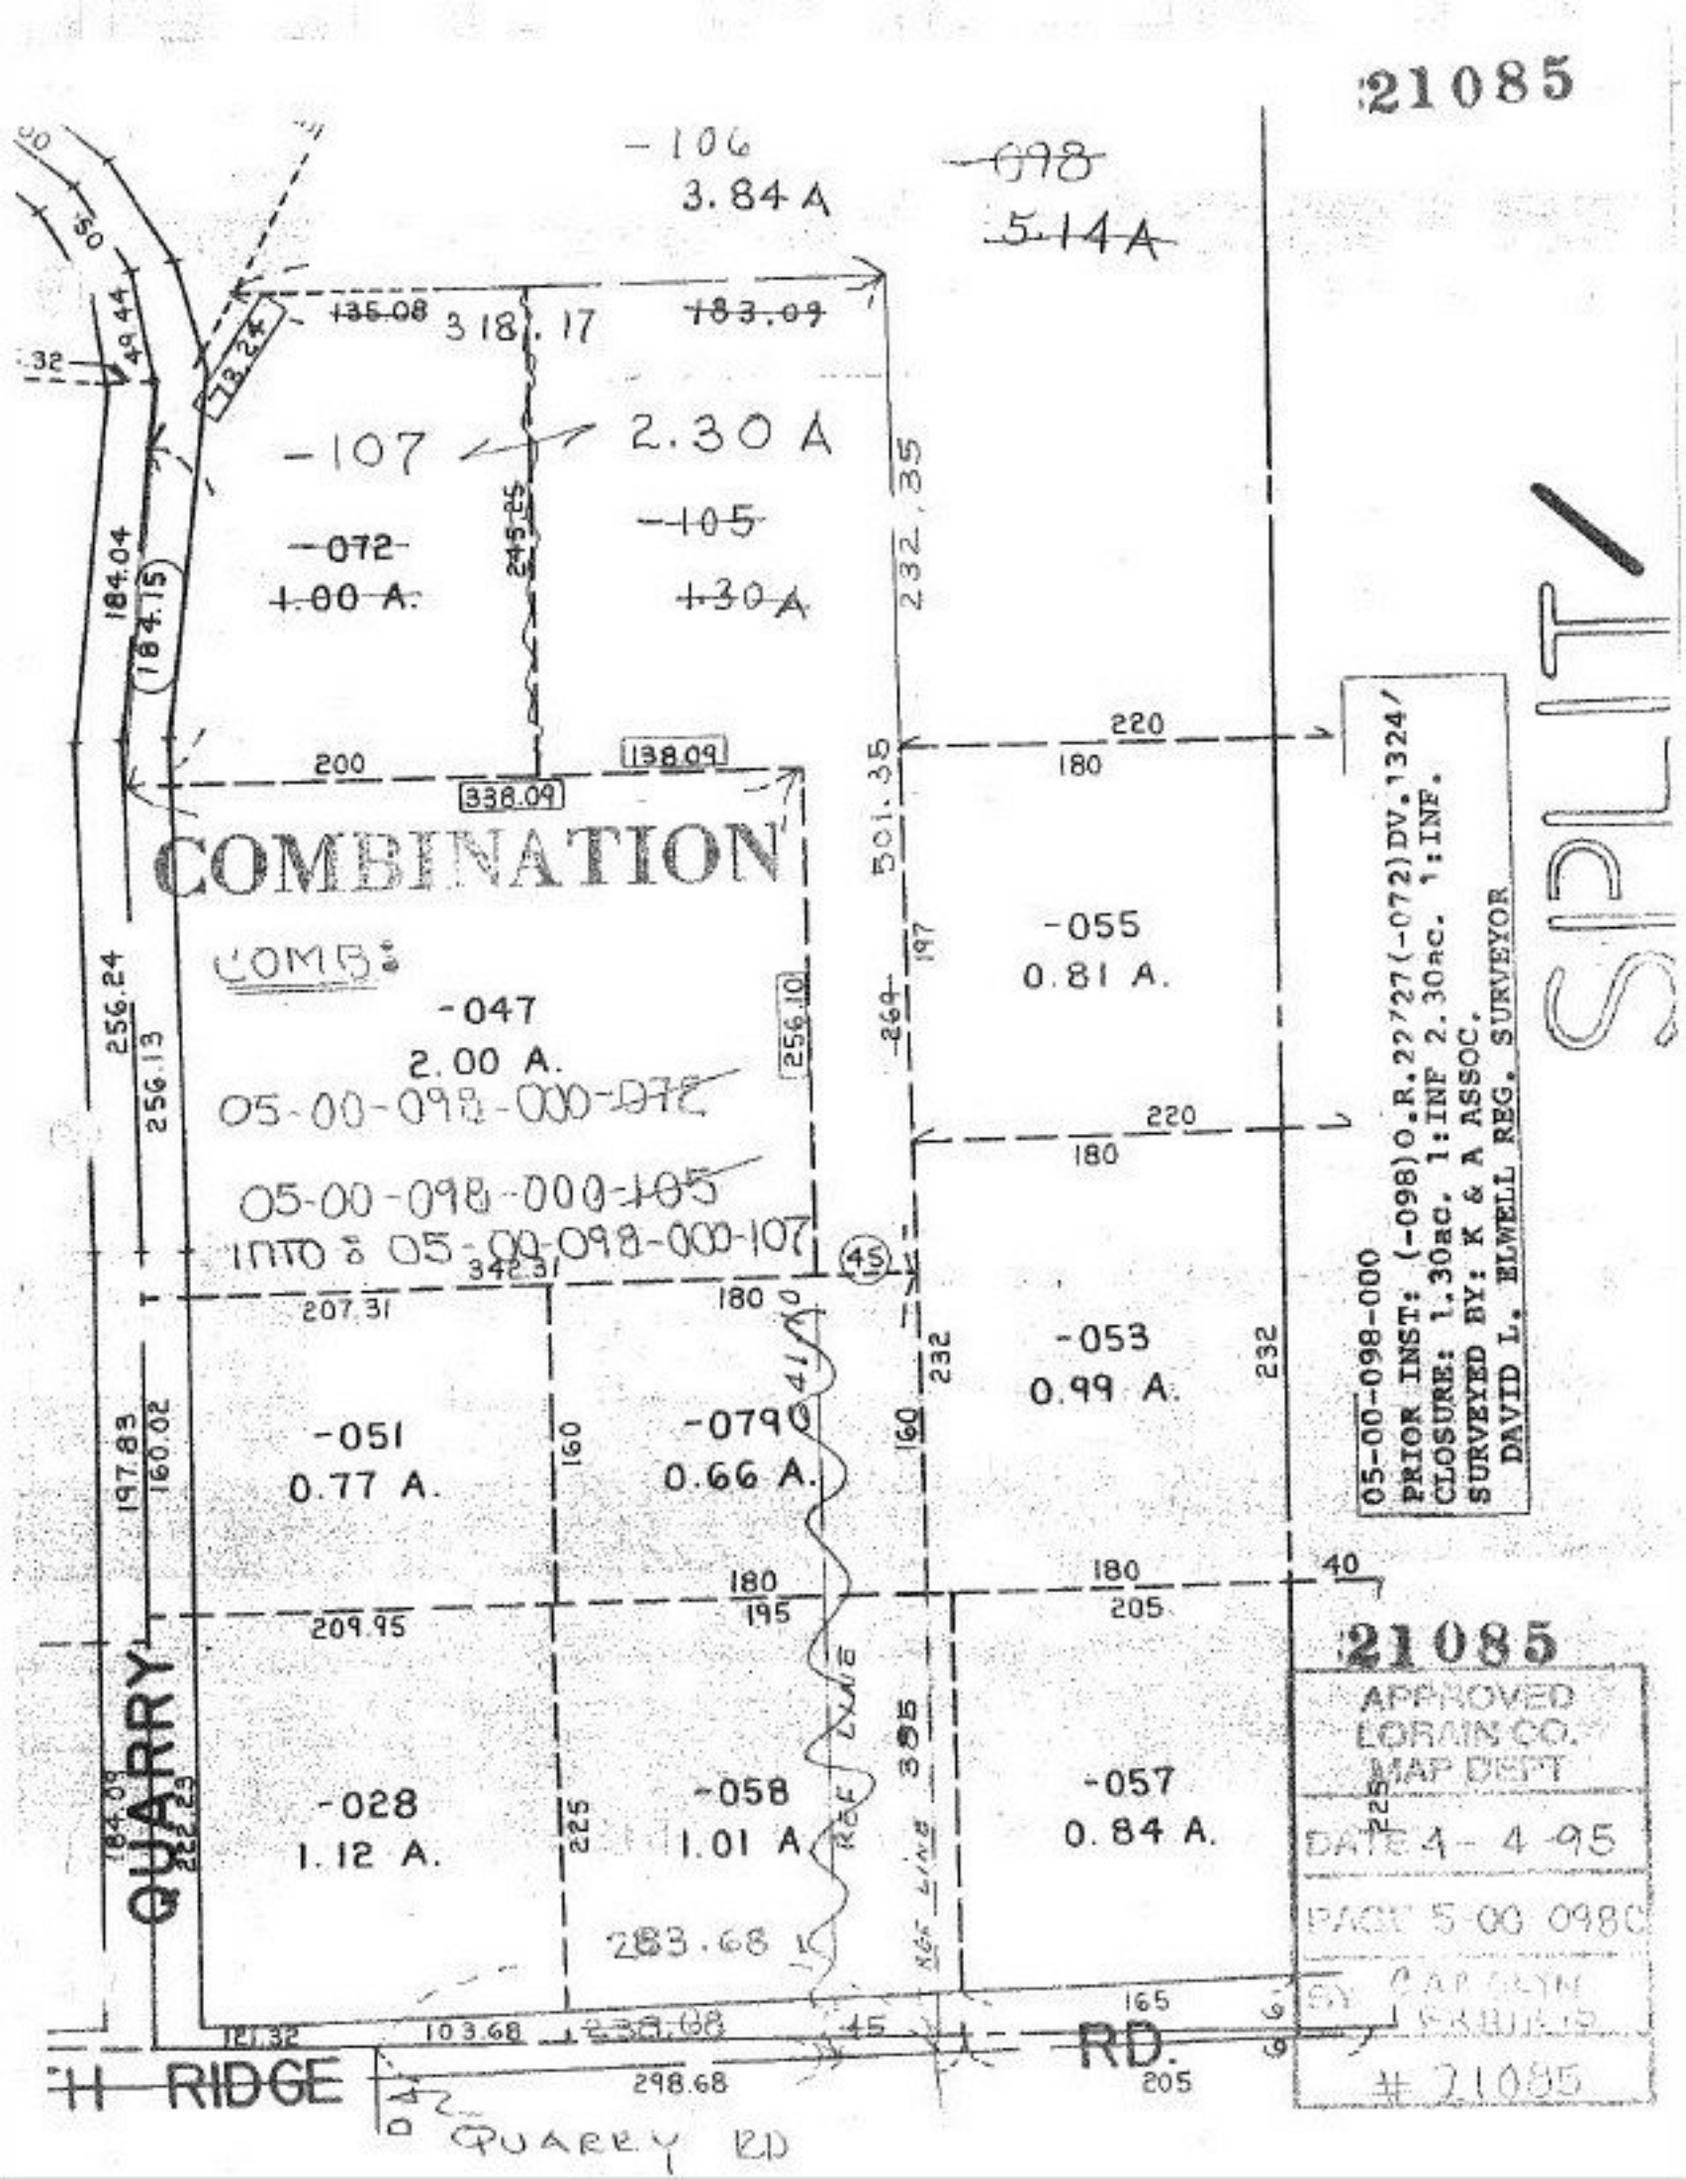
21085
-106
3.84 A
-098
5.14 A
135.08
318.17
183.09
-107
2.30 A
-072
1.00 A.
-105
1.30 A
245.85
232.35
184.04
(184.15)
49.44
13.24
132
200
138.09
338.09
220
180
501.35
COMBINATION
-055
0.81 A.
COMB
-047
2.00 A.
05-00-098-000-072
05-00-098-000-105
INTO 05-00-098-000-107
256.24
256.13
256.10
264
197
342.31
207.31
180
-053
0.99 A.
232
-051
0.77 A.
-079
0.66 A.
160
197.83
160.02
180
195
180
205
40
209.95
-028
1.12 A.
-058
1.01 A
283.68
225
385
REF LINE
-057
0.84 A.
184.09
222.23
165
121.32
103.68
239.08
45
298.68
205
RIDGE
QUARRY
RD.
QUARRY RD
05-00-098-000
PRIOR INST: (-098) O.R. 22727 (-072) DV. 1324/
CLOSURE: 1.30ac. 1:INF 2.30ac. 1:INF.
SURVEYED BY: K & A ASSOC.
DAVID L. ELWELL REG. SURVEYOR
SPLIT
21085
APPROVED
LORAIN CO.
MAP DEPT
DATE 4-4-95
PAGE 5-00 098
BY CAP GUN
21085