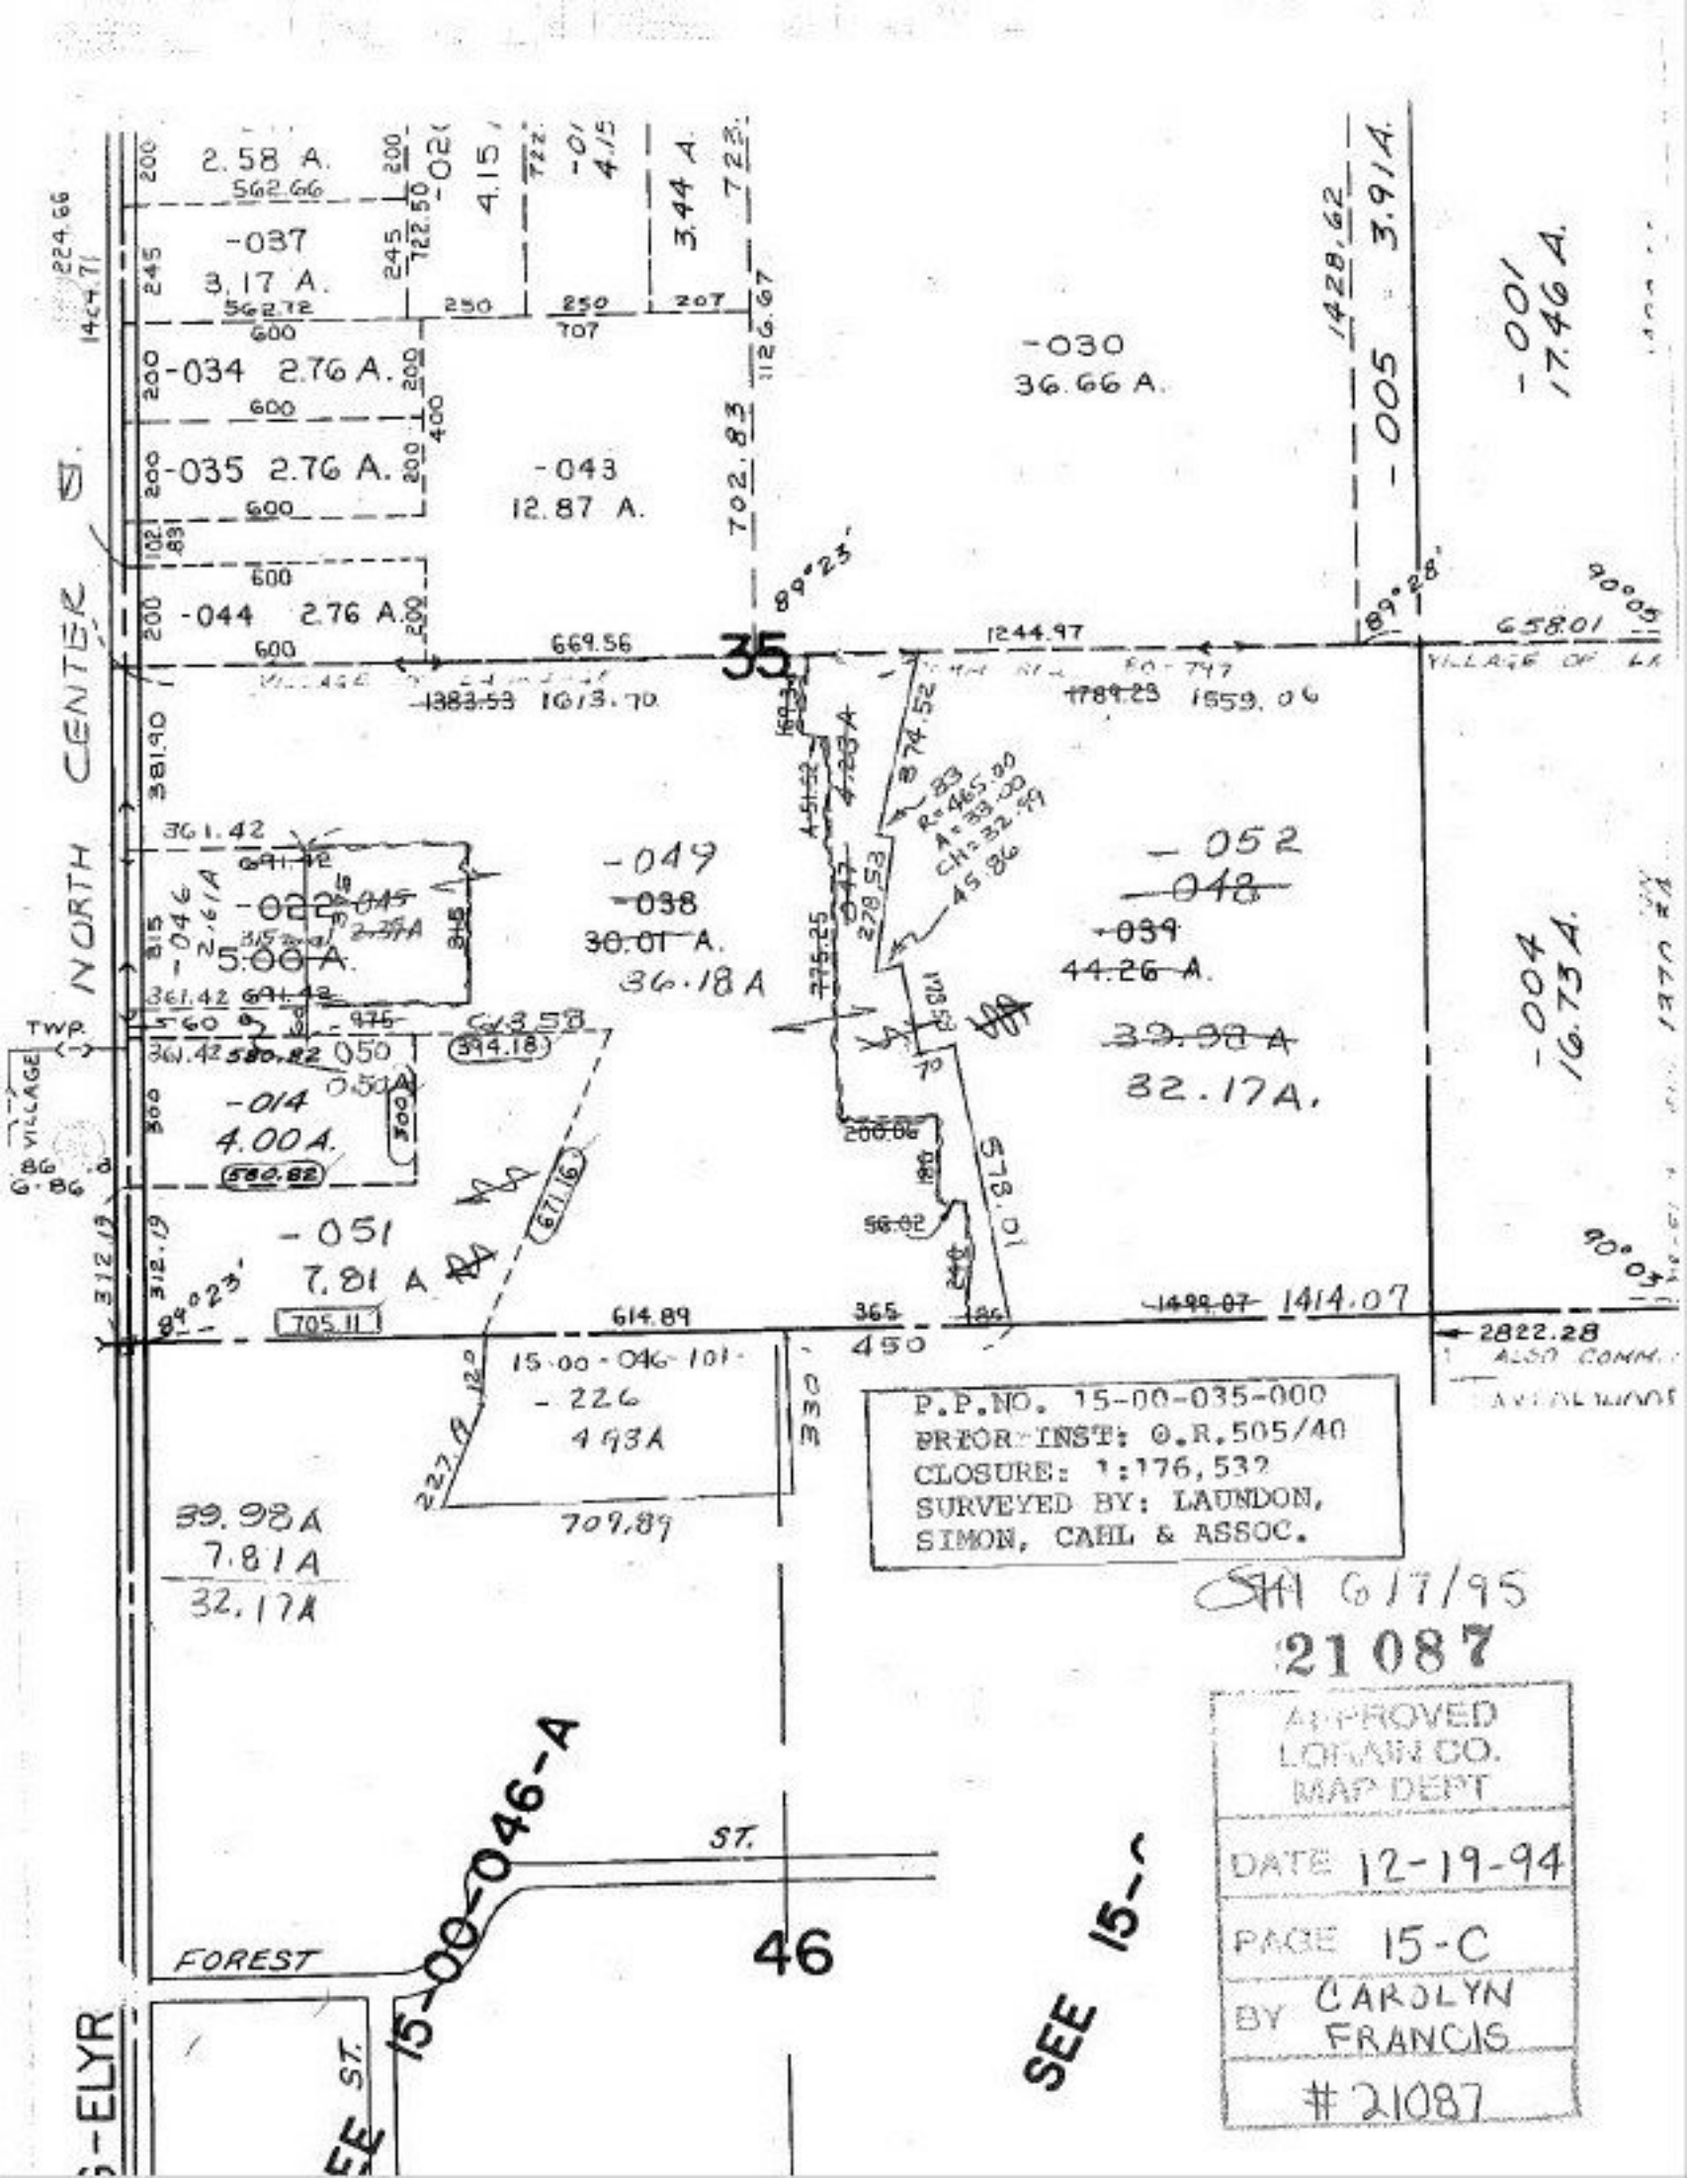
NORTH CENTER ST.
2.58 A.
-037
3.17 A.
-034 2.76 A.
-035 2.76 A.
-044 2.76 A.
-043
12.87 A.
-030
36.66 A.
-001
17.46 A.
-005 3.914.
-004
16.73 A.
-052
-048
-039
44.26 A.
39.98 A
32.17A.
-049
-038
30.01 A.
36.18 A
-022
5.00 A.
-046
2.61A
-014
4.00A.
-051
7.81 A
15-00-046-101
-226
4.93A
39.98A
7.81A
32.17A
35
46
FOREST ST.
15-00-046-A
SEE 15-
TWP.
VILLAGE OF
P.P.NO. 15-00-035-000
PRIOR INST: O.R.505/40
CLOSURE: 1:176,532
SURVEYED BY: LAUNDON, SIMON, CAHL & ASSOC.
SH 6/7/95
21087
APPROVED
LORAIN CO.
MAP DEPT
DATE 12-19-94
PAGE 15-C
BY CAROLYN FRANCIS
#21087