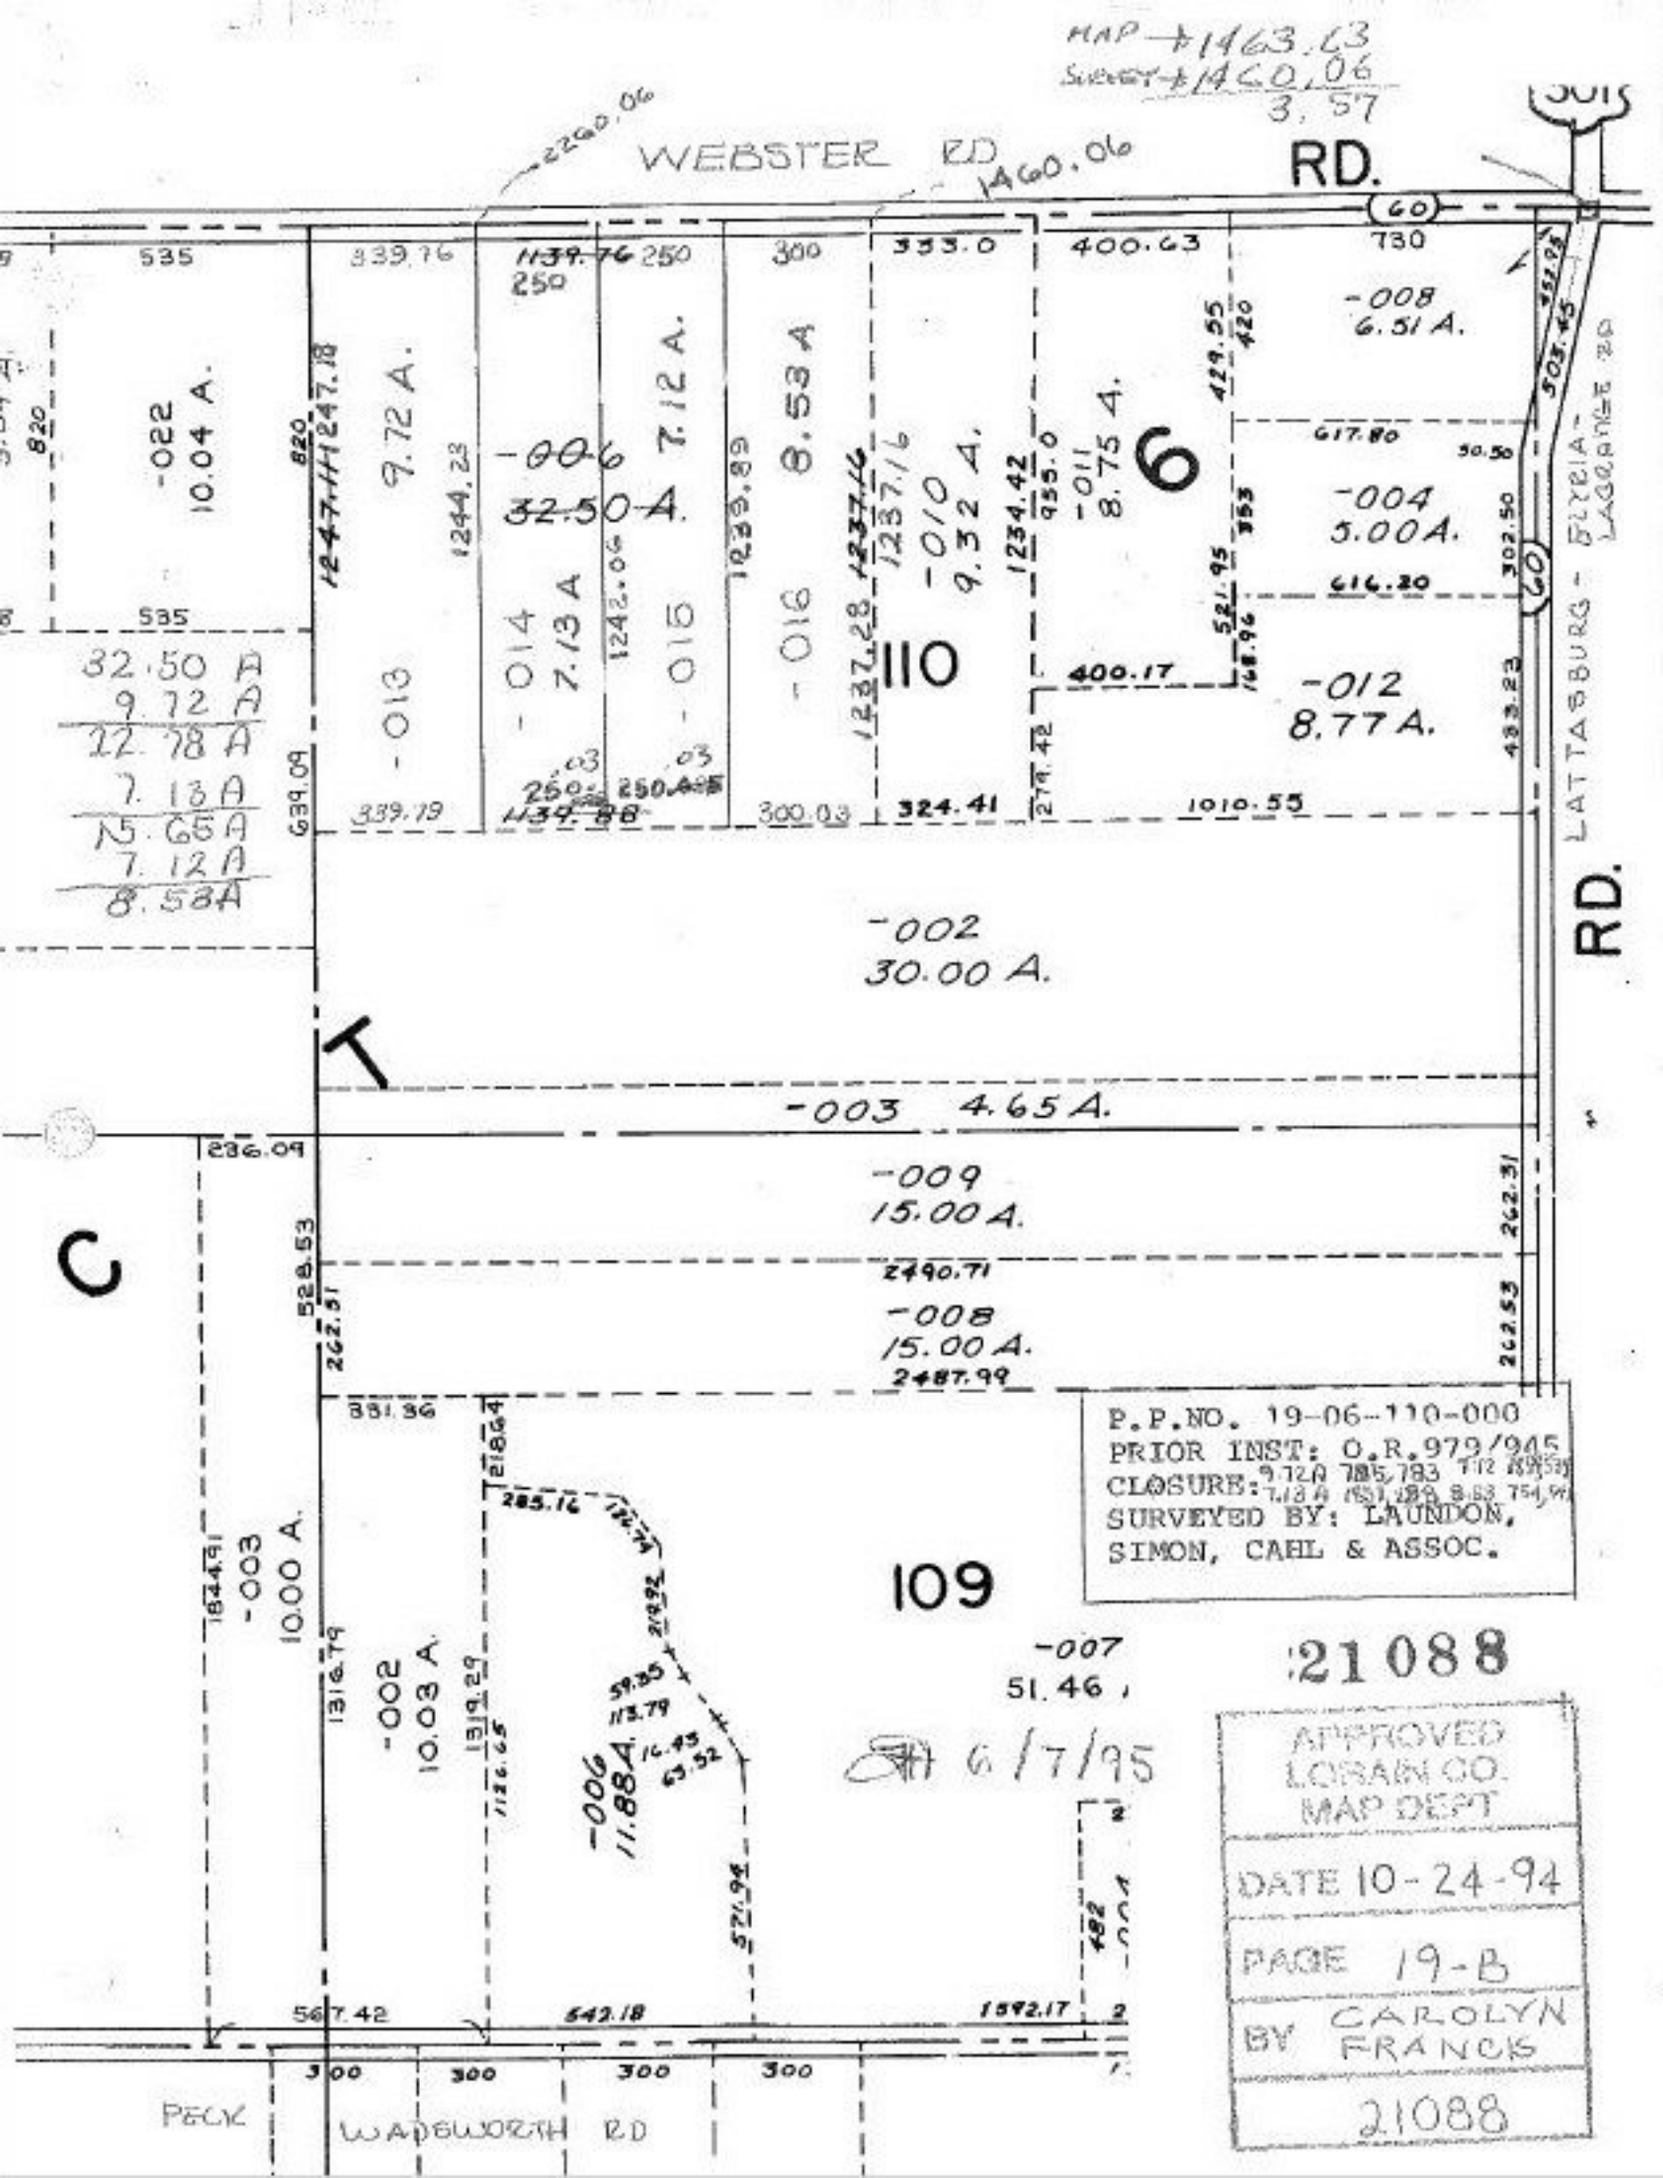
MAP +1463.63
SURVEY +1460.06
3.57
WEBSTER RD
2260.06
1460.06
RD.
60
730
-008
6.51 A.
-004
5.00A.
-012
8.77A.
-011
8.75 A.
6
110
-010
9.32 A.
-014
7.13 A
-016
8.53 A
-006
7.12 A.
32.50 A.
-013
9.72 A.
-022
10.04 A.
32.50 A
9.72 A
12.78 A
7.13 A
19.65 A
7.12 A
8.53 A
-002
30.00 A.
-003 4.65 A.
-009
15.00 A.
-008
15.00 A.
2490.71
2487.99
C
-003
10.00 A.
-002
10.03 A.
109
-007
51.46
-006
11.884
P.P.NO. 19-06-110-000
PRIOR INST: O.R. 979/945
CLOSURE: 9.72A 785,783 7.12 A
7.13 A 851,289 8.53 754,9
SURVEYED BY: LAUNDON, SIMON, CAHL & ASSOC.
21088
APPROVED
LORAIN CO.
MAP DEPT
DATE 10-24-94
PAGE 19-B
BY CAROLYN FRANCIS
21088
6/7/95
LATTASBURG - BRYCIA - LAGRANGE RD
PECK
WADSWORTH RD