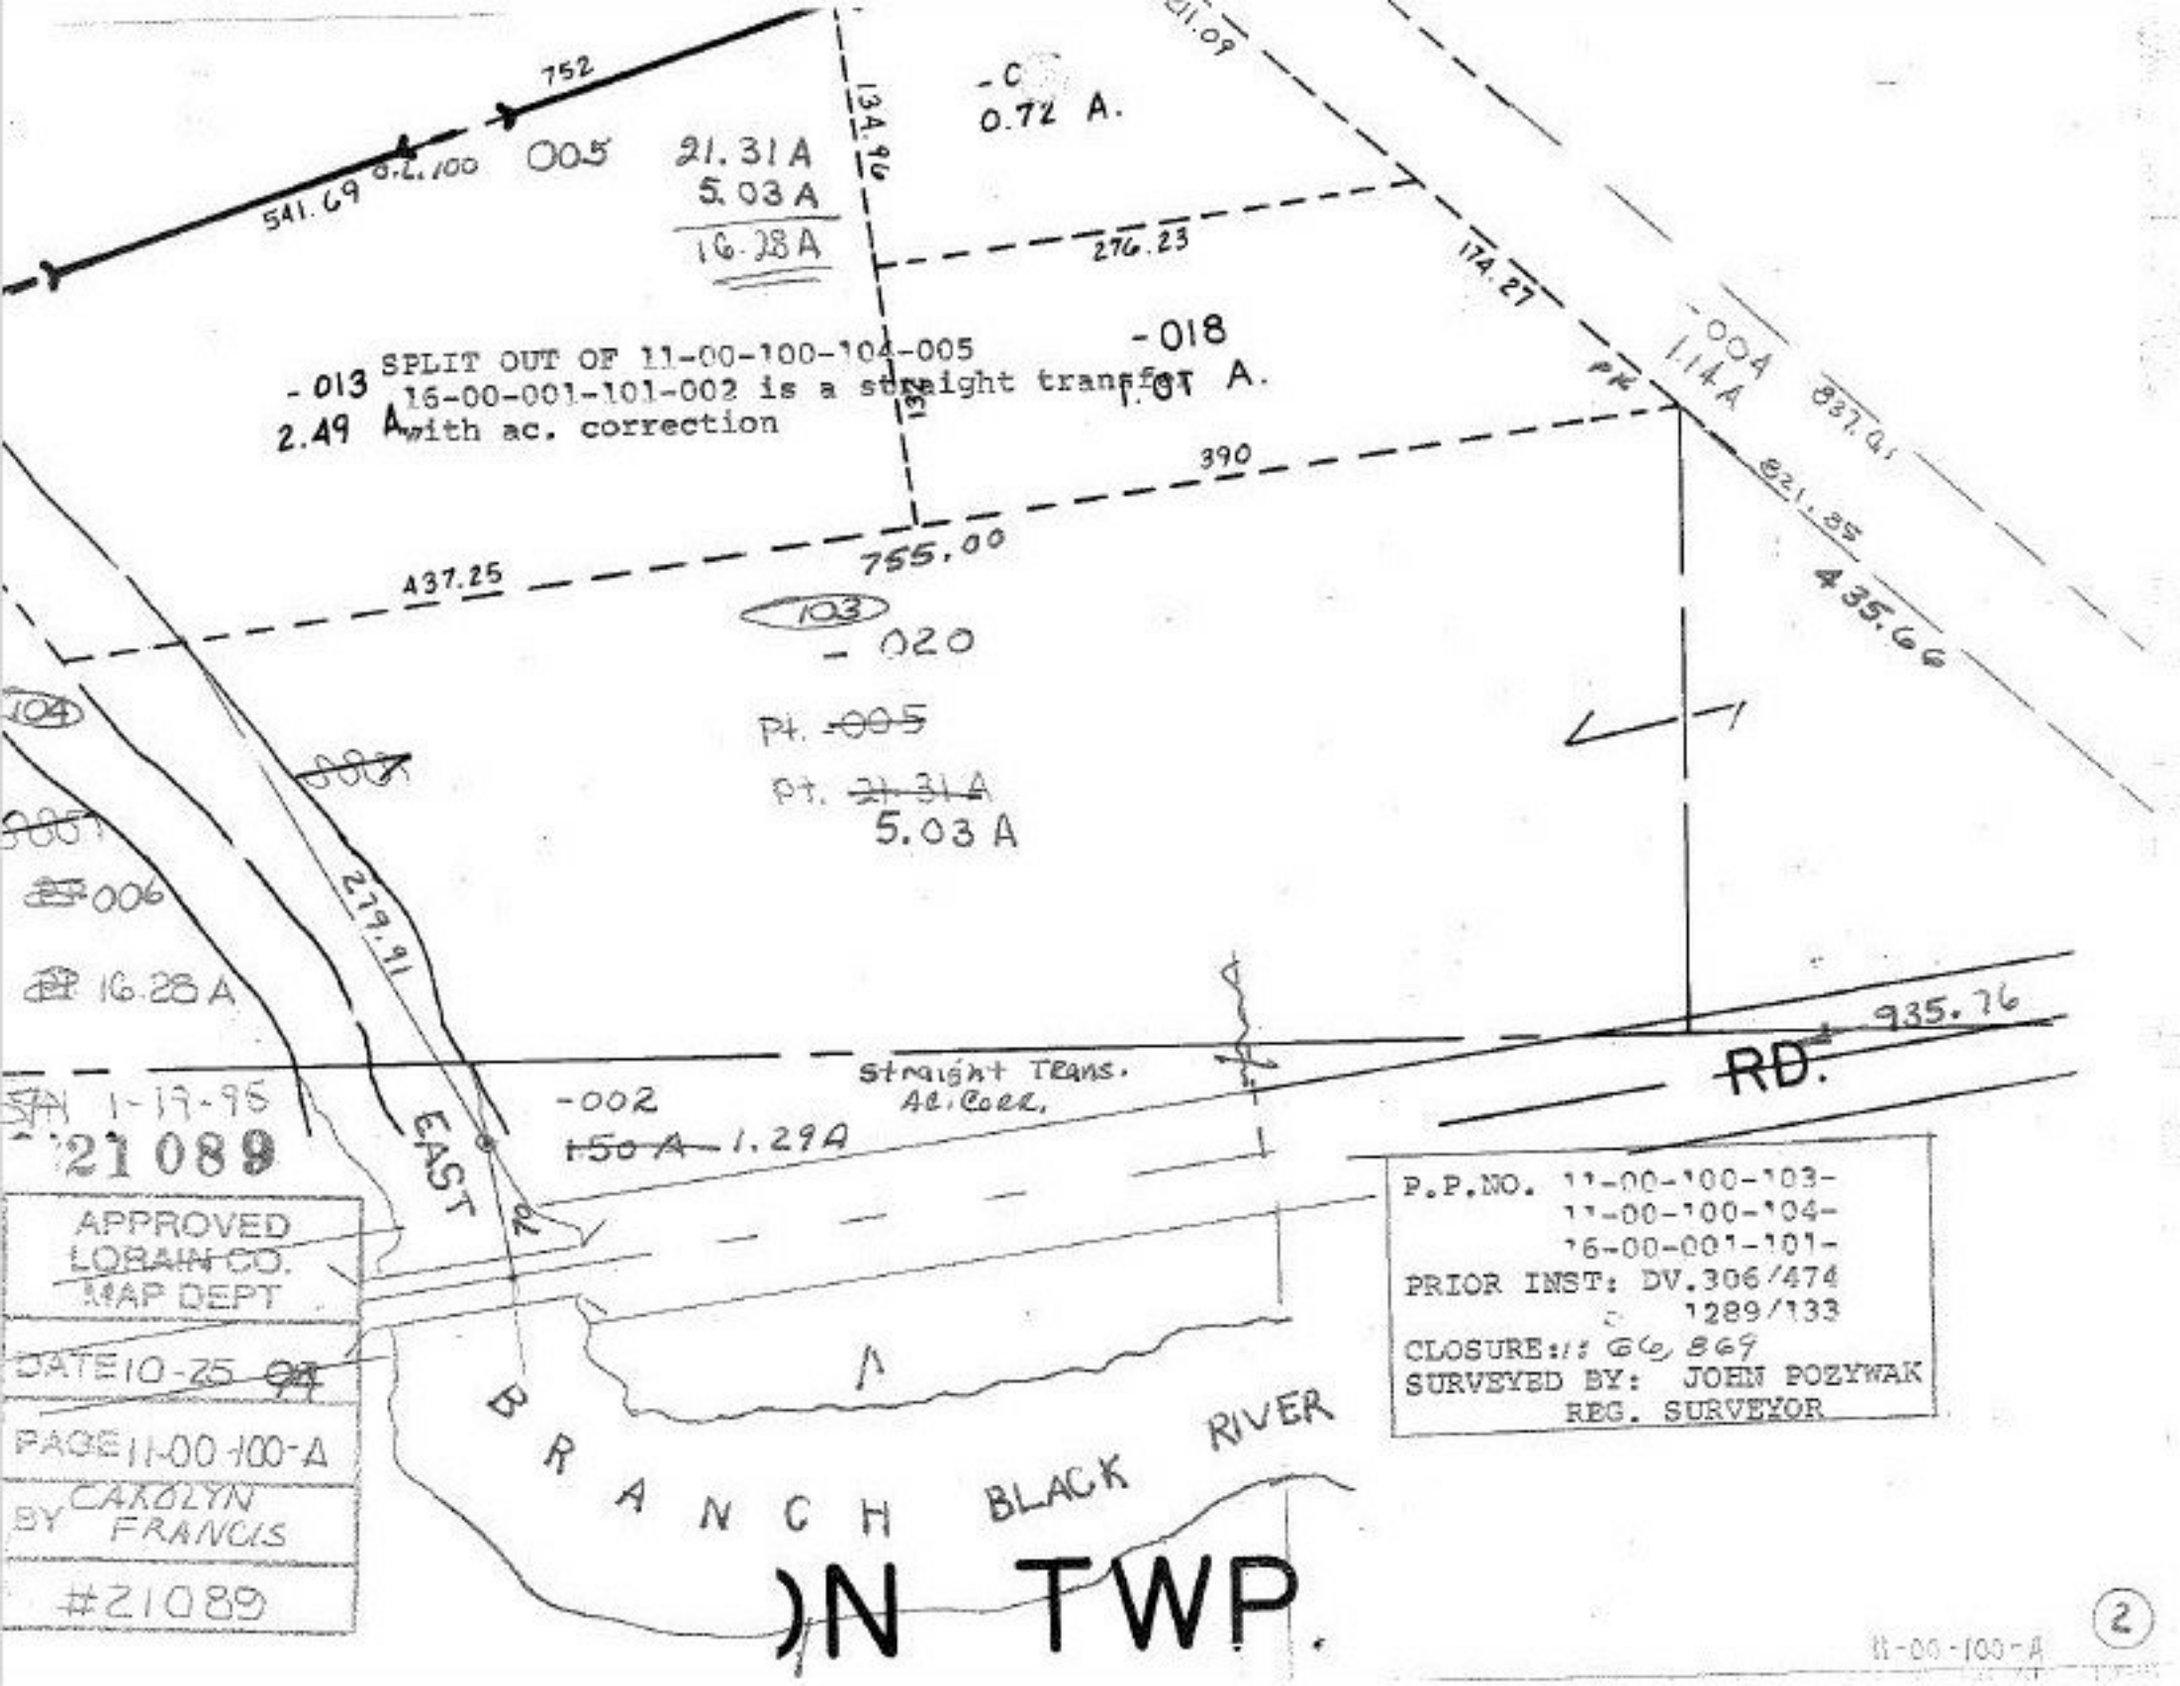

P.P.NO. 11-00-100-103-
11-00-100-104-
16-00-001-101-
PRIOR INST: DV.306/474
1289/133
CLOSURE: 66,869
SURVEYED BY: JOHN POZYWAK
REG. SURVEYOR

21089

APPROVED
LORAIN CO.
MAP DEPT
DATE 10-25-94
PAGE 11-00-100-A
BY CAROLYN FRANCIS
#21089

11-00-100-A

2