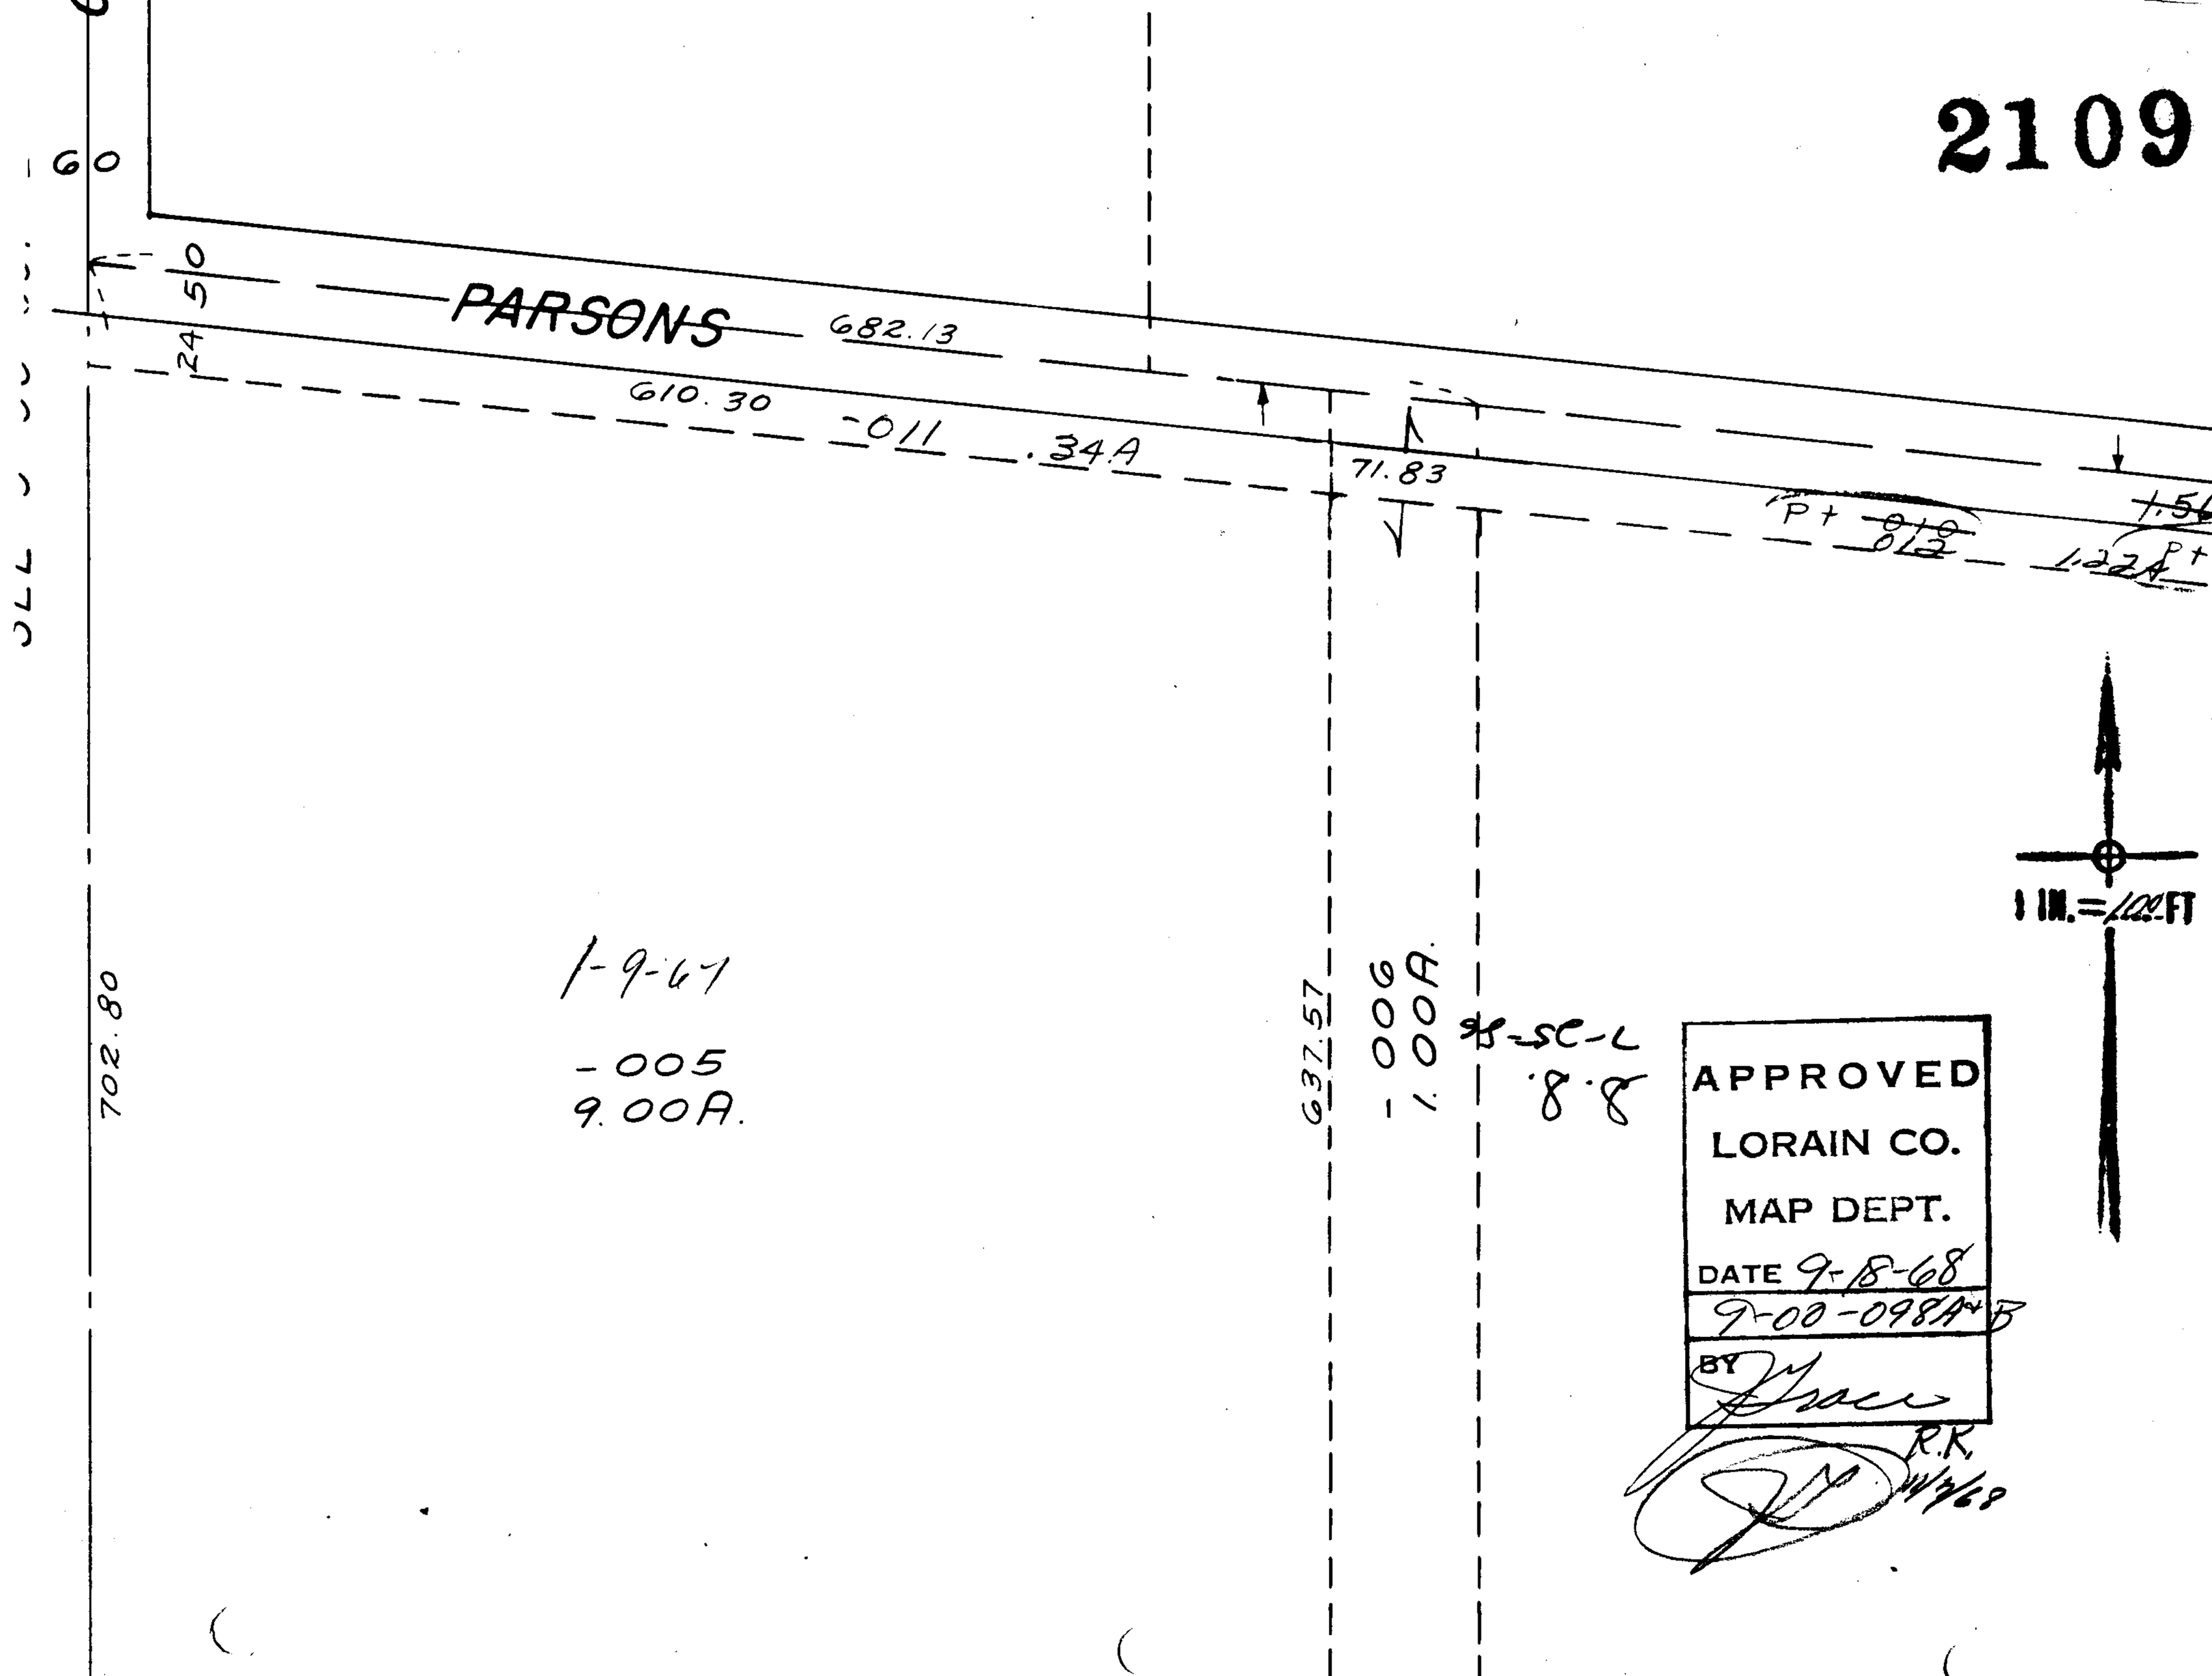
2109
60
50
24
PARSONS
682.13
610.30
-011
.34A
71.83
P+ 010
012
1.56
1.22A
P+
1 IN.=100 FT
702.80
1-9-67
-005
9.00A.
637.57
-006
1.00A.
8.8
APPROVED
LORAIN CO.
MAP DEPT.
DATE 9-18-68
9-00-098A+B
BY
R.K.
11/7/68