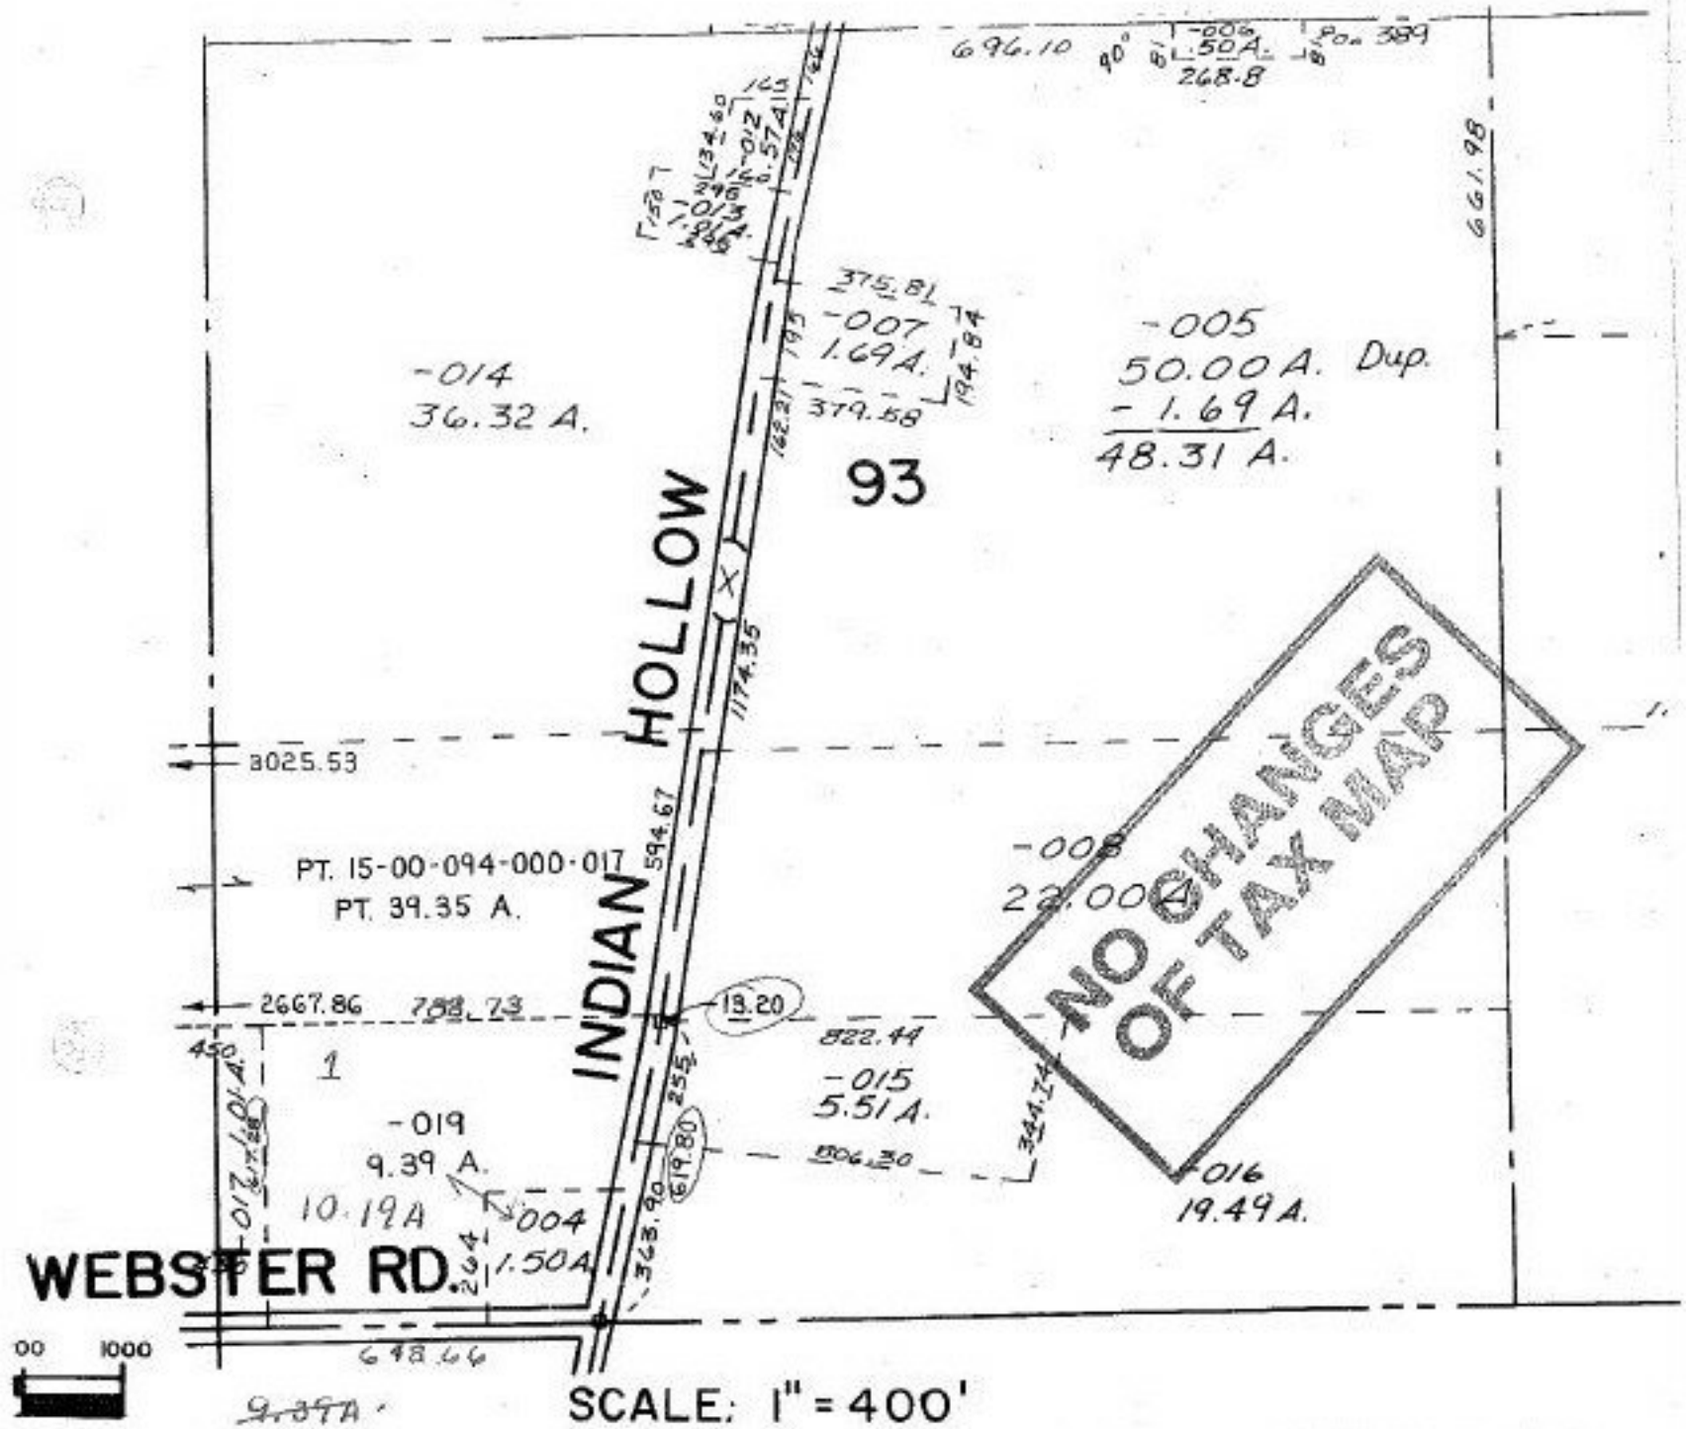

~~9.39A.~~
~~1.50A.~~
~~10.89A~~

SH 6/7/95

DEED (1) #21091A AC. CORR. CAN NOT BE DONE UNLESS
PARCELS 15-000-093-000-004 1.50 ac.
-019 9.39 ac.
~~10.89 ac.~~
10.19 ac. PERPOSE AC. CORR.

21091 A

APPROVED LORAIN CO. MAP DEPT
DATE 10-28-94
PAGE 15-H
BY CAROLYN FRANCIS
21091A

SEE # 21115 FOR COMB/ AC. CORR.

15-H