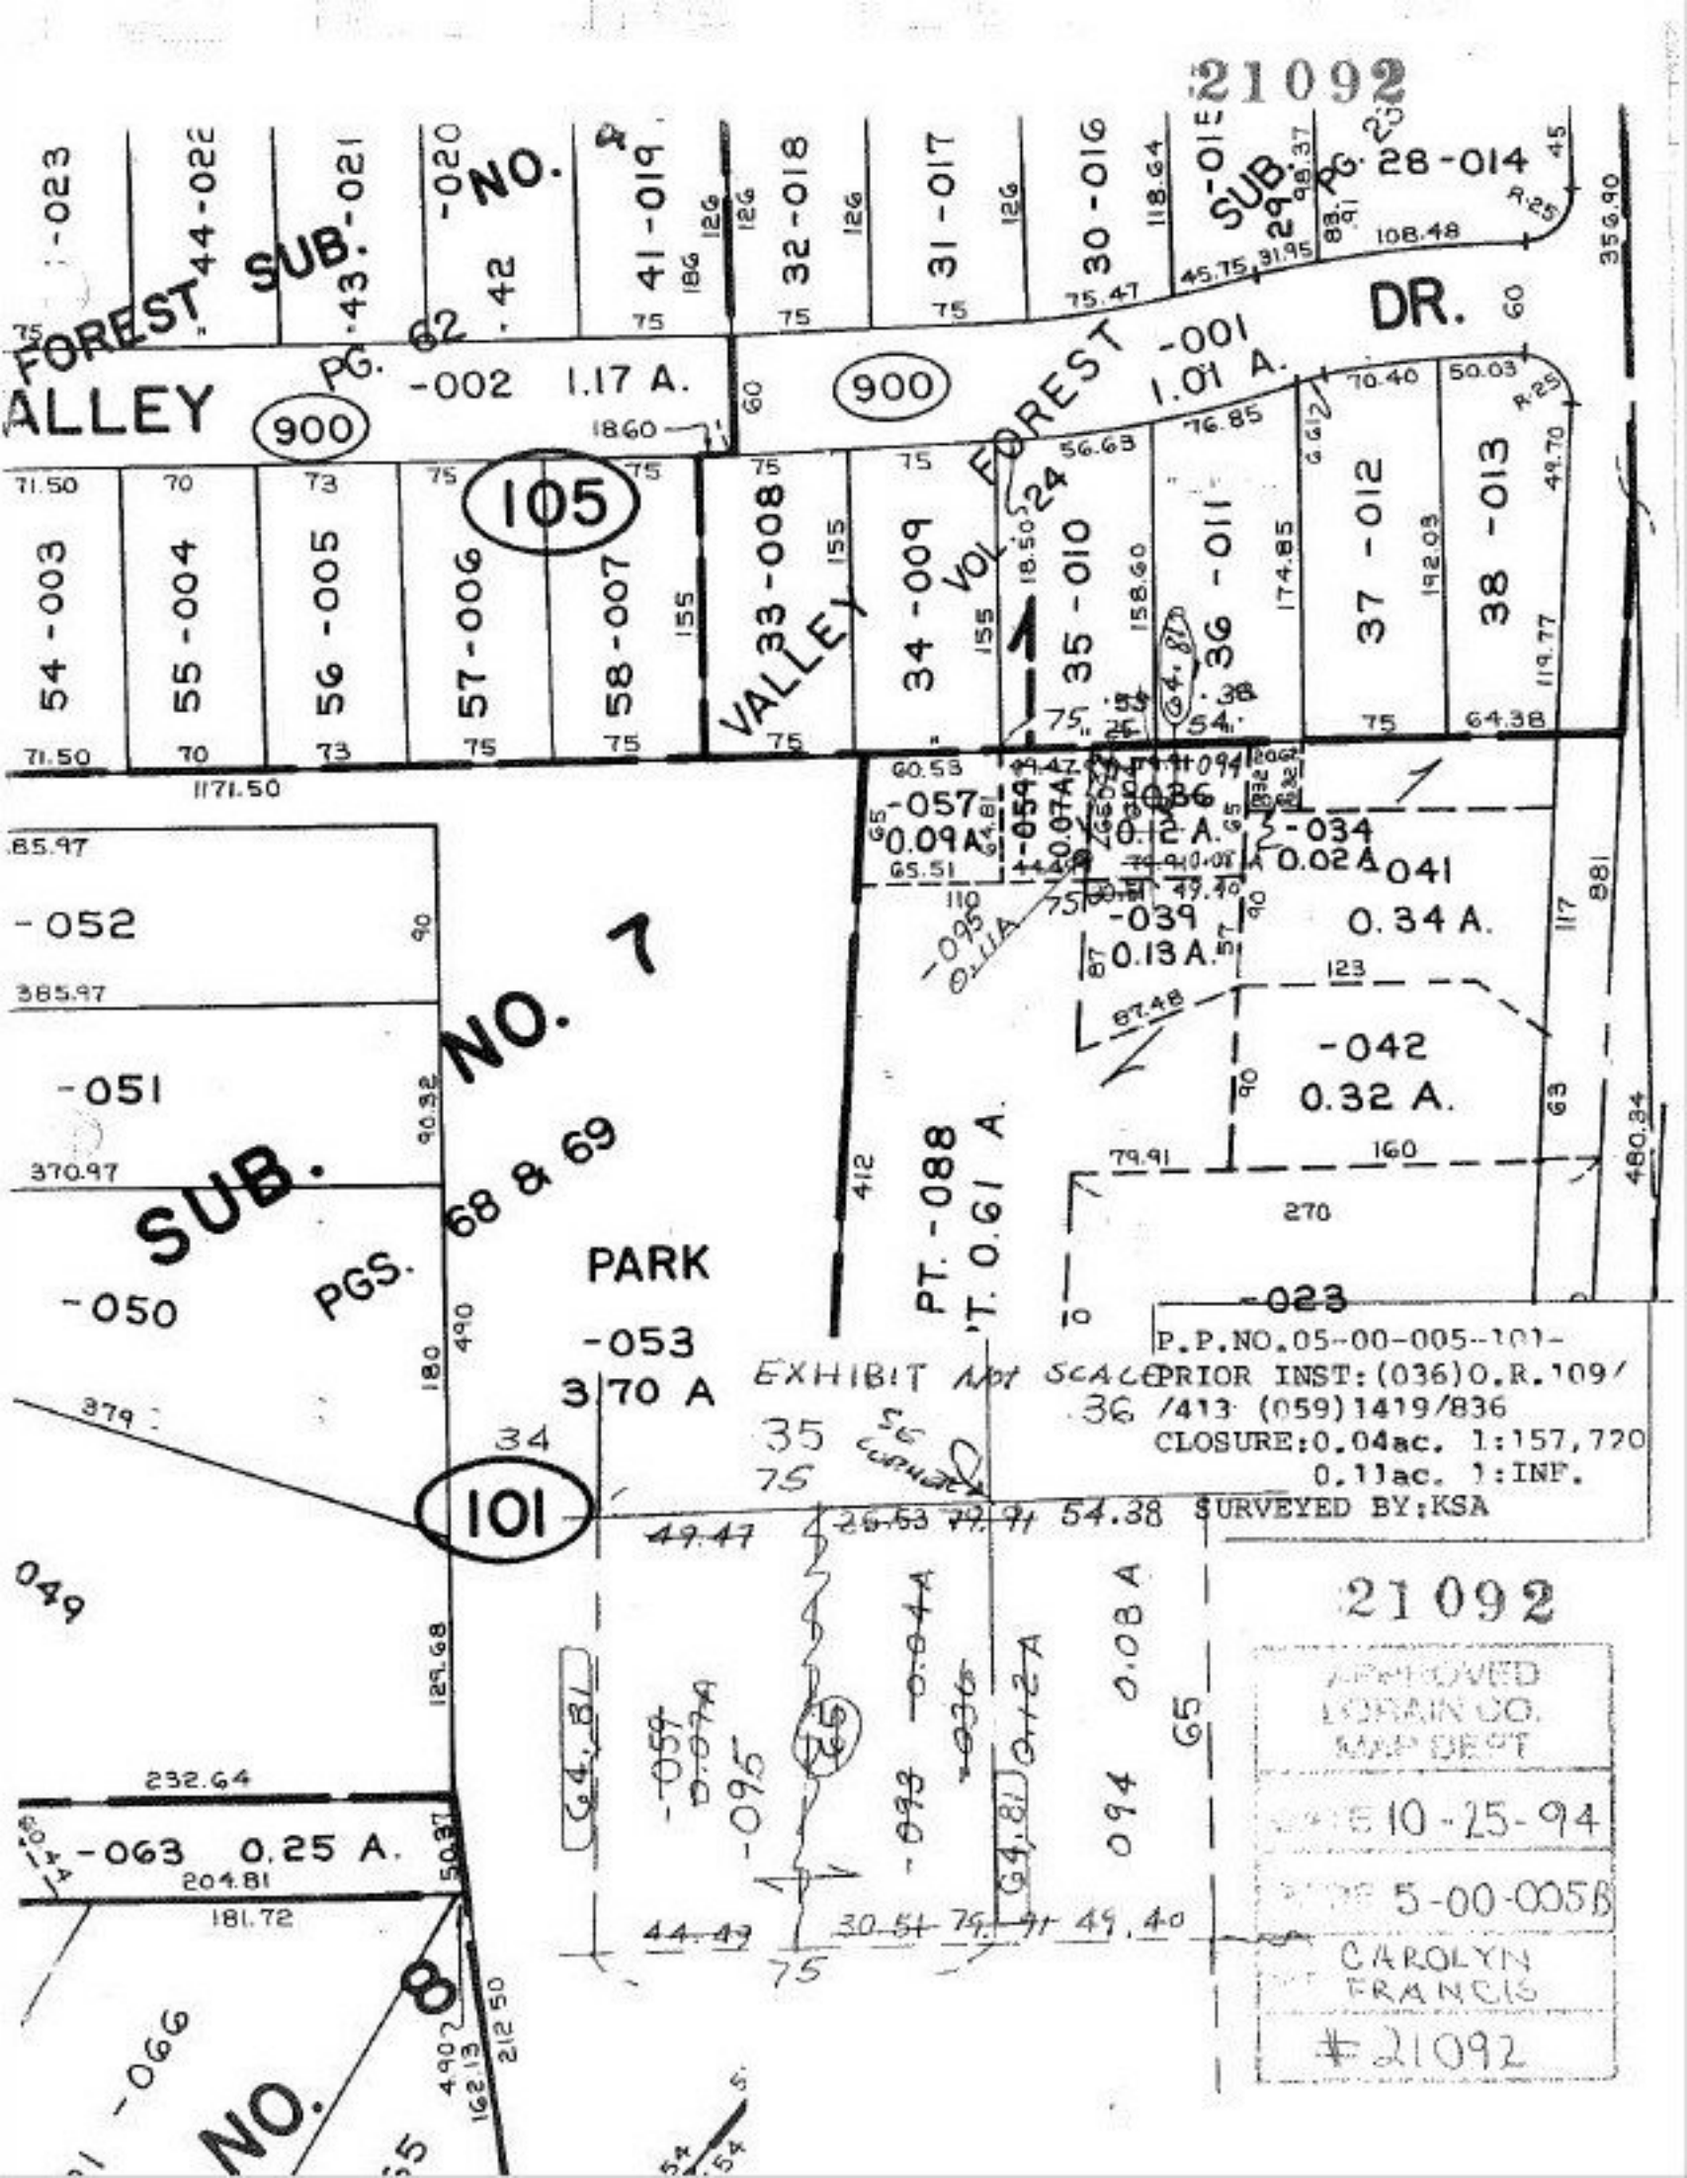
21092
PG. 62
ALLEY
900
DR.
105
101
SUB. PGS. 68 & 69
PARK
-053
3.70 A
-088
PT. 0.61 A.
-042
0.32 A.
0.34 A.
0.13 A.
0.09 A
0.02 A
-063 0.25 A.
EXHIBIT NOT SCALE
P.P.NO.05-00-005-101-
PRIOR INST: (036)O.R.109/36 /413 (059)1419/836
CLOSURE:0.04ac. 1:157,720
0.11ac. 1:INF.
SURVEYED BY:KSA
21092
APPROVED
LORAIN CO.
MAP DEPT
DATE 10-25-94
5-00-005B
CAROLYN
FRANCIS
#21092