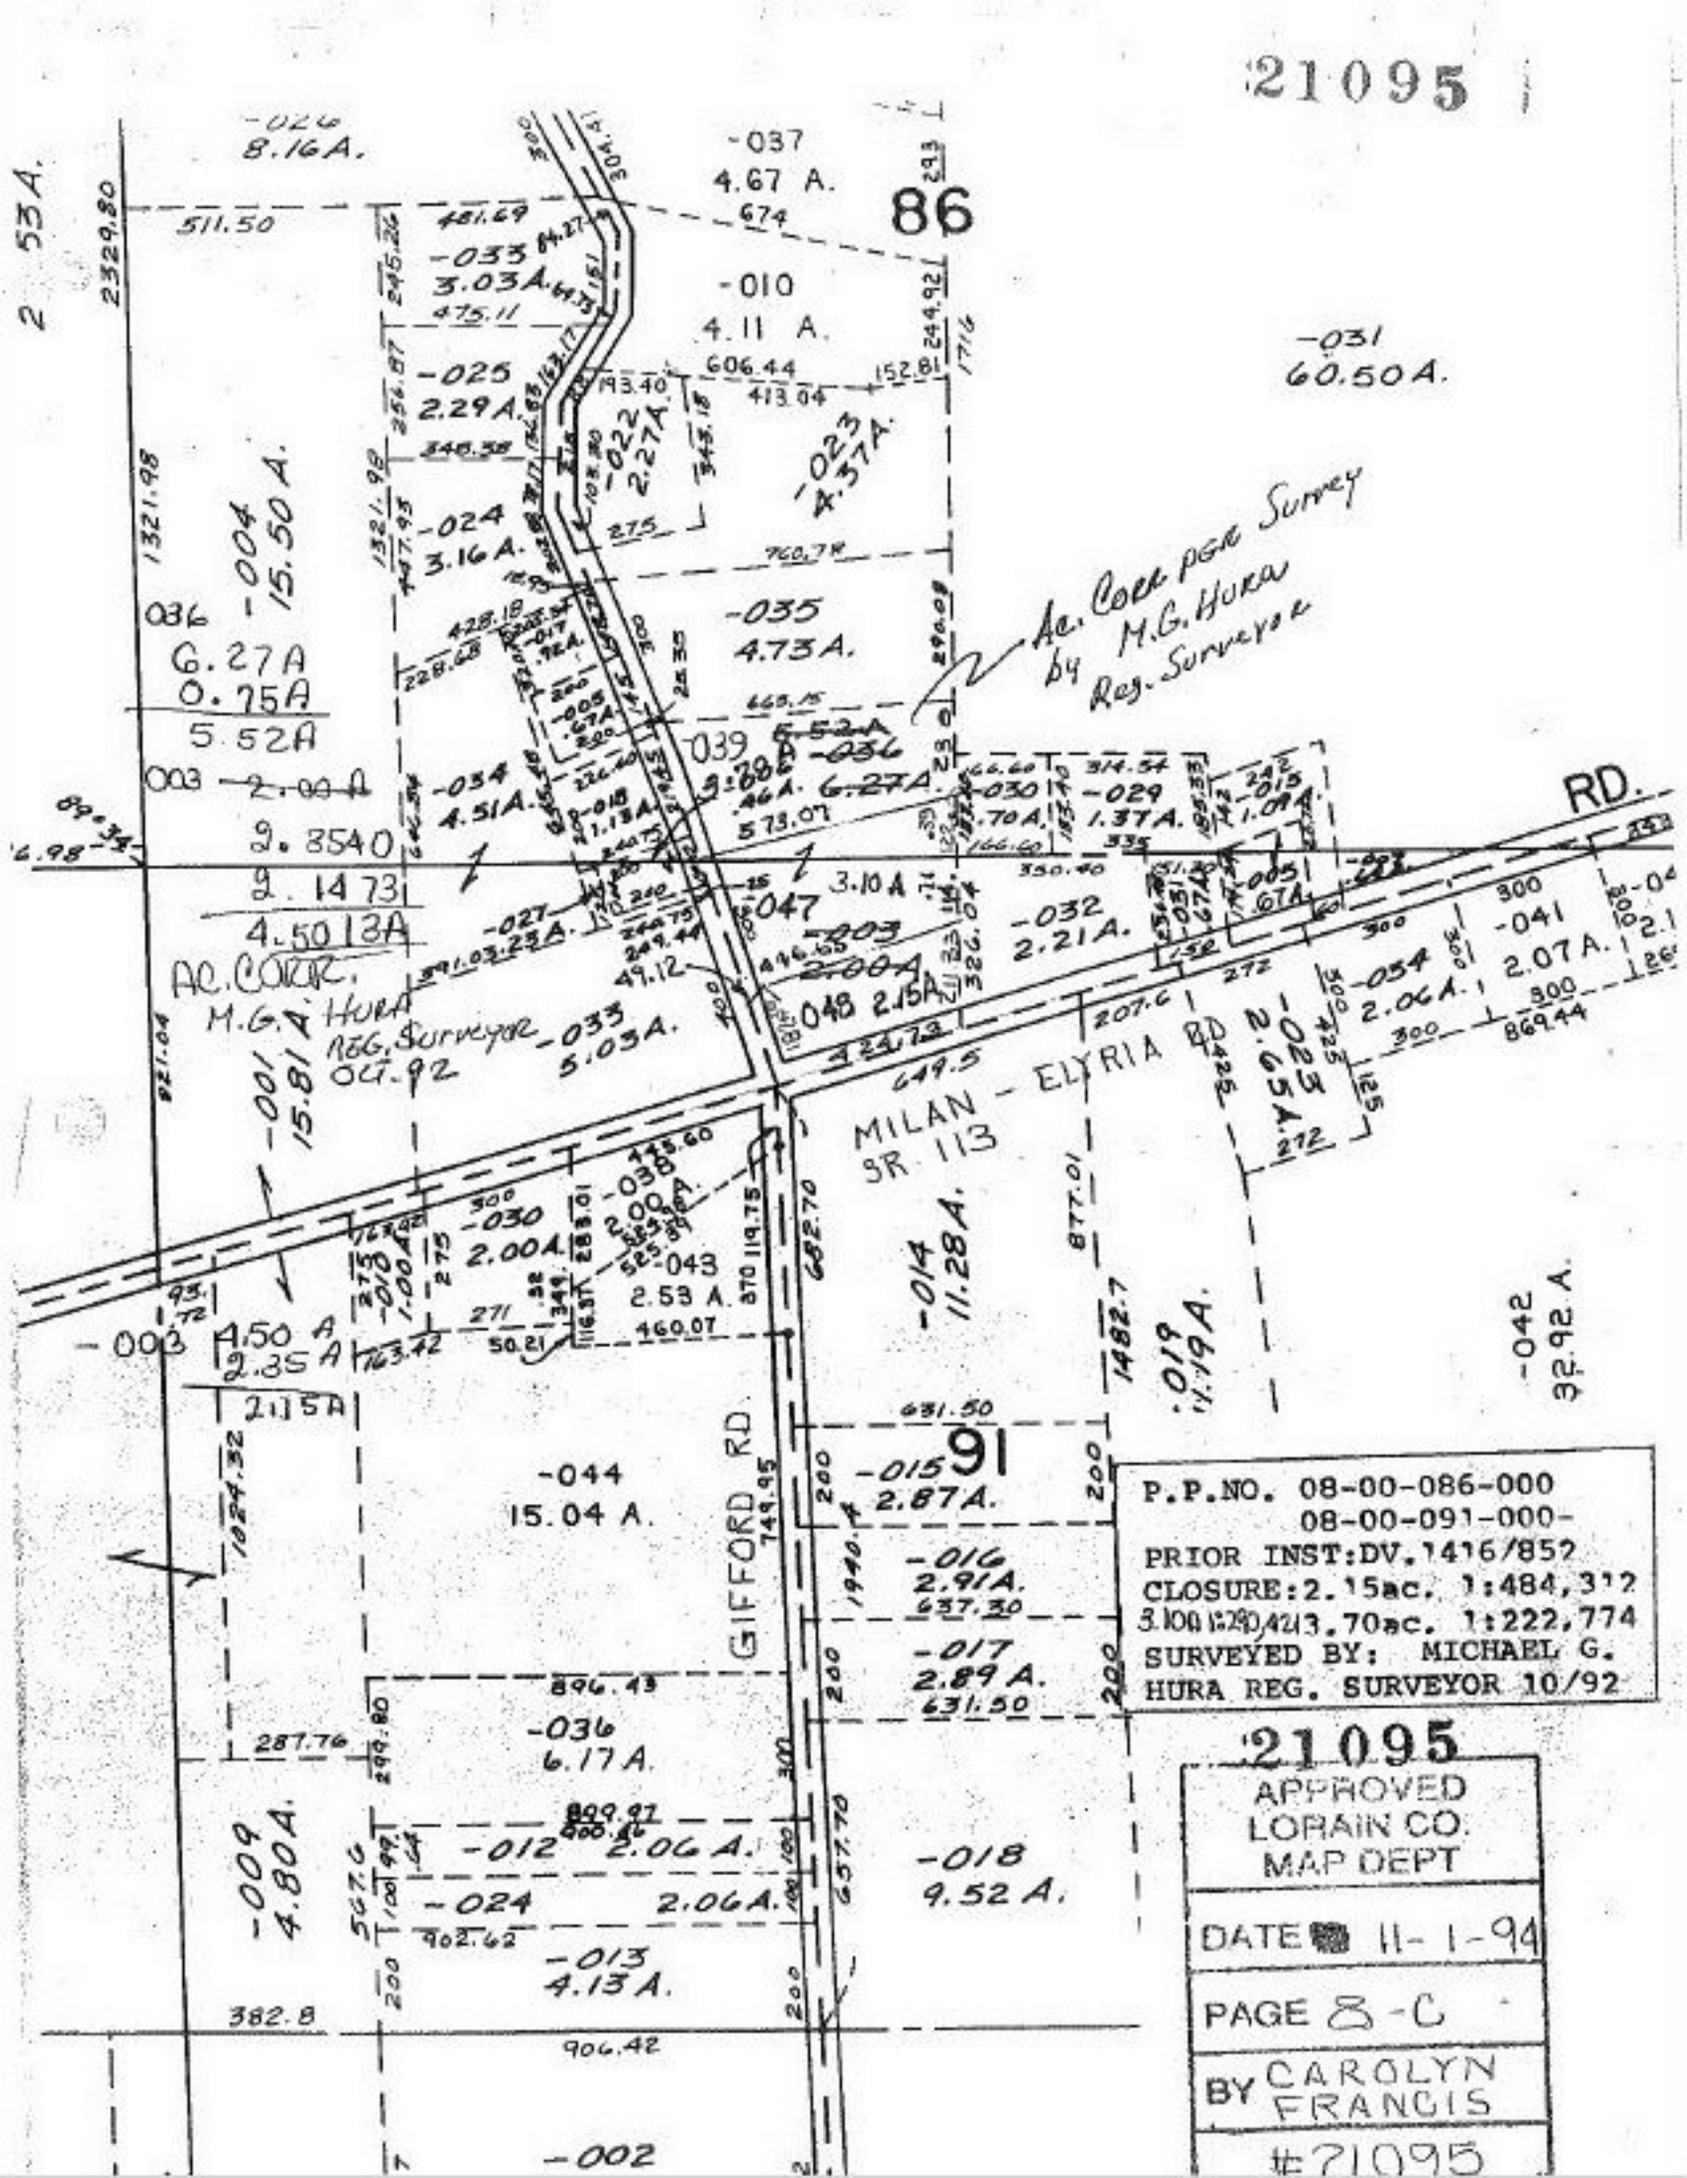

P.P.NO. 08-00-086-000
08-00-091-000-
PRIOR INST: DV. 1416/852
CLOSURE: 2.15ac. 1:484,312
3.10ac. 1:290,423 3.70ac. 1:222,774
SURVEYED BY: MICHAEL G.
HURA REG. SURVEYOR 10/92

21095

APPROVED
LORAIN CO.
MAP DEPT

DATE 11-1-94

PAGE 8-C

BY CAROLYN FRANCIS

#21095