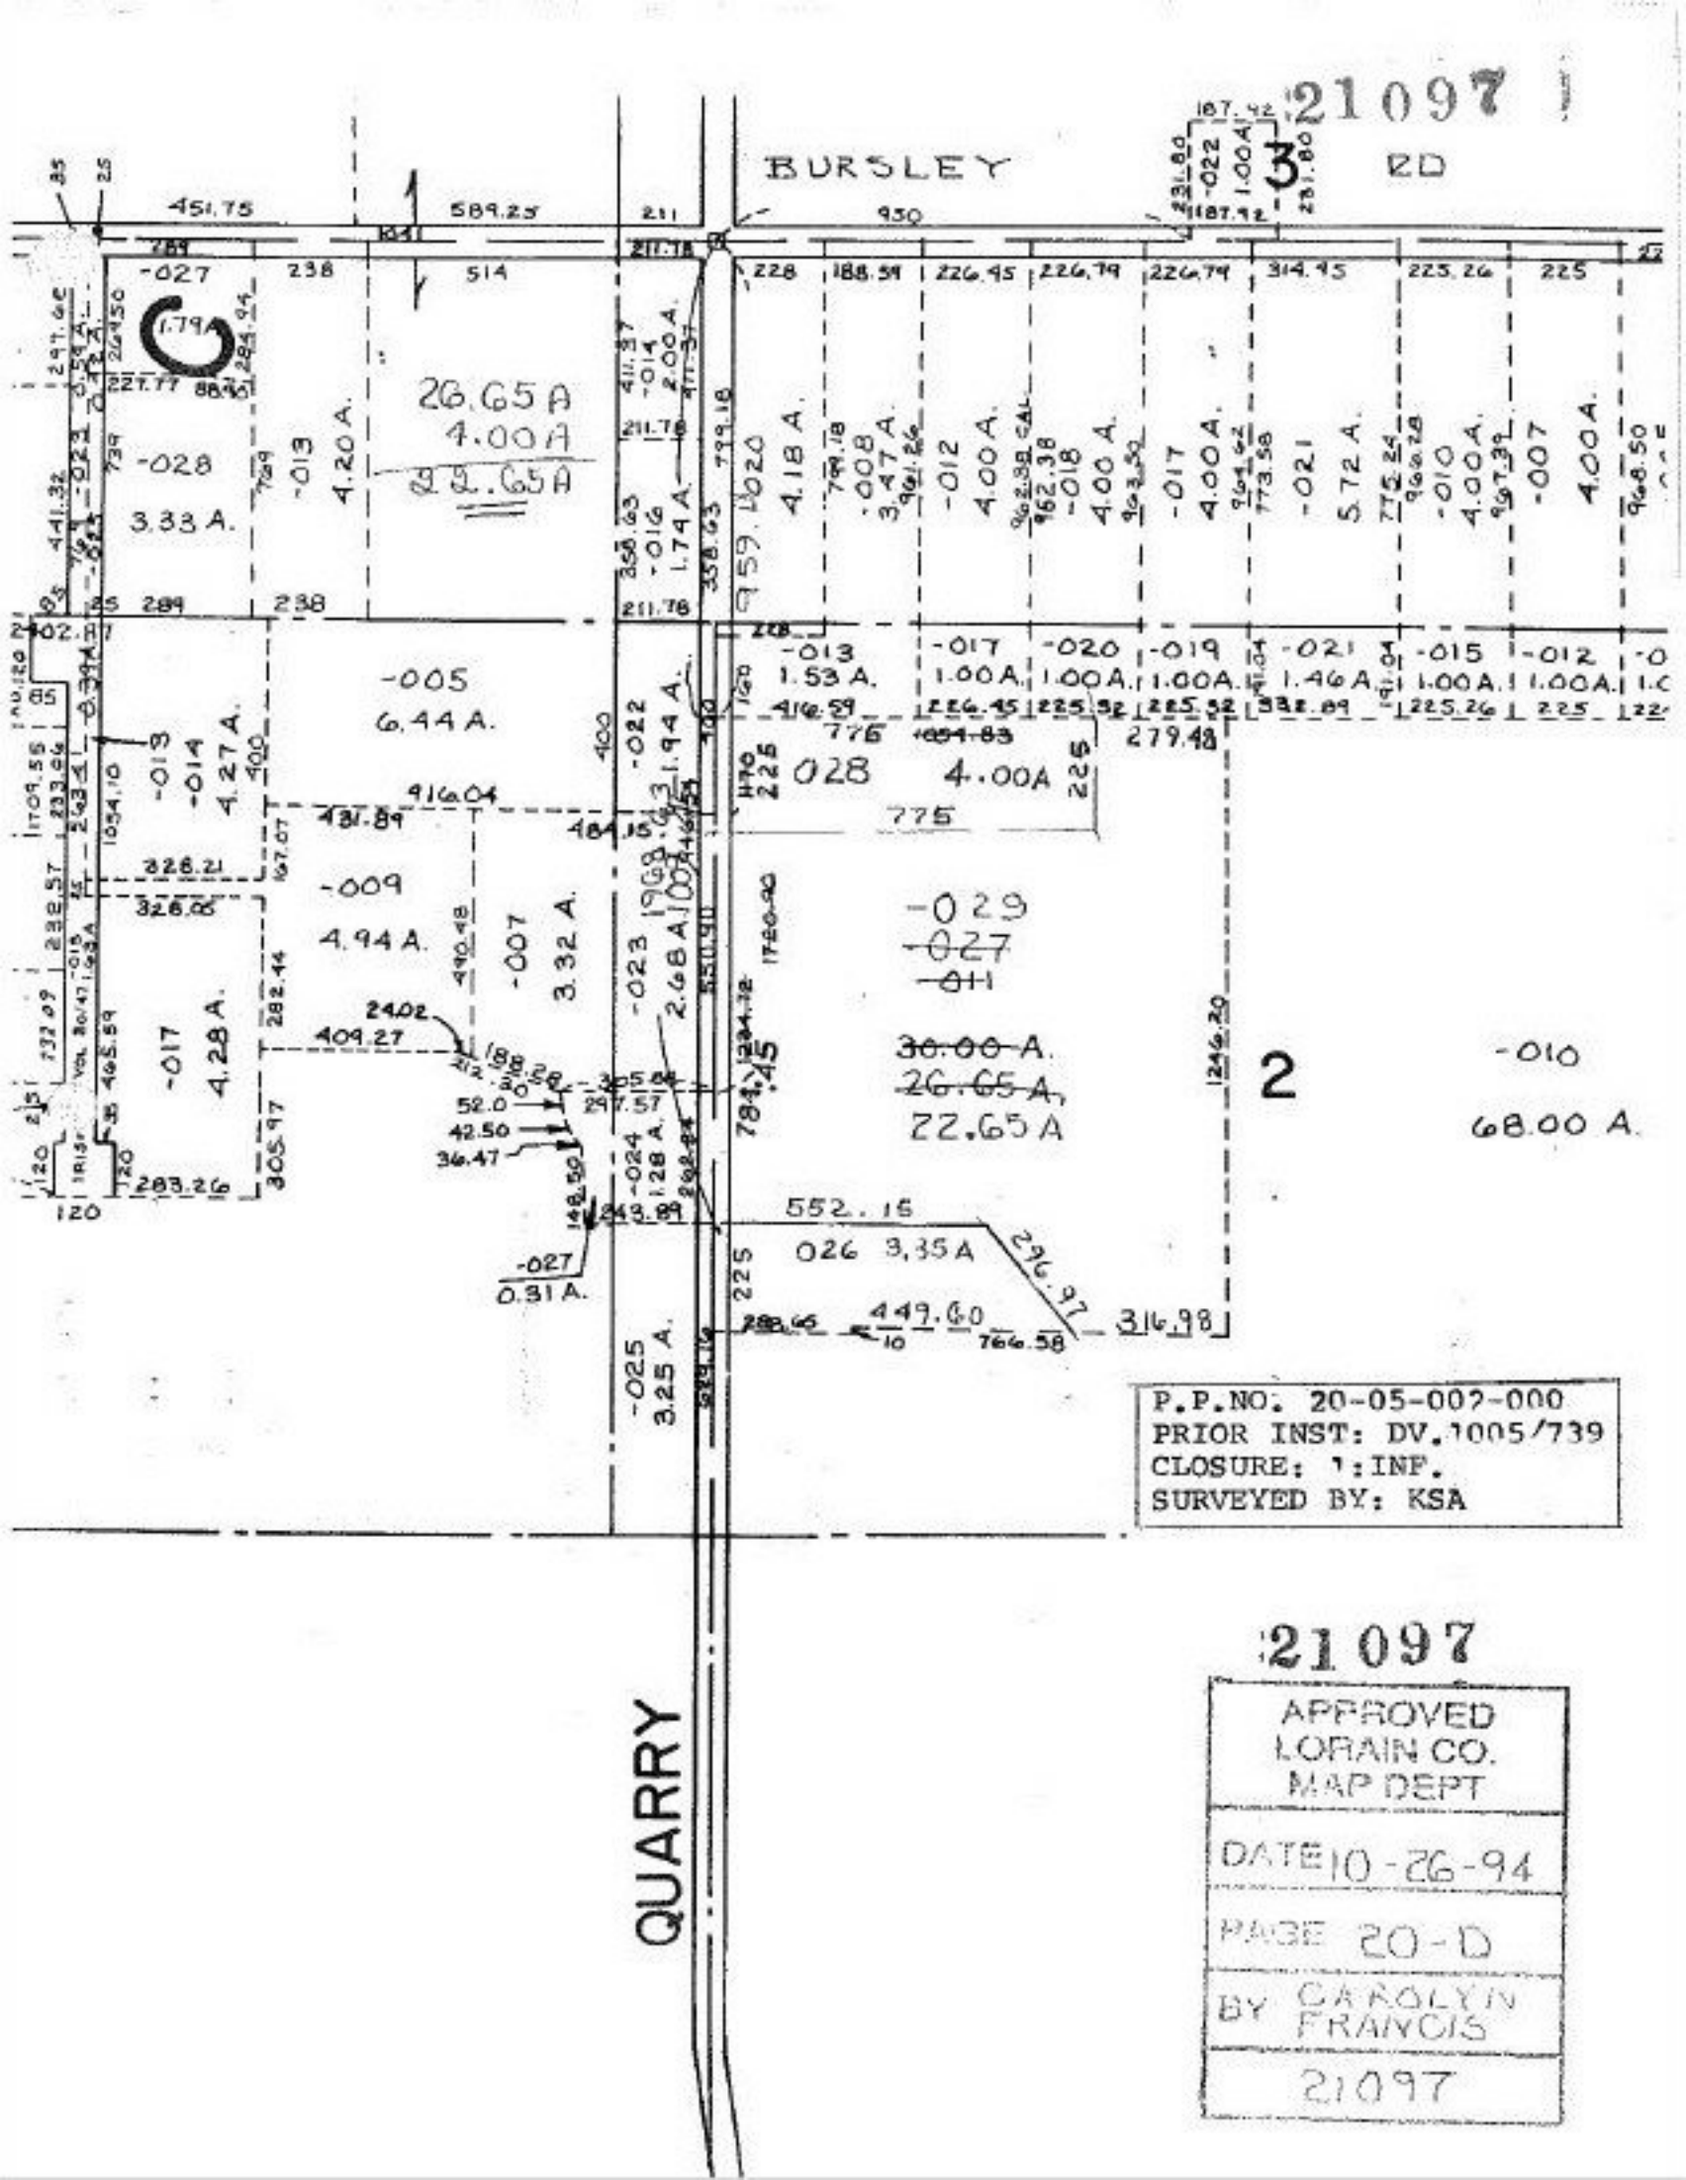
21097
BURSLEY RD
QUARRY
P.P.NO. 20-05-002-000
PRIOR INST: DV.1005/739
CLOSURE: 1:INF.
SURVEYED BY: KSA
21097
APPROVED
LORAIN CO.
MAP DEPT
DATE 10-26-94
PAGE 20-D
BY CAROLYN FRANCIS
21097