21098

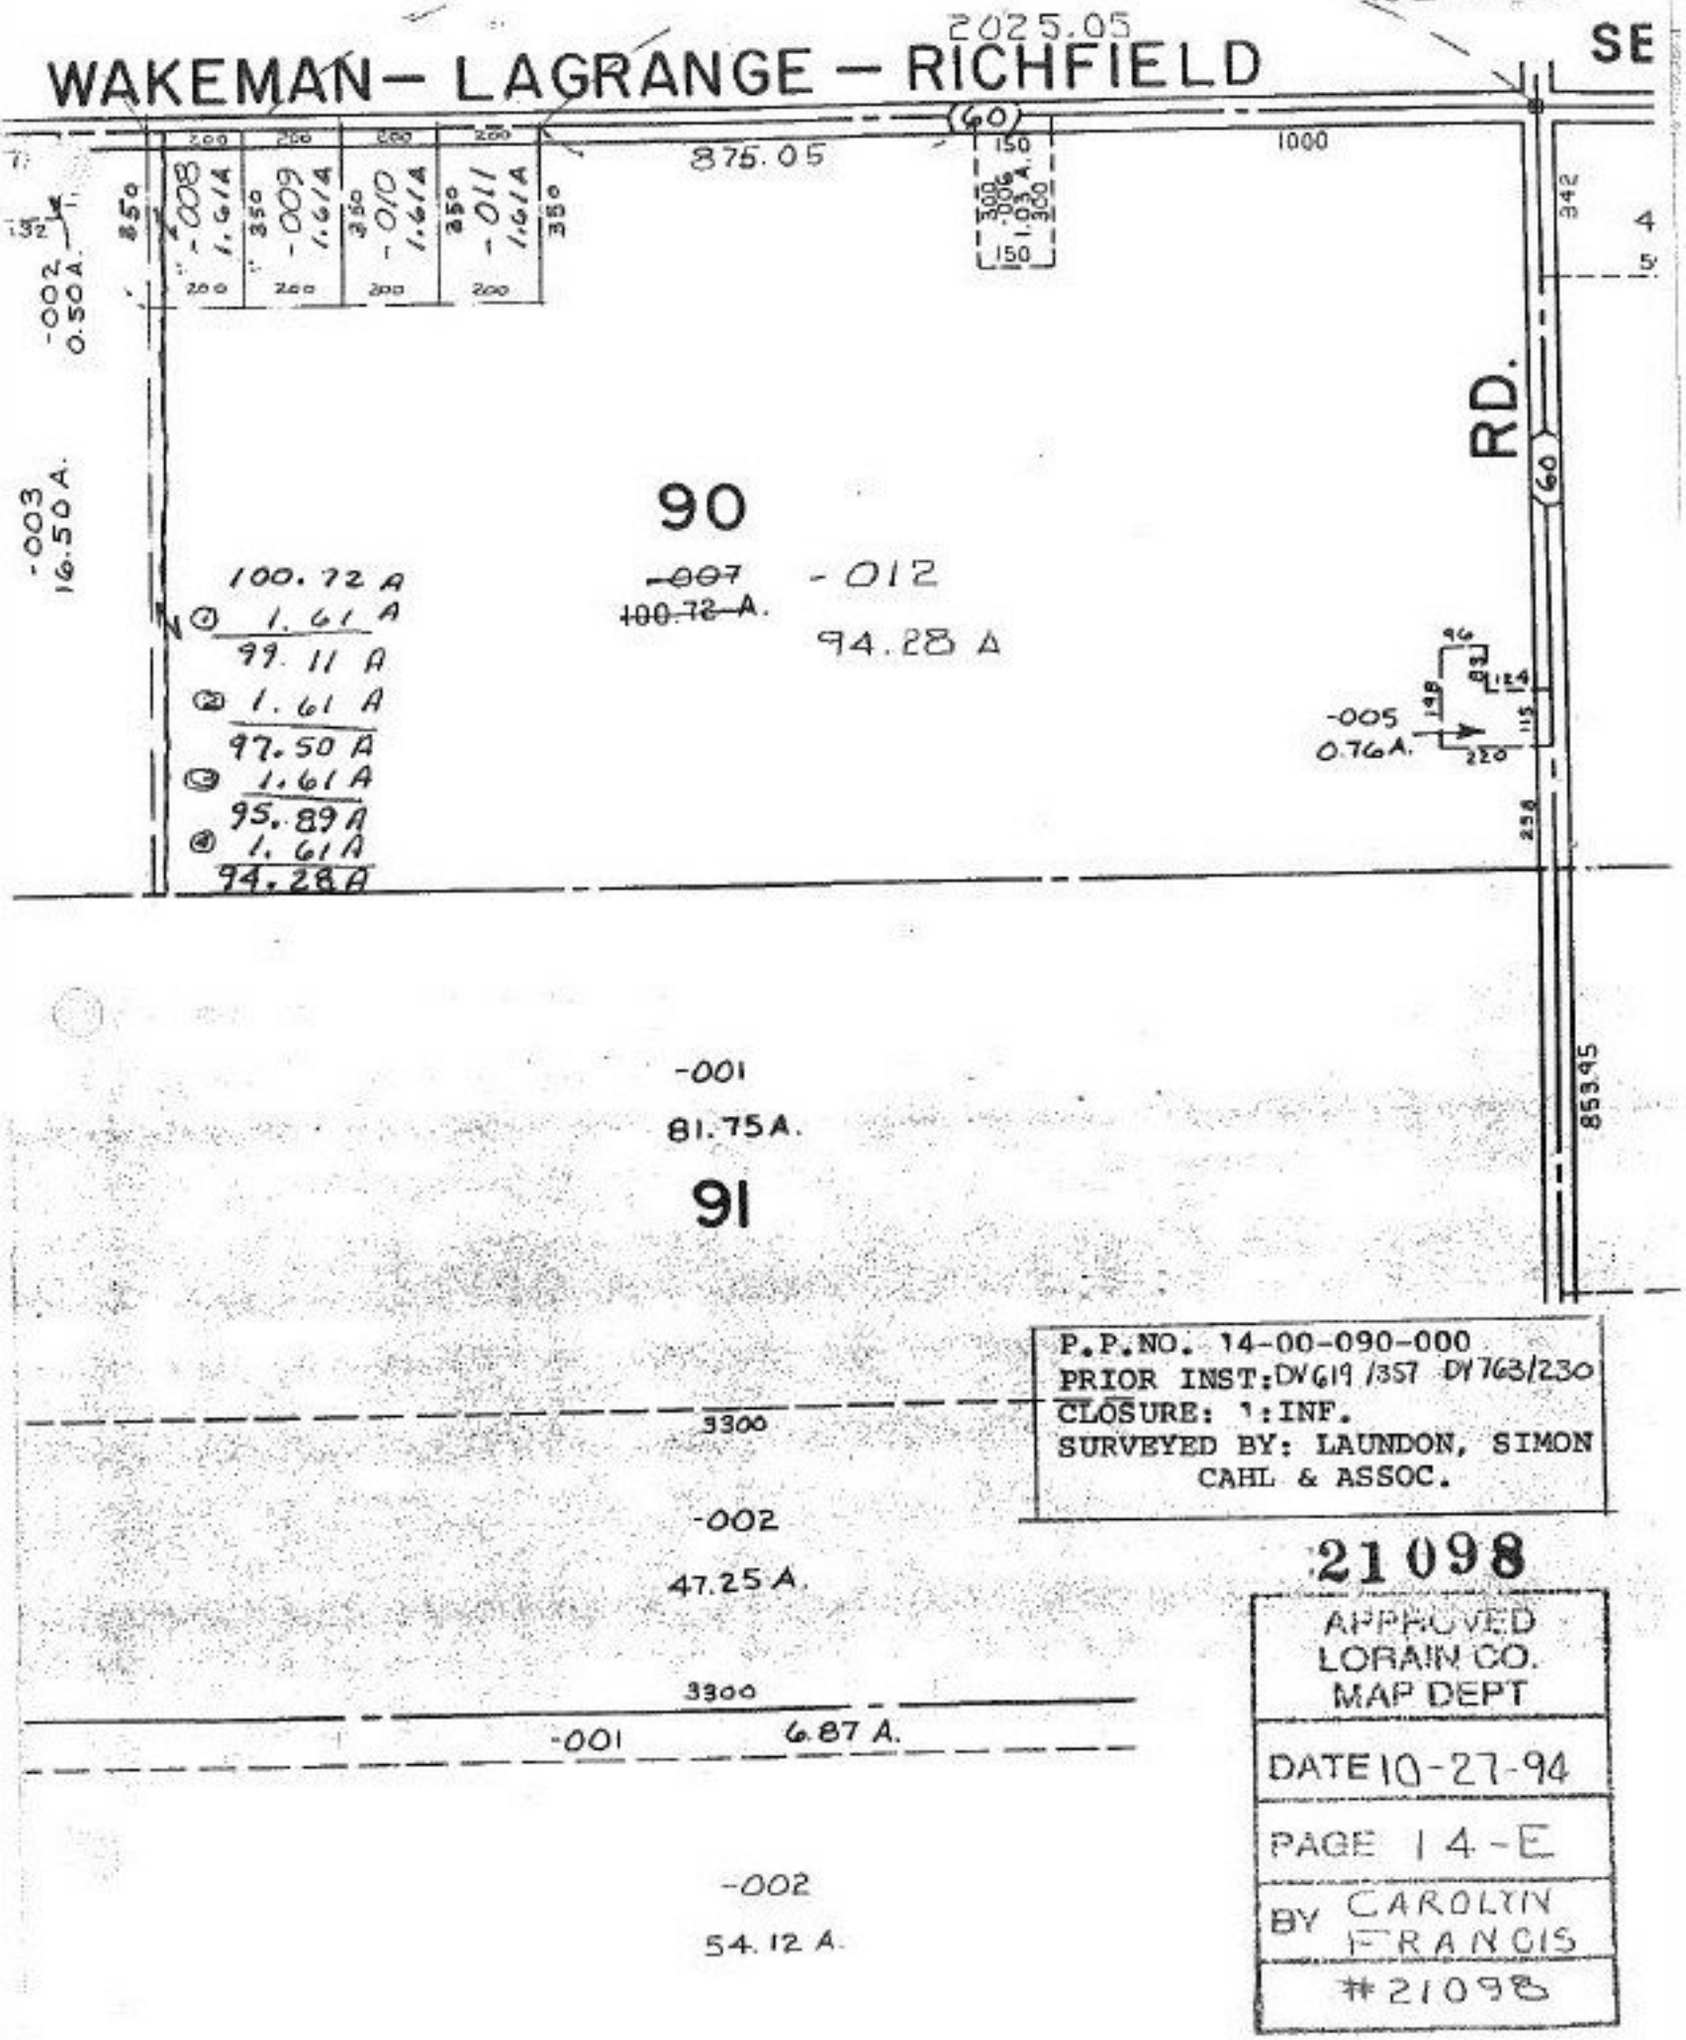


P.P.NO. 14-00-090-000
PRIOR INST: DV619/357 DV763/230
CLOSURE: 1:INF.
SURVEYED BY: LAUNDON, SIMON CAHL & ASSOC.

21098

APPROVED
LORAIN CO.
MAP DEPT

DATE 10-27-94

PAGE 14-E

BY CAROLYN FRANCIS

#21098