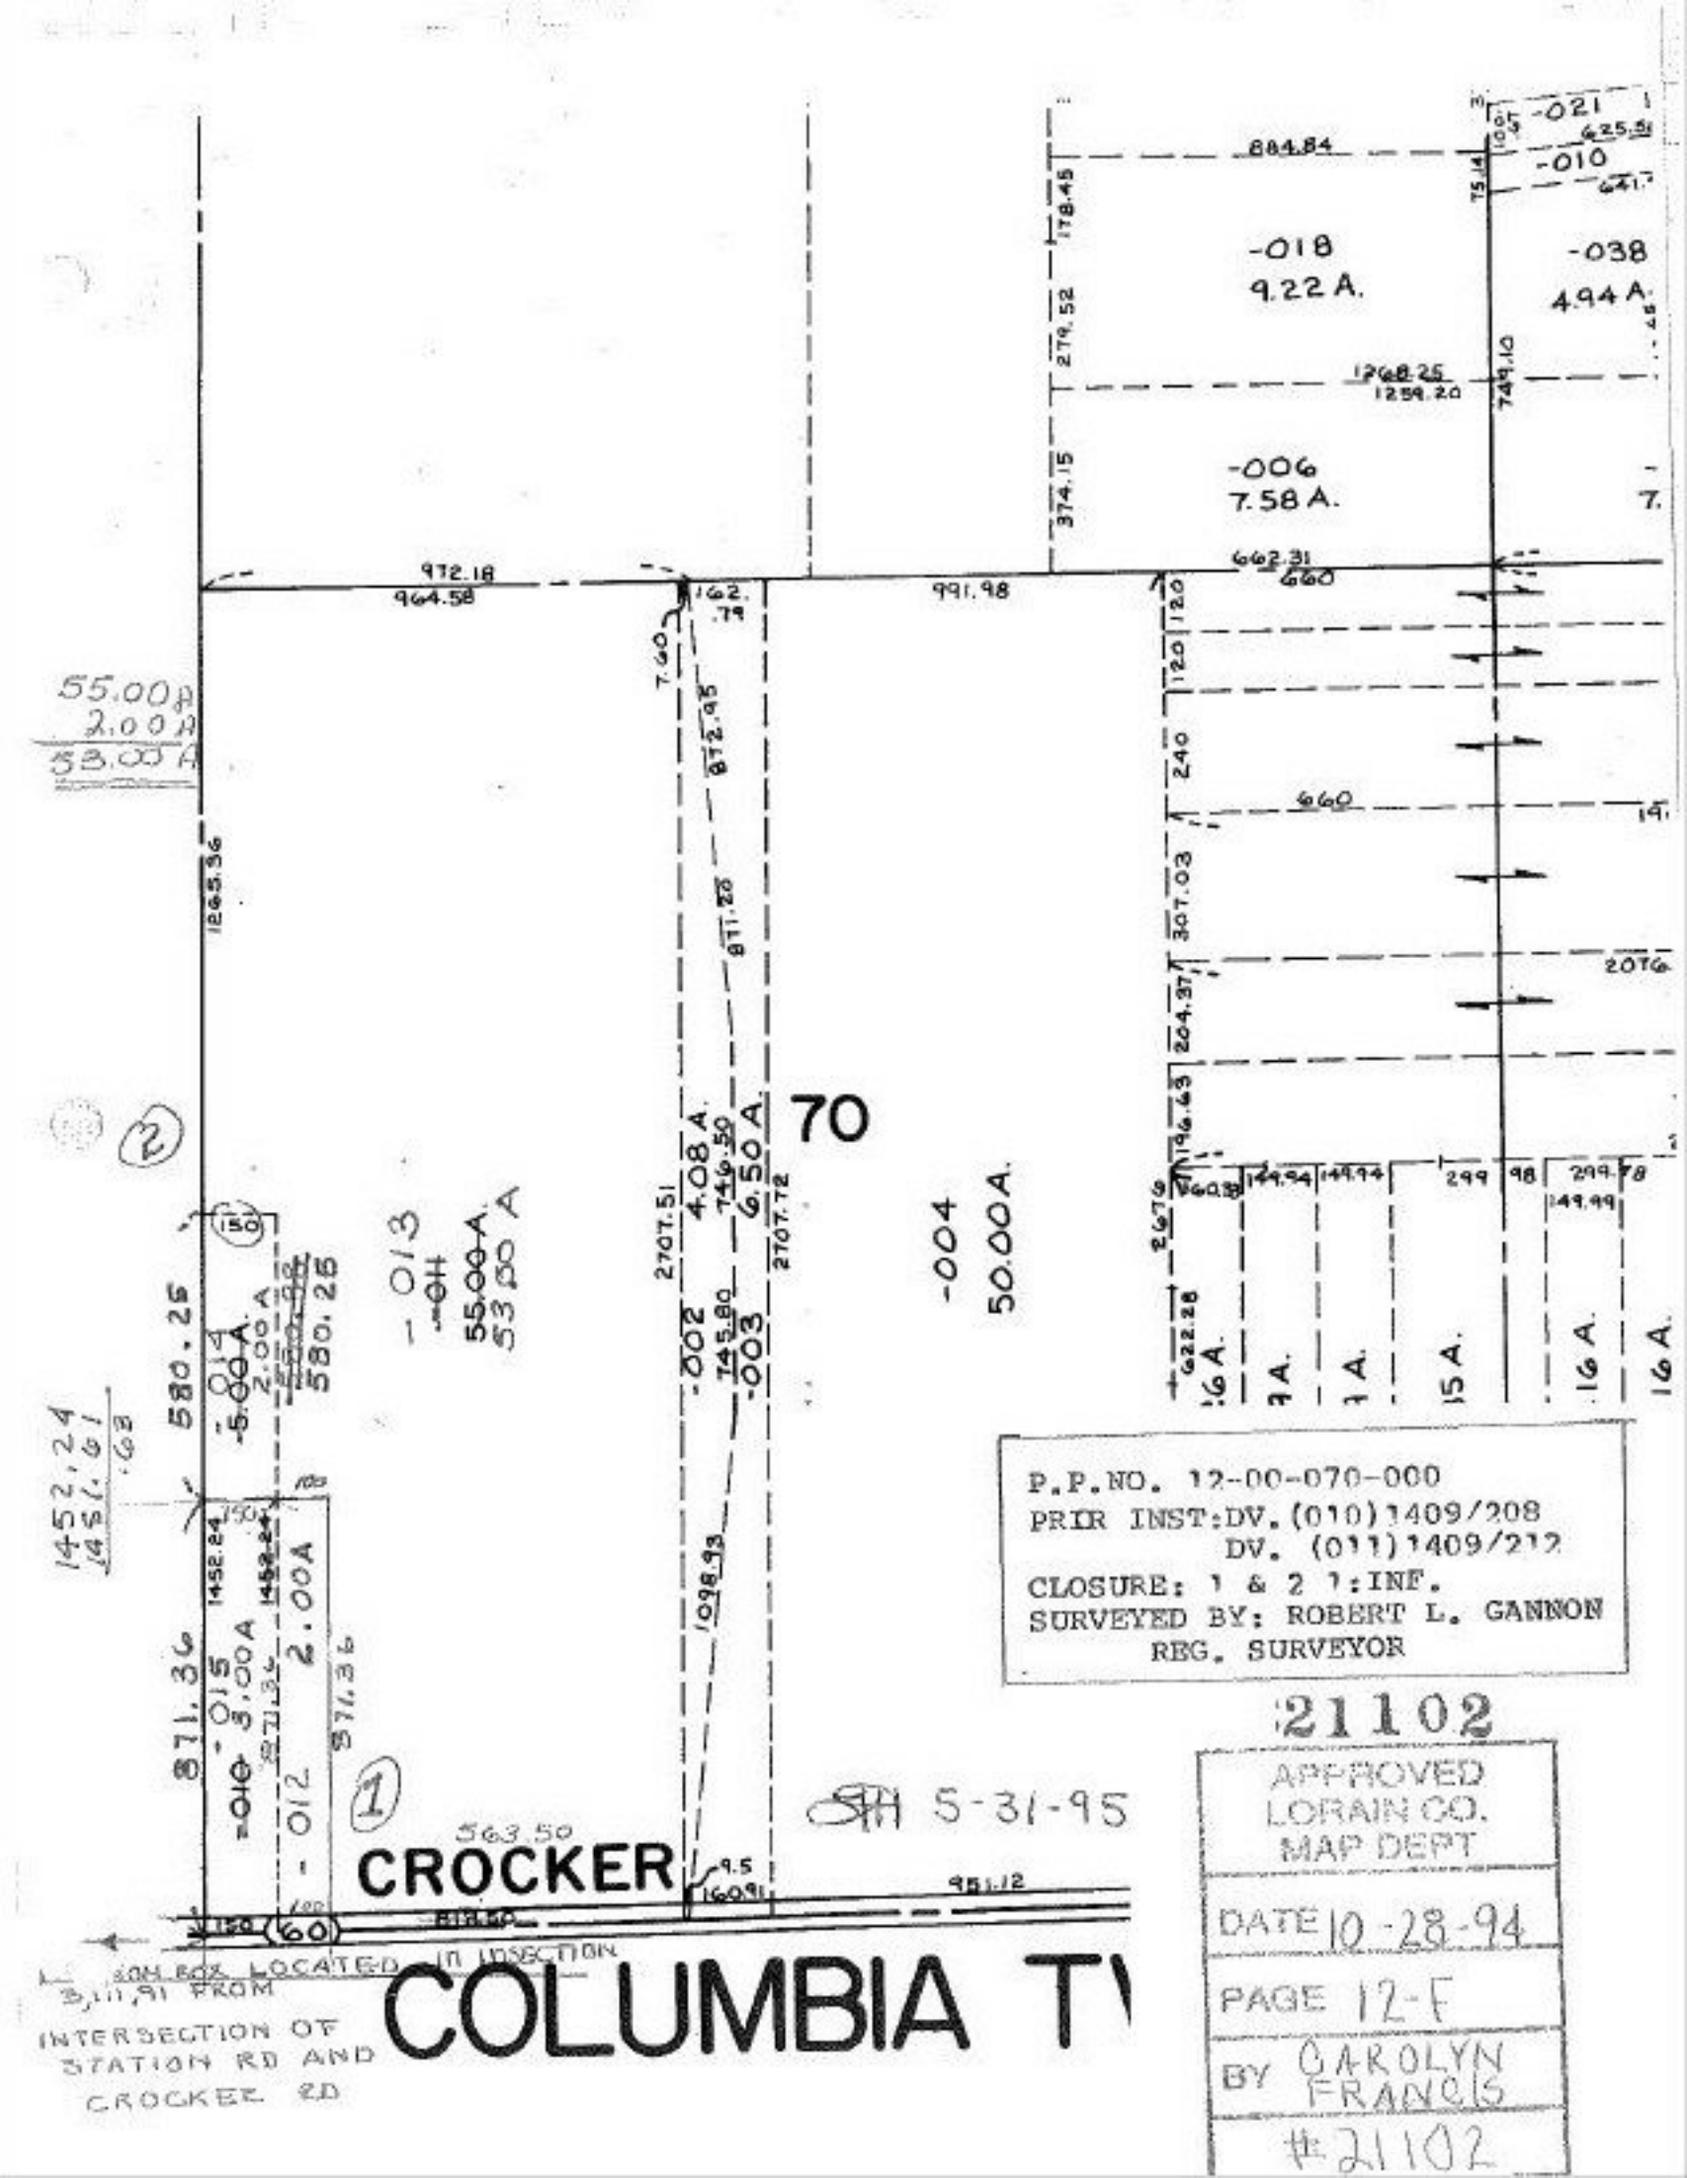

P.P.NO. 12-00-070-000
PRIR INST:DV.(010)1409/208
DV. (011)1409/212
CLOSURE: 1 & 2 1:INF.
SURVEYED BY: ROBERT L. GANNON
REG. SURVEYOR

21102

APPROVED
LORAIN CO.
MAP DEPT

DATE 10-28-94

PAGE 12-F

BY CAROLYN FRANCIS

#21102