21104

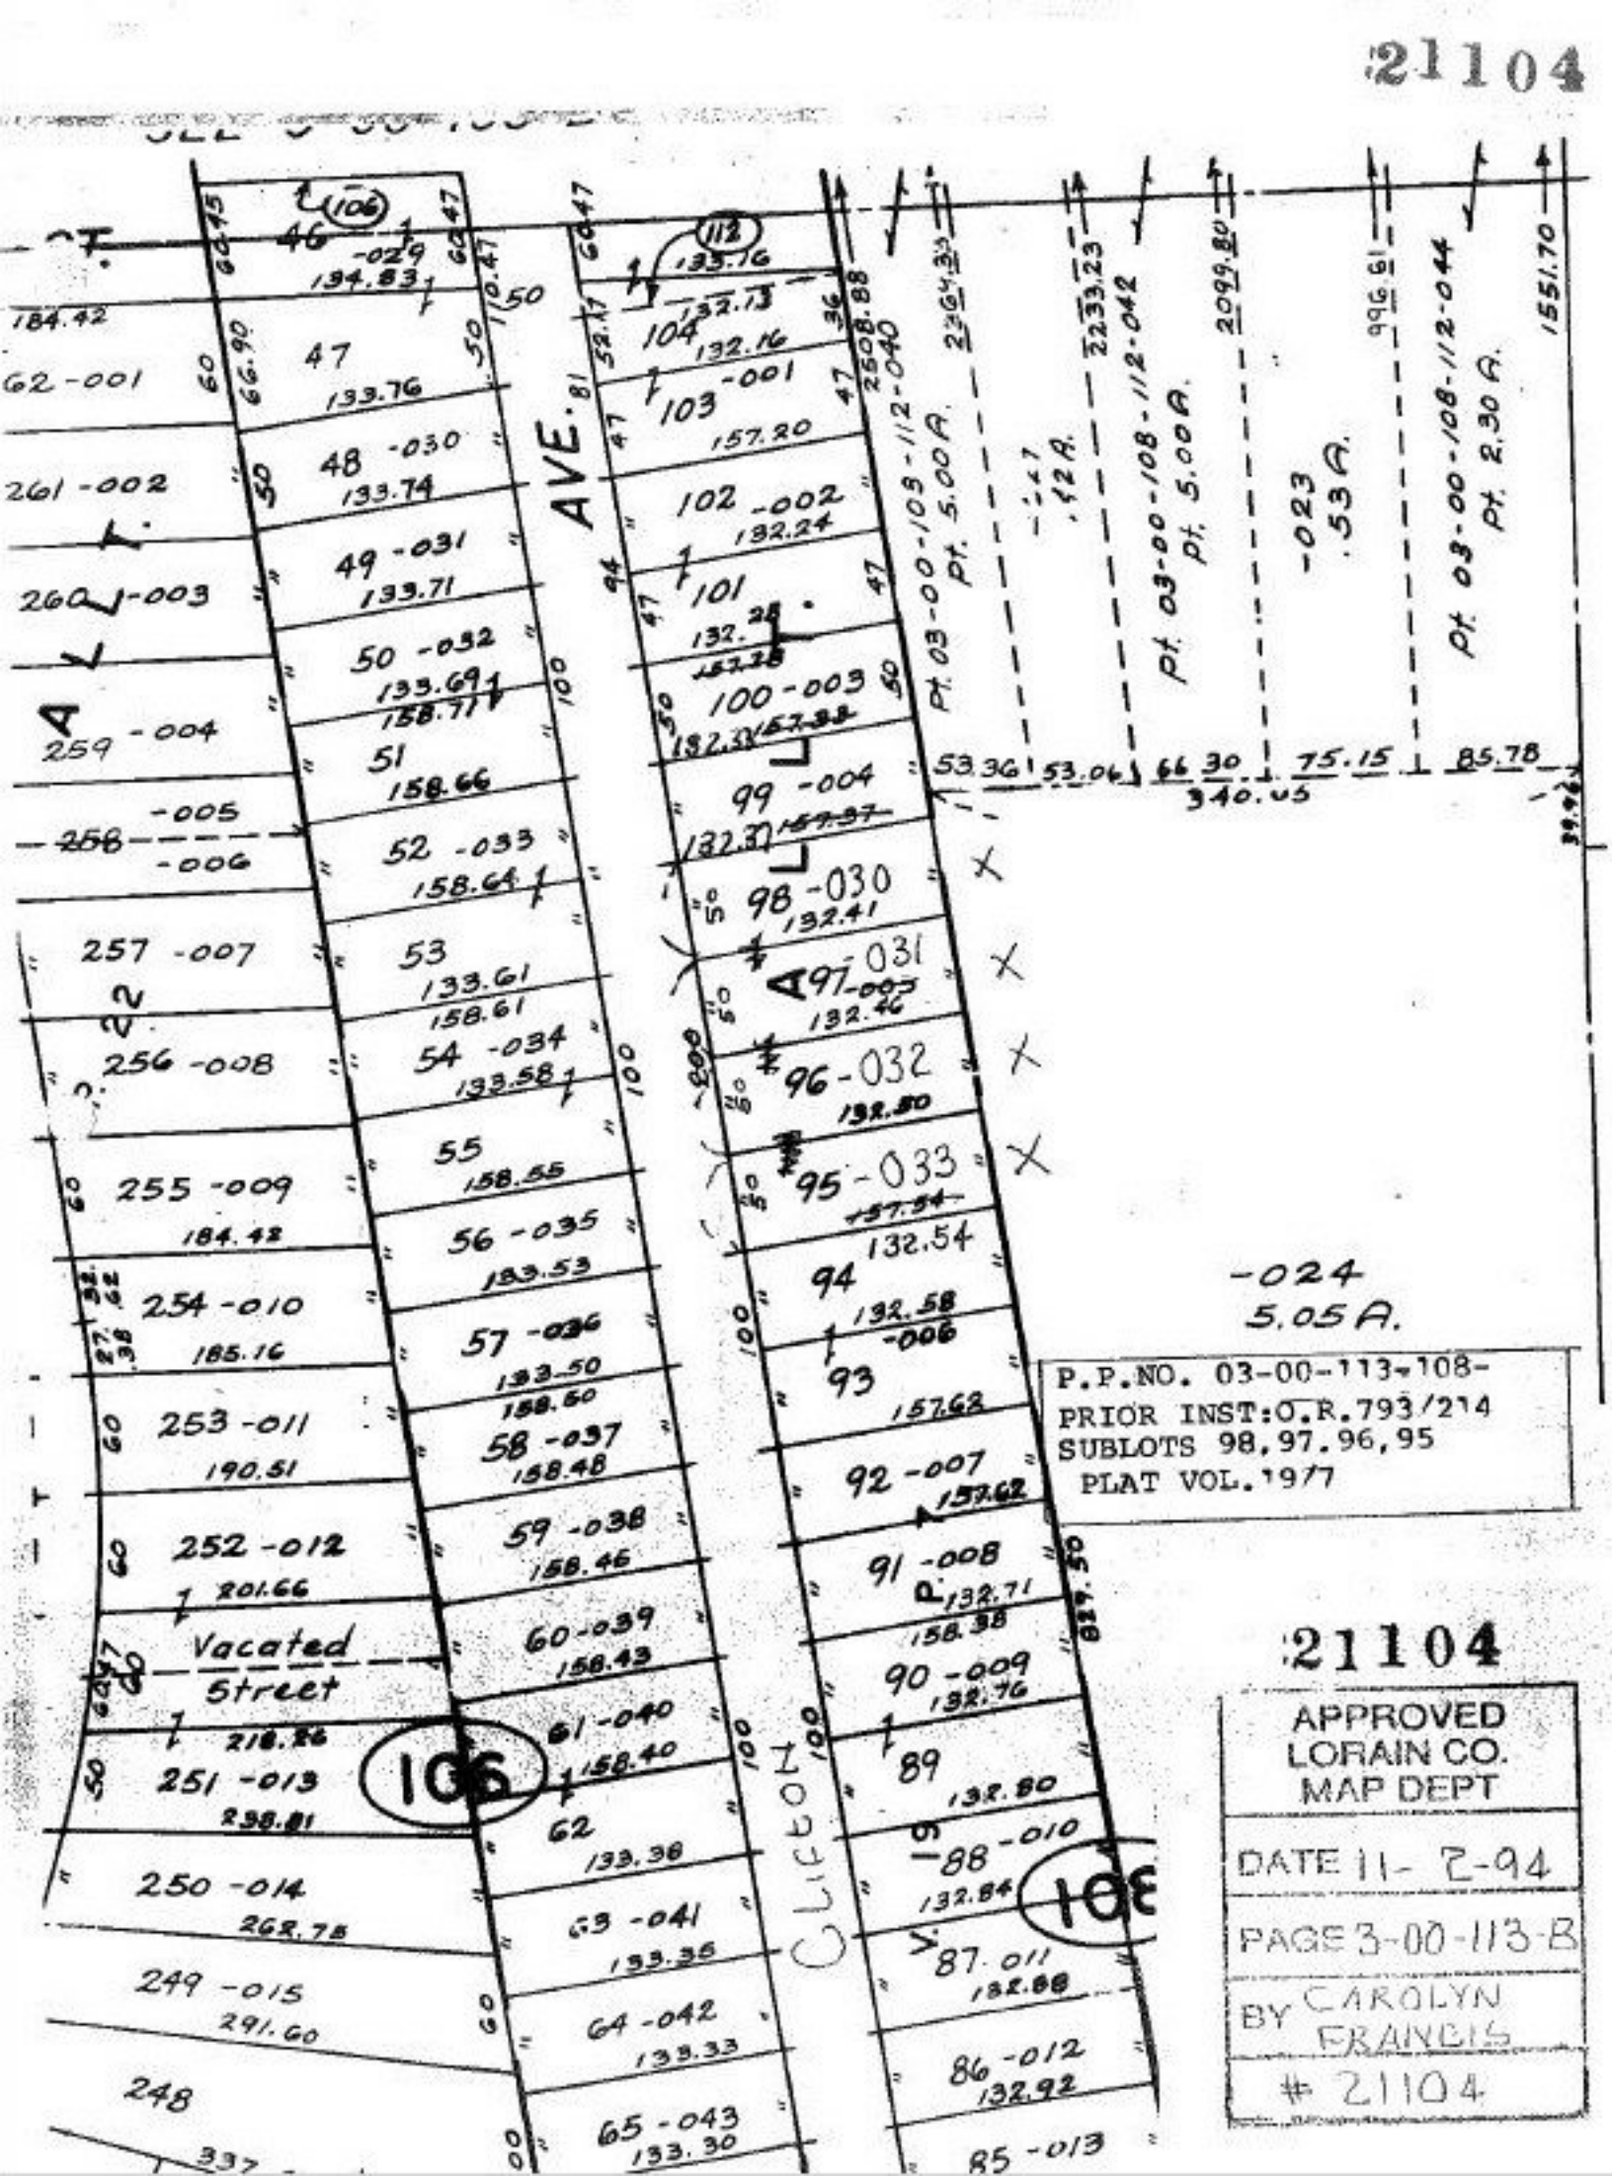

P.P.NO. 03-00-113-108-
PRIOR INST: O.R. 793/214
SUBLOTS 98, 97, 96, 95
PLAT VOL. 1977

21104

APPROVED
LORAIN CO.
MAP DEPT

DATE 11-2-94

PAGE 3-00-113-B

BY CAROLYN FRANCIS

21104