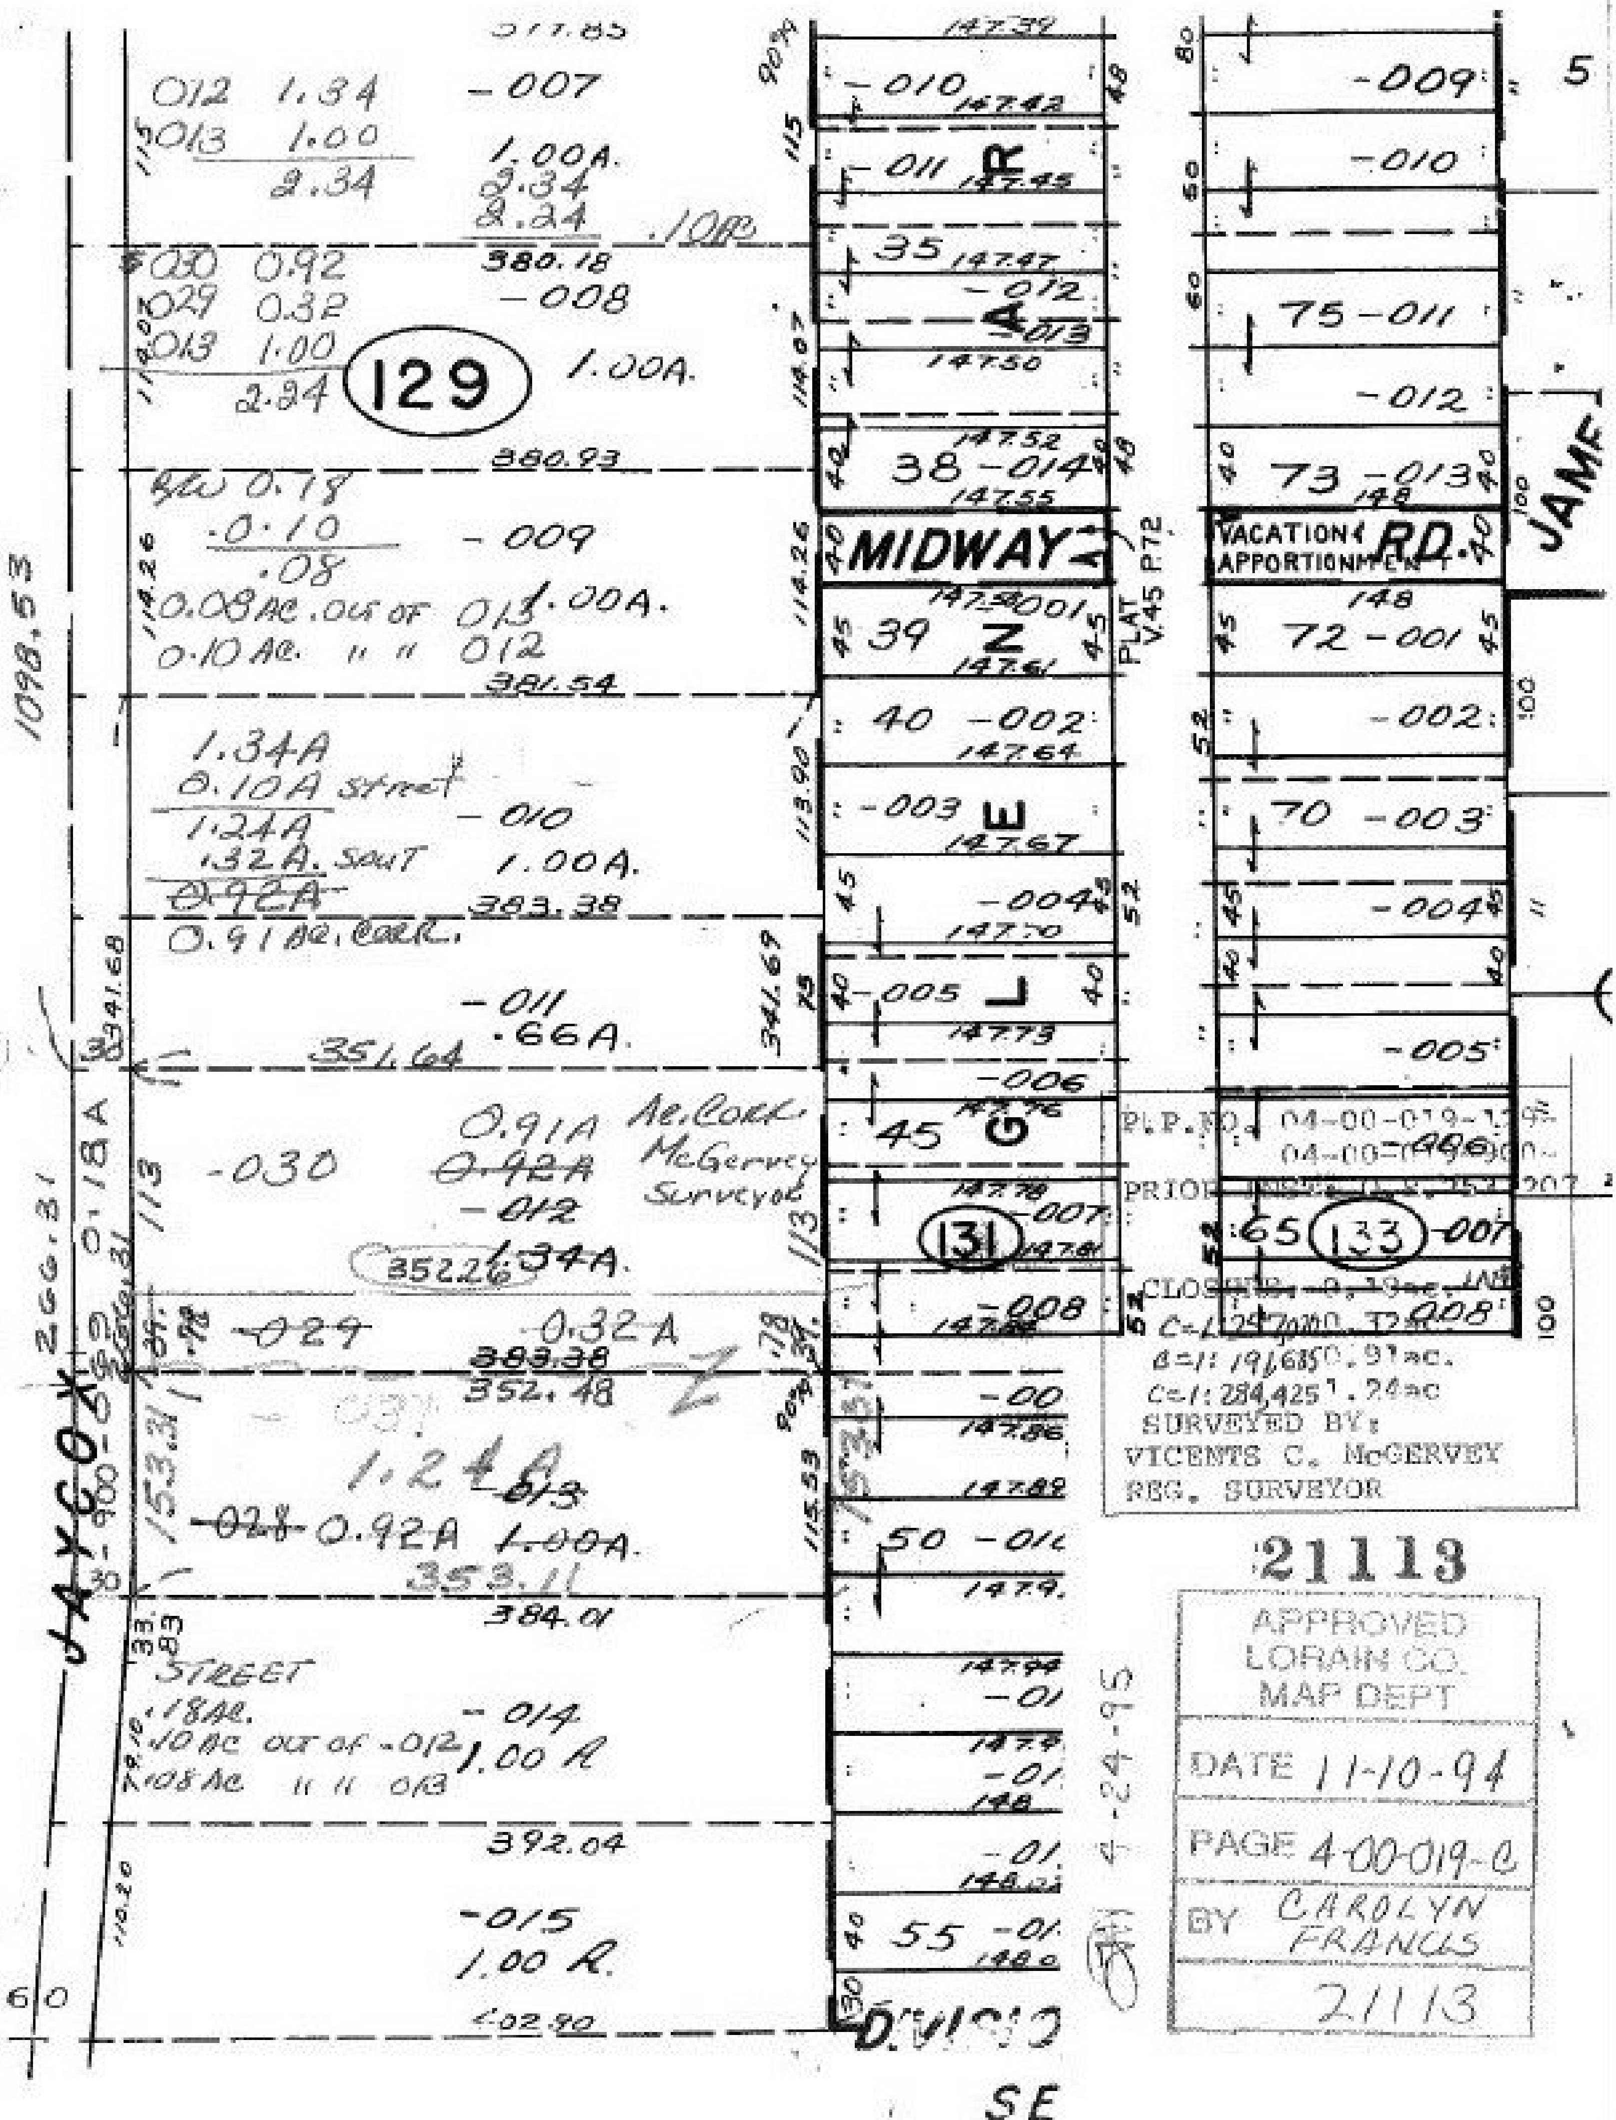

129
131
133
MIDWAY AV
RD.
VACATION APPORTIONMENT
PLAT V.45 P72
JAYCOX
JAME
DIVISIO
SE
1098.53
380.18
380.93
381.54
383.38
351.64
352.26
383.38
352.48
353.11
384.01
392.04
402.90
1.00A.
0.91A Ac. Corr McGervey Surveyor
0.92A
1.34A
0.32A
1.24A
0.08 AC. OUT OF 013
0.10 AC. " " 012
STREET
P.P. NO. 04-00-019-129
PRIOR INST.
CLOSURE
SURVEYED BY:
VICENTS C. McGERVEY
REG. SURVEYOR
21113
APPROVED
LORAIN CO.
MAP DEPT
DATE 11-10-94
PAGE 4-00-019-C
BY CAROLYN FRANCIS
21113
4-24-95