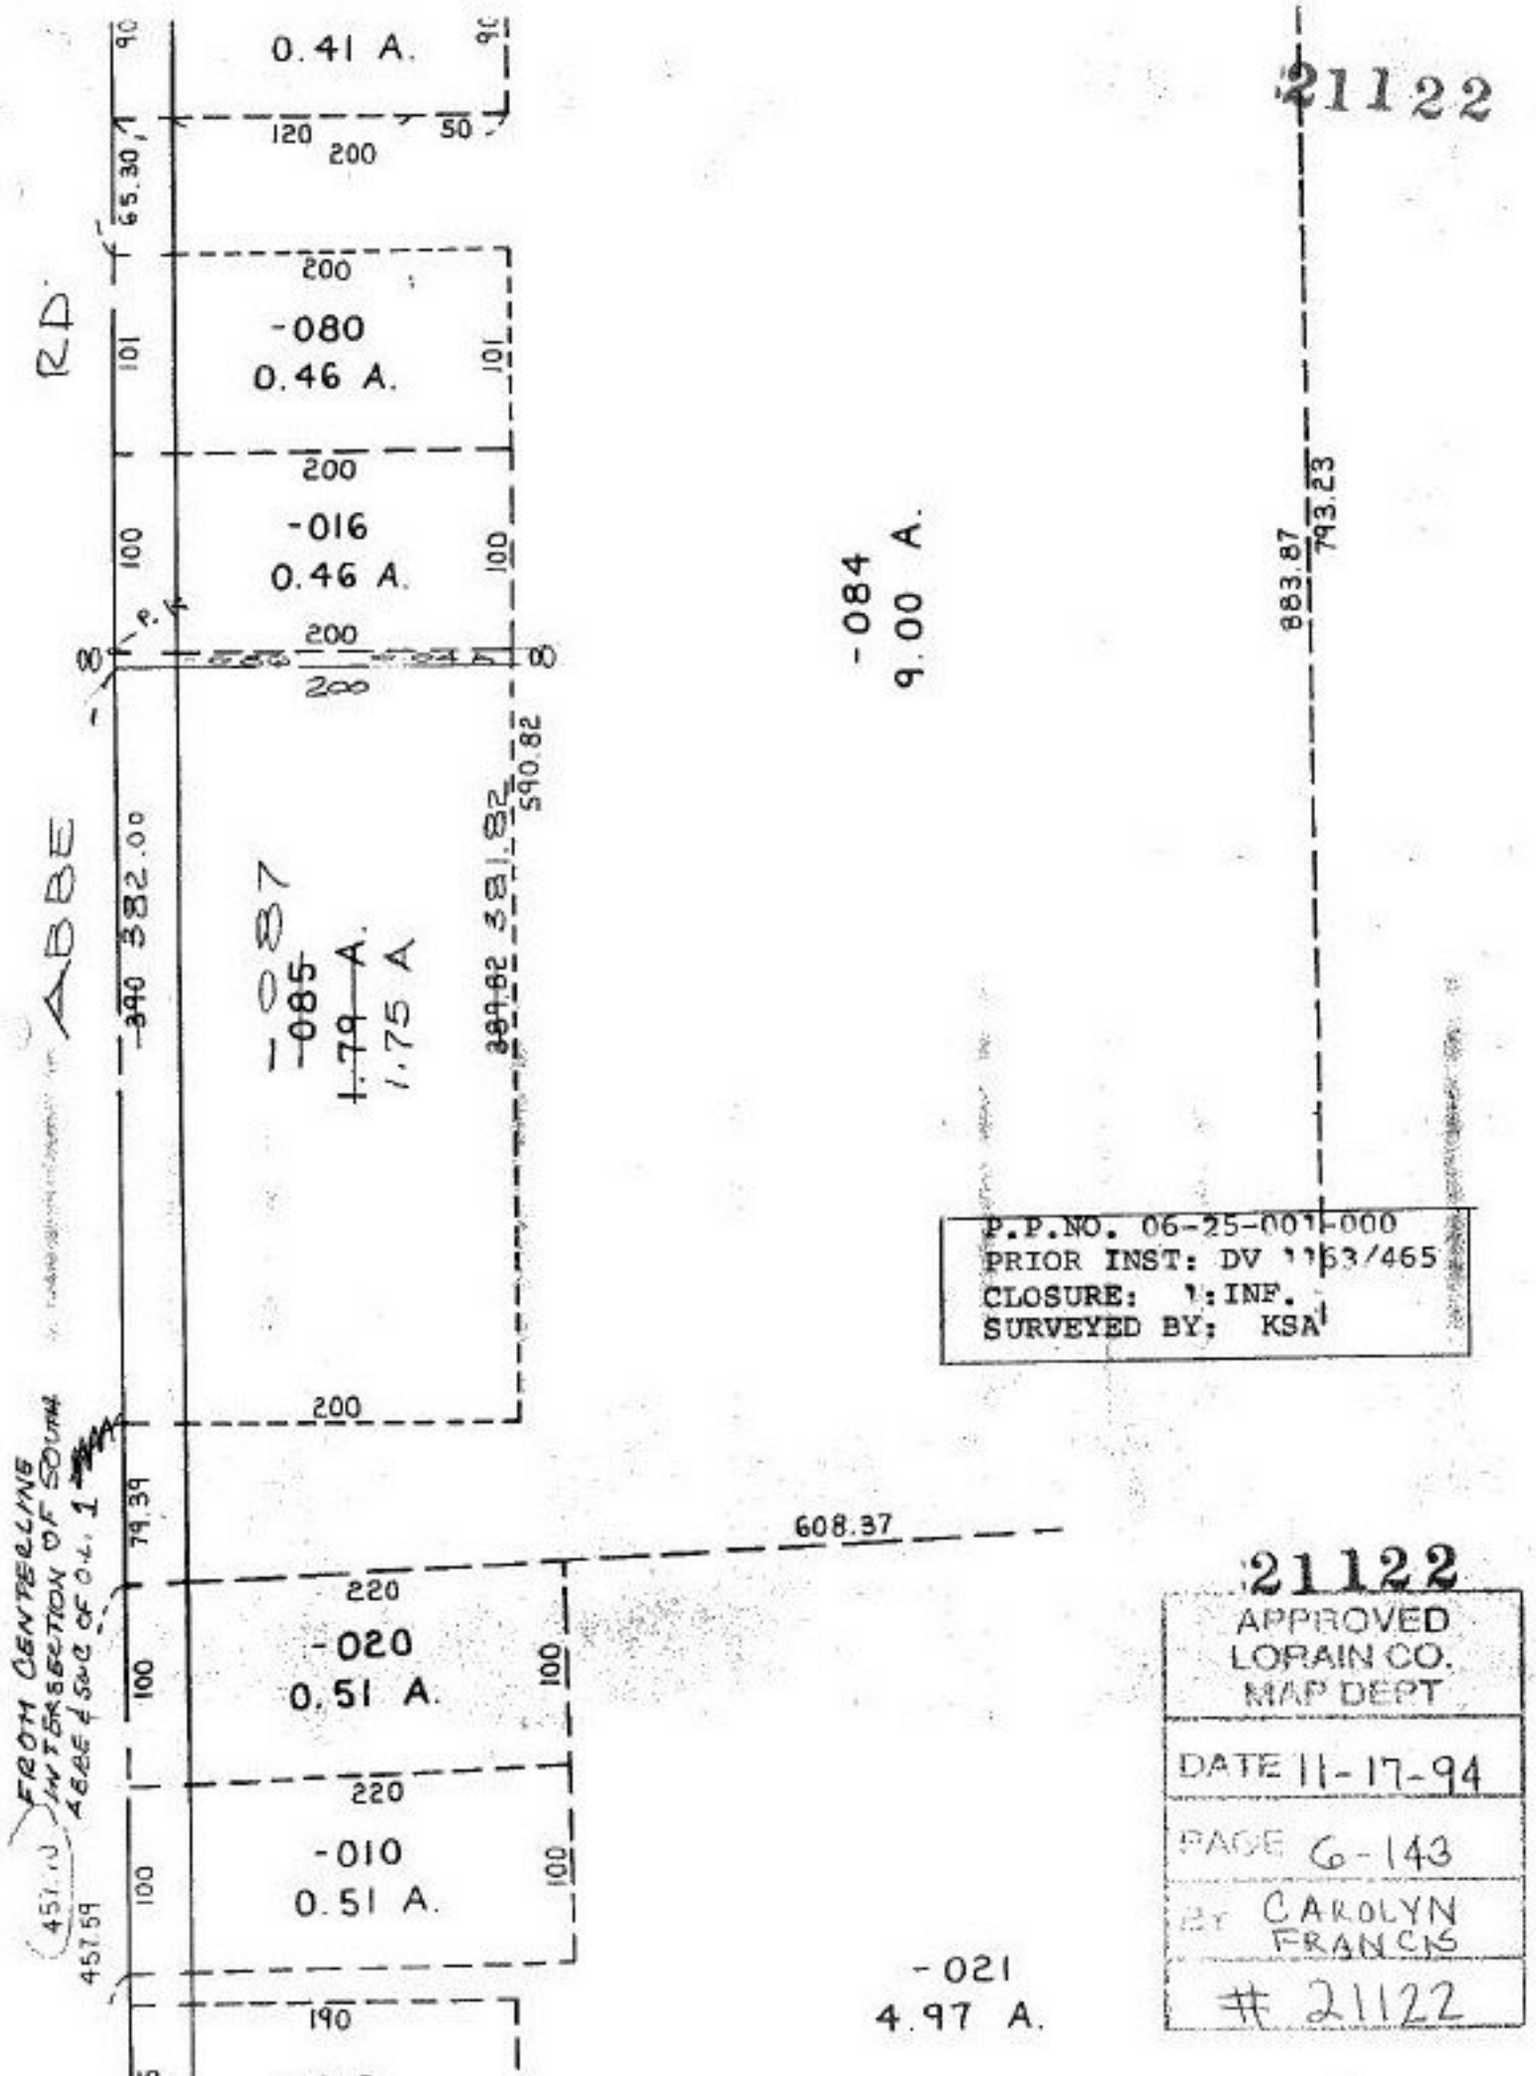
21122
0.41 A.
RD.
ABBE
-080
0.46 A.
-016
0.46 A.
-084
9.00 A.
-087
-085
1.79 A.
1.75 A
-020
0.51 A.
-010
0.51 A.
-021
4.97 A.
883.87
793.23
590.82
381.82
382.00
608.37
457.59
FROM CENTERLINE INTERSECTION OF SOUTH ABBE & SWC OF O.L. 1
P.P.NO. 06-25-001-000
PRIOR INST: DV 1163/465
CLOSURE: 1:INF.
SURVEYED BY: KSA
21122
APPROVED
LORAIN CO.
MAP DEPT
DATE 11-17-94
PAGE 6-143
BY CAROLYN FRANCIS
21122