


SEE 11-CJ-100-A

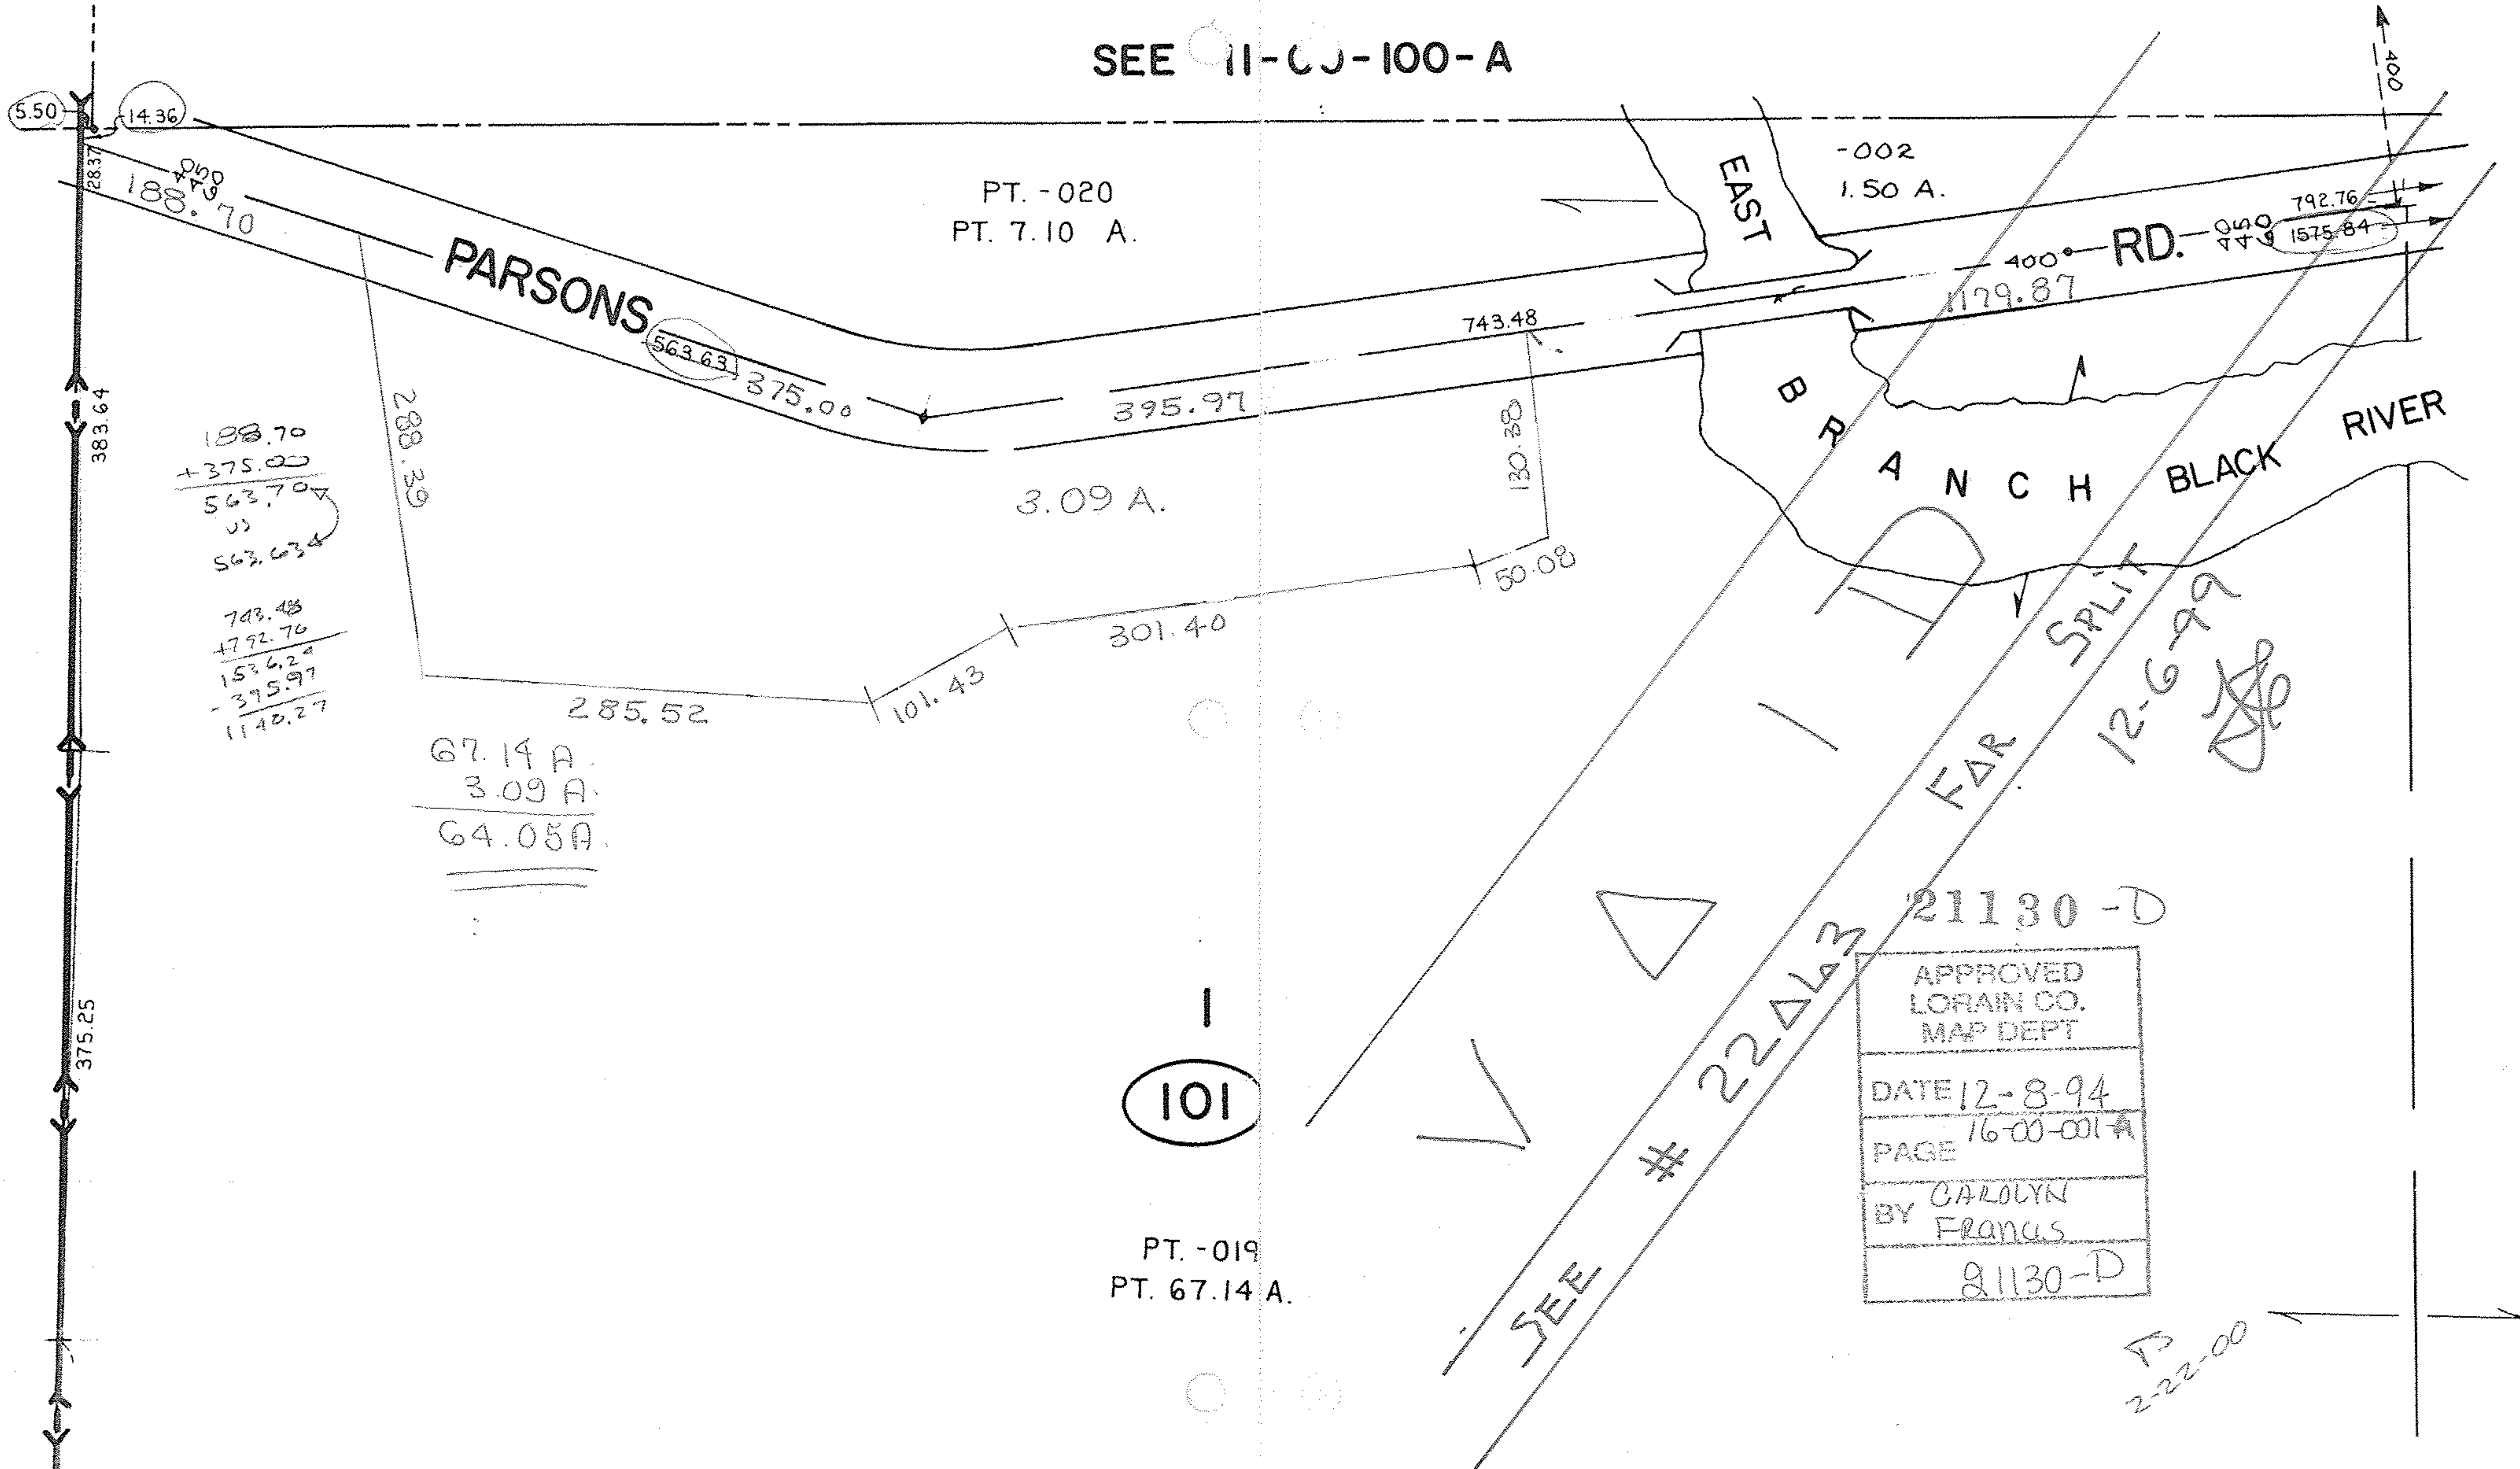

$$\begin{array}{r} 188.70 \\ + 375.00 \\ \hline 563.70 \\ \text{or} \\ 563.634 \end{array}$$

$$\begin{array}{r} 743.48 \\ + 792.76 \\ \hline 1536.24 \\ - 395.97 \\ \hline 1140.27 \end{array}$$

67.14 A.
 3.09 A.

 64.05 A.

-002
1.50 A.

PT. -020
PT. 7.10 A.

3.09 A.

PT. -019
PT. 67.14 A.

101

RD. 400

EAST

B
R
A
N
C
H

BLACK RIVER

FAR SPLIT

12-6-99

21130-D

APPROVED LORAIN CO. MAP DEPT
DATE 12-8-94
PAGE 16-00-001 A
BY CAROLYN FRANCIS
21130-D

TS
2-22-00