21131

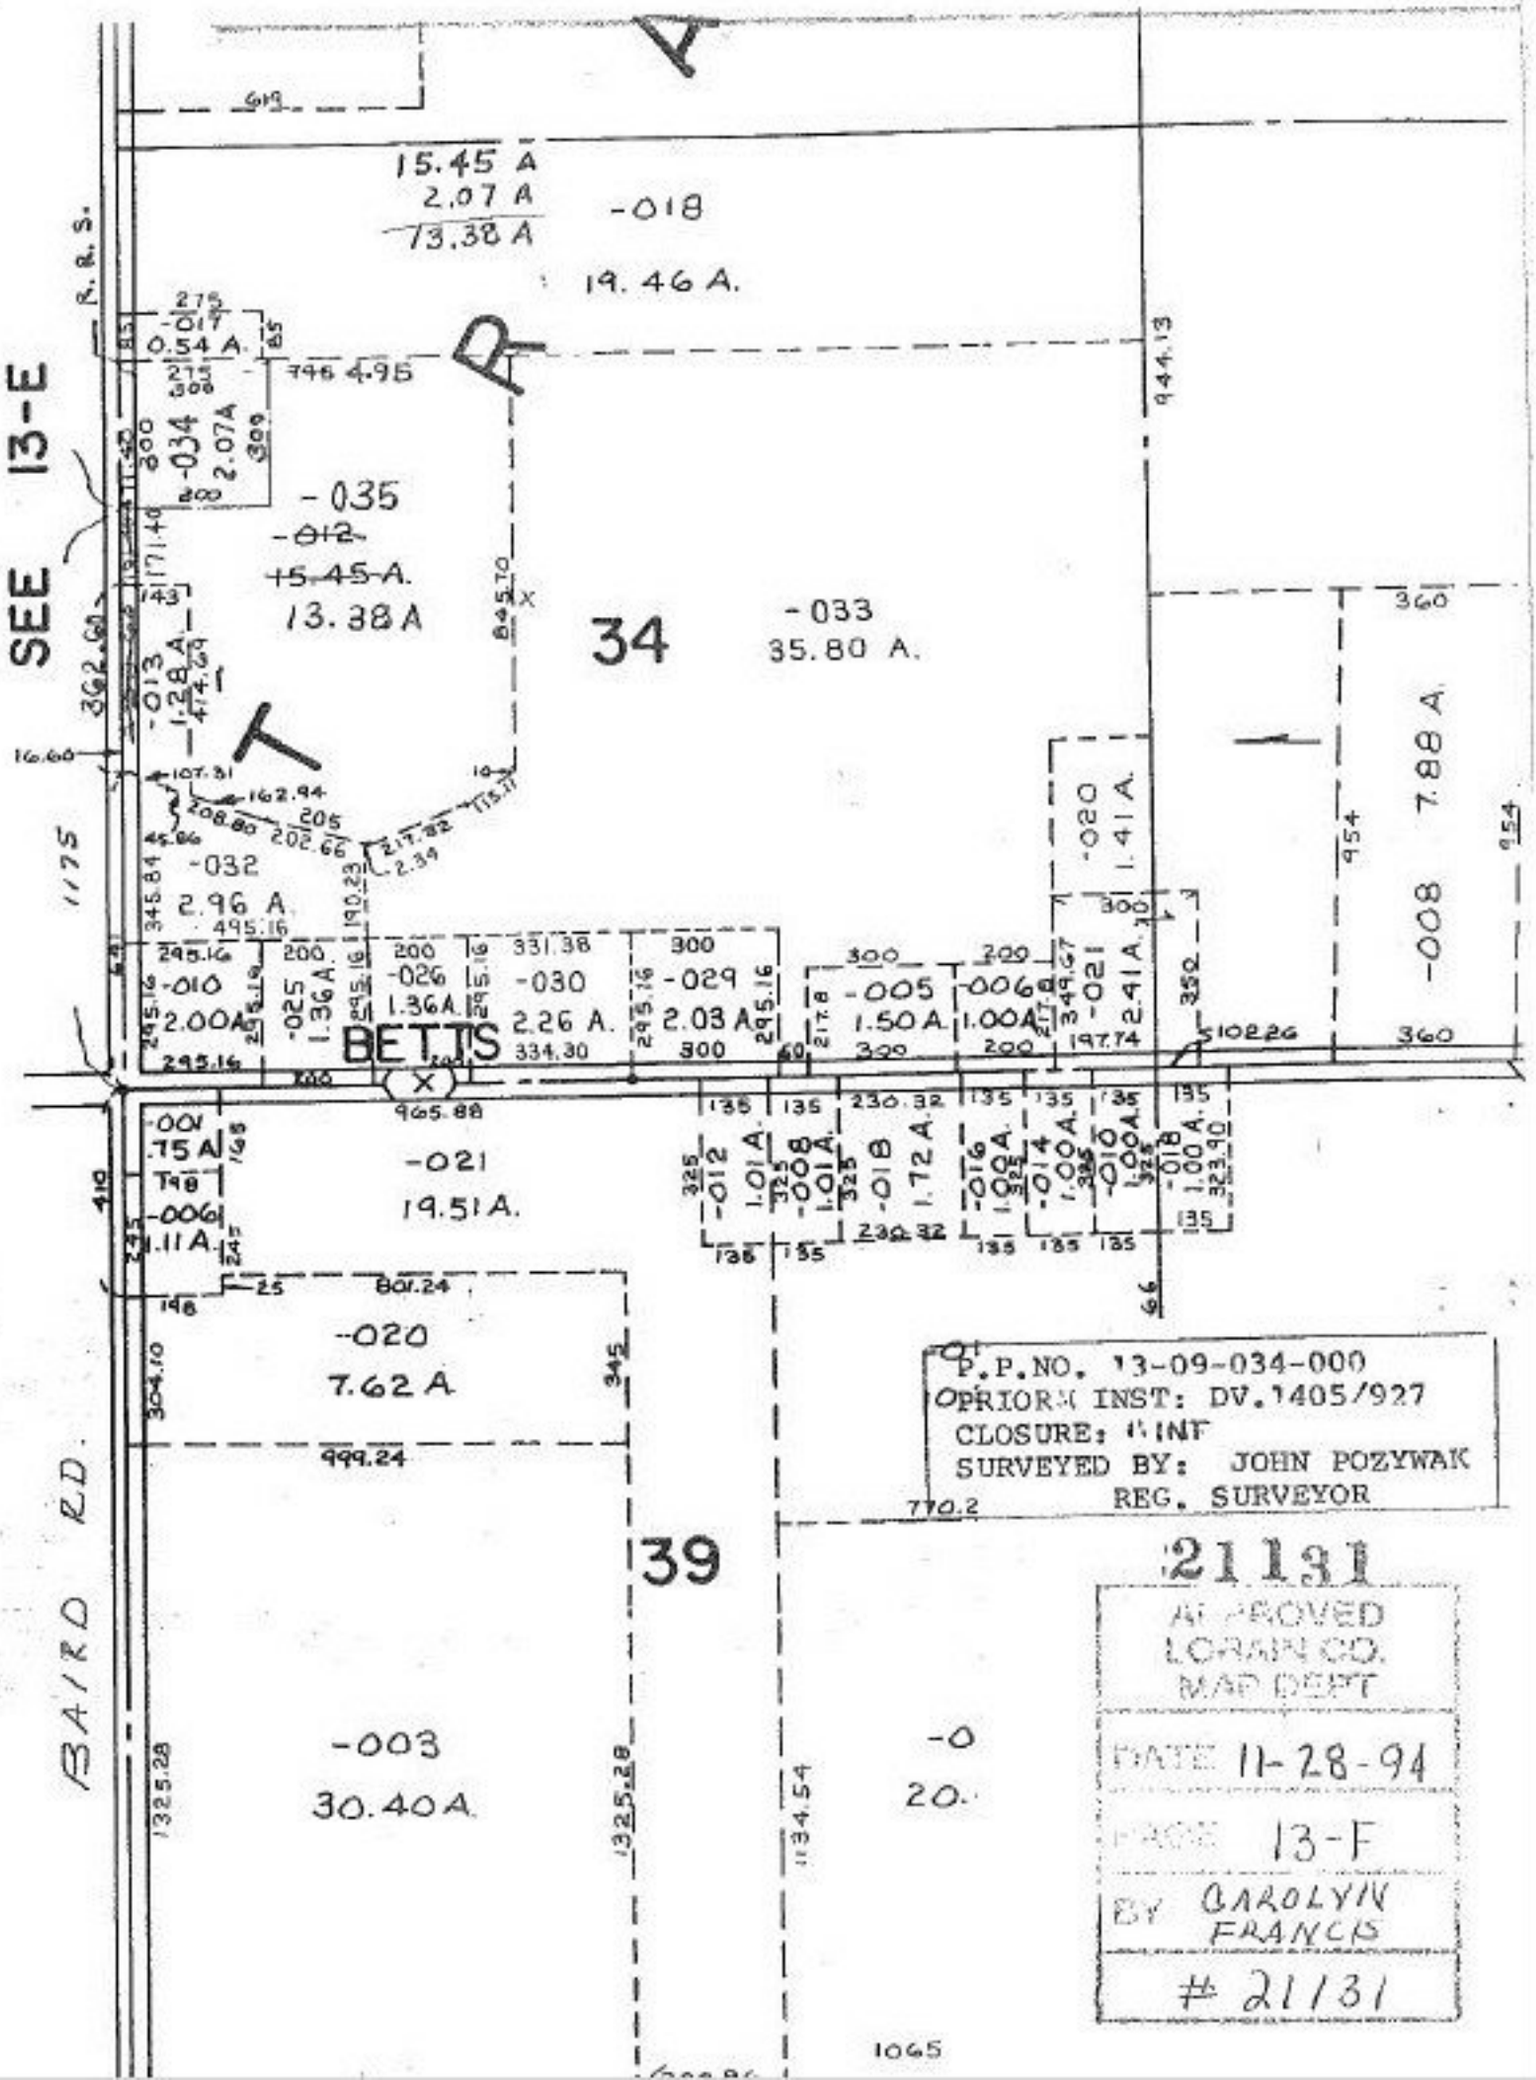
SEE 13-E
R. R. S.
15.45 A
2.07 A
13.38 A
-018
19.46 A.
0.54 A.
-034
2.07A
-035
-012-
15.45 A.
13.38 A
34
-033
35.80 A.
-013
1.28 A.
-032
2.96 A
-010
2.00A.
-025
1.36A.
-026
1.36A.
-030
2.26 A.
-029
2.03 A
-005
1.50 A.
-006
1.00A.
-020
1.41 A.
-021
2.41 A.
-008
7.88 A.
BETTIS
-001
.75 A
T48
-006
1.11 A.
-021
19.51A.
-020
7.62 A
-012
1.01 A.
-008
1.01A.
-018
1.72 A.
-016
1.00A.
-014
1.00A.
-010
1.00A.
-018
1.00 A.
BAIRD RD.
-003
30.40A.
-0
20.
39
P.P.NO. 13-09-034-000
PRIOR INST: DV.1405/927
CLOSURE: 1 INT
SURVEYED BY: JOHN POZYWAK
REG. SURVEYOR
21131
APPROVED
LORAIN CO.
MAP DEPT
DATE 11-28-94
PAGE 13-F
BY CAROLYN FRANCIS
21131