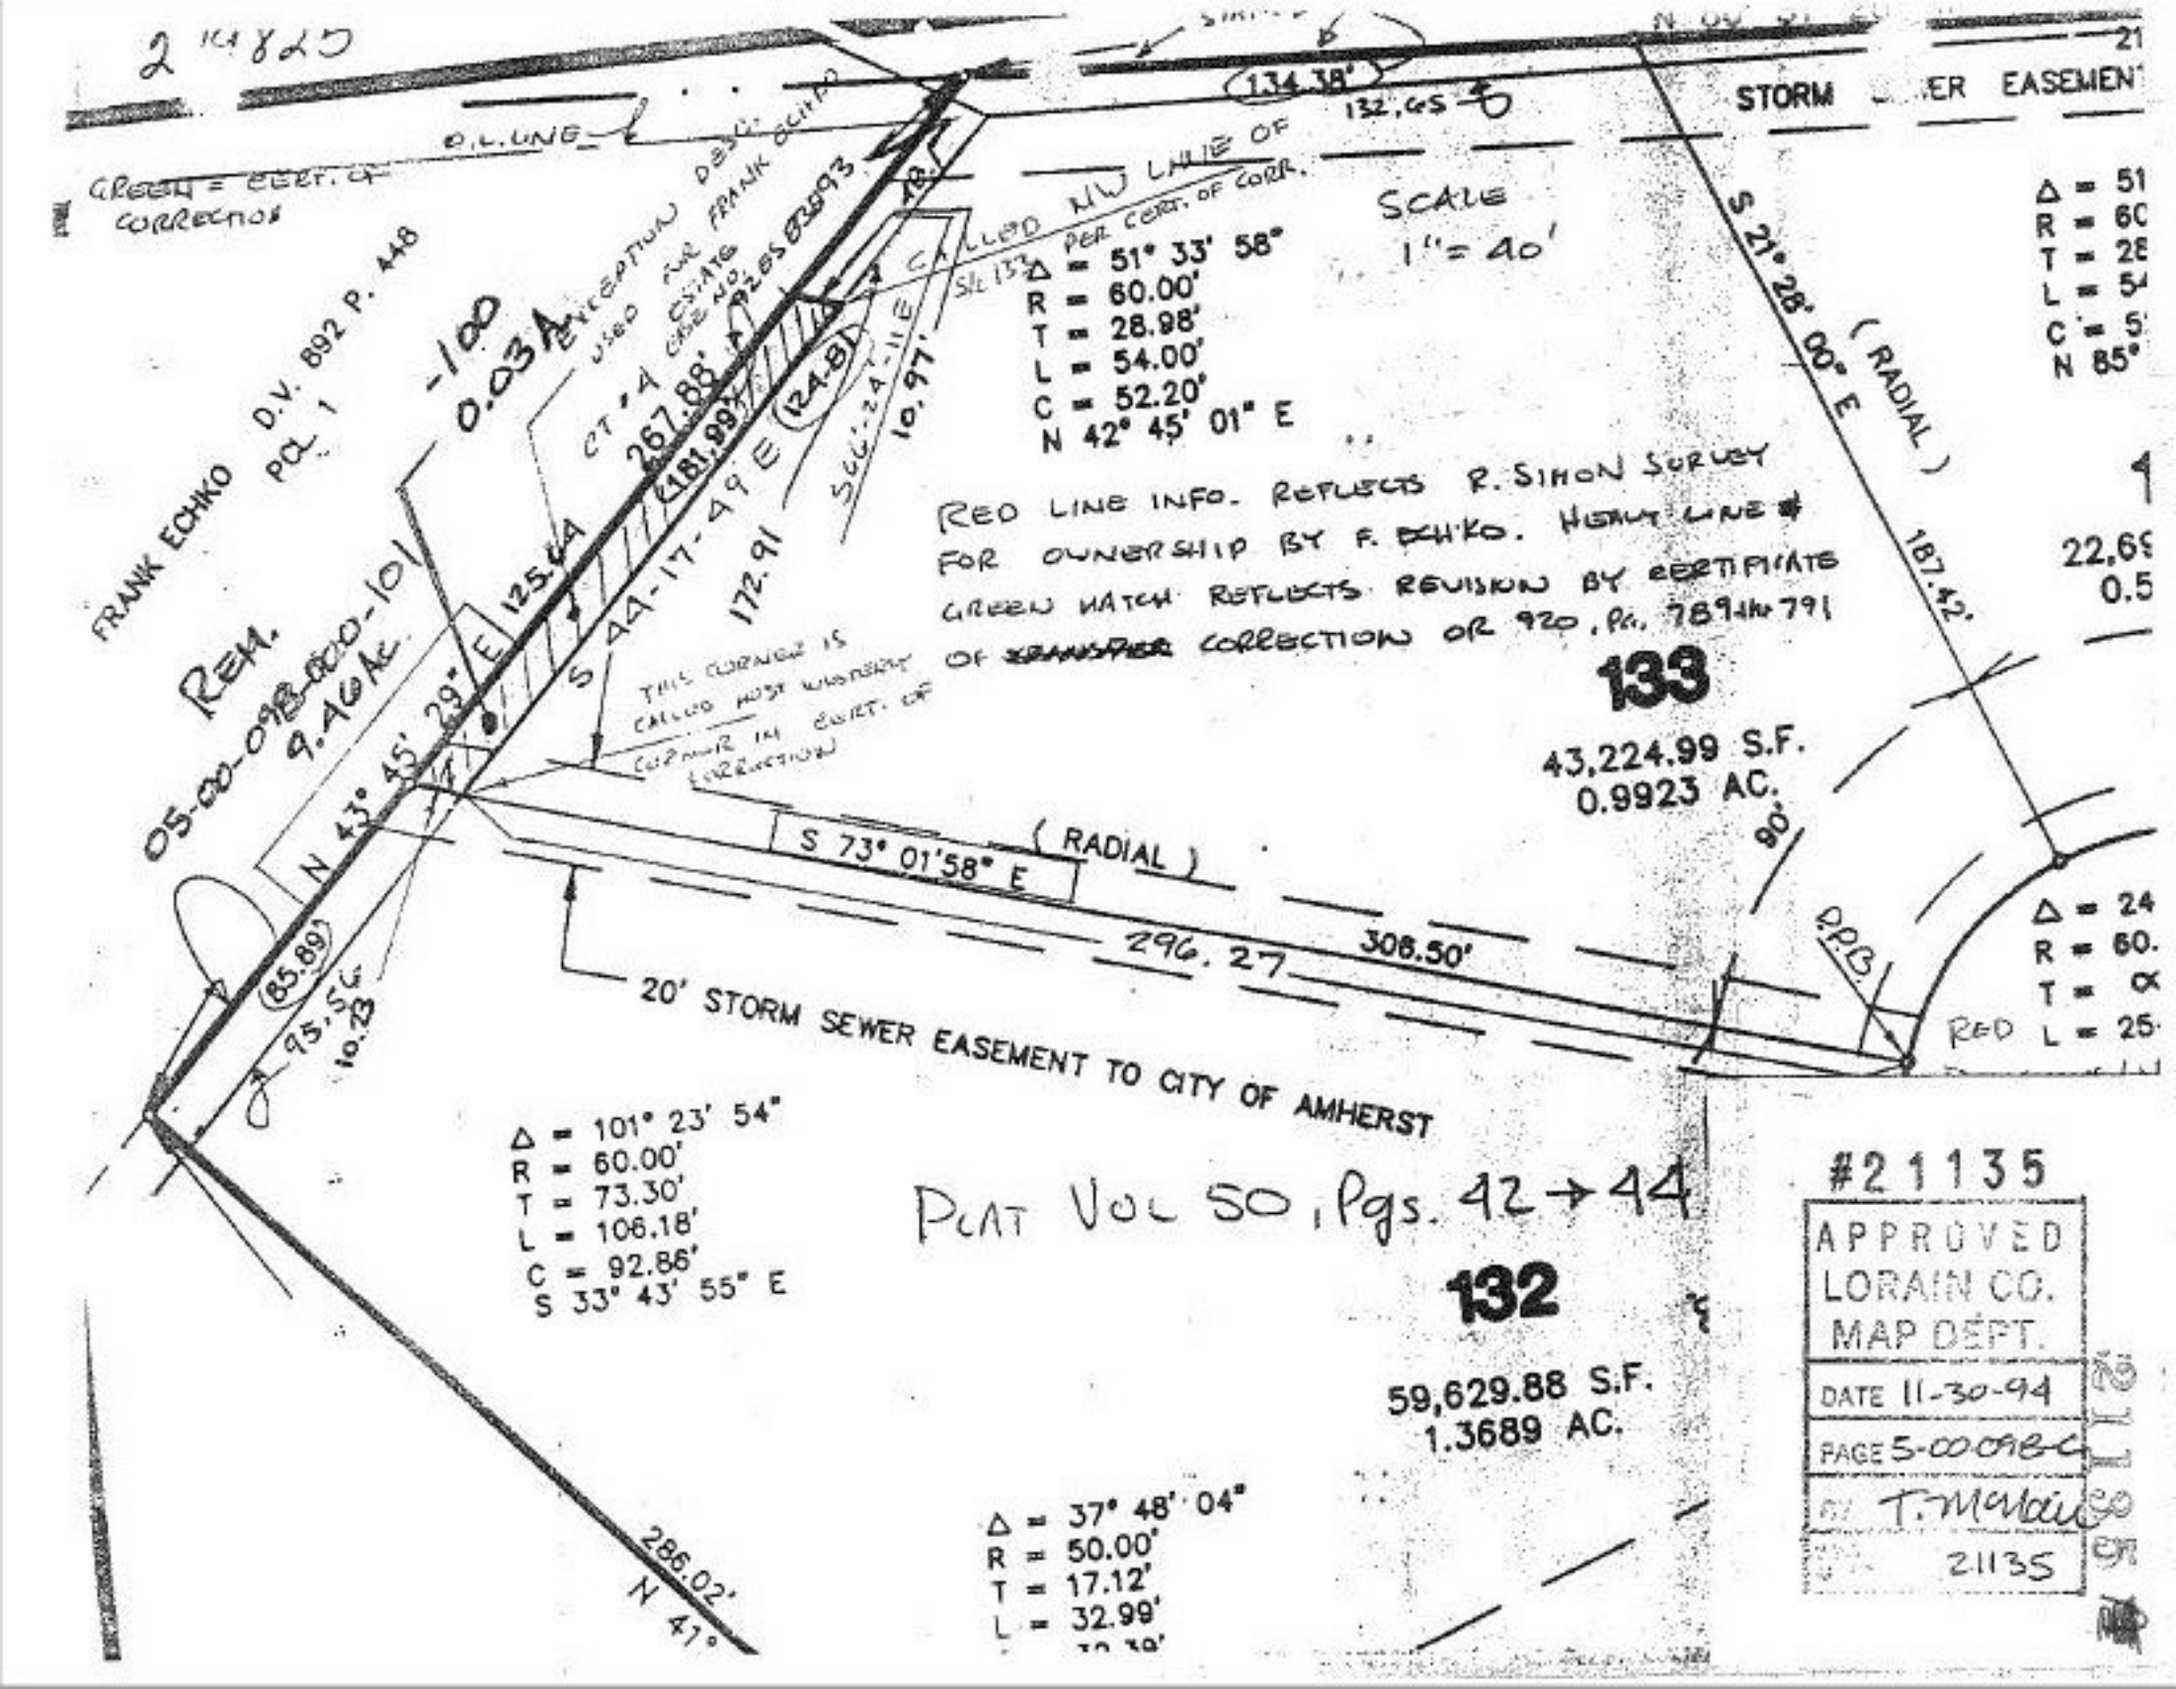
2 14825
STORM SEWER EASEMENT
134.38'
132.65
E.L. LINE
GREEN = CERT. OF CORRECTION
FRANK ECHKO D.V. 892 P. 448
PCL 1
-100
0.03A
EXCEPTION DESC. USED FOR FRANK ECHKO CT-4 ESTATE CASE NO. 92 CV 83993
267.88'
(181.99')
(124.8)
S 44-17-49 E
172.91
SCALE 1" = 40'
Δ = 51° 33' 58"
R = 60.00'
T = 28.98'
L = 54.00'
C = 52.20'
N 42° 45' 01" E
CALLED NW LINE OF SLI 133 PER CERT. OF CORR.
S 21° 28' 00" E (RADIAL)
187.42'
RED LINE INFO. REFLECTS R. SIMON SURVEY FOR OWNERSHIP BY F. ECHKO. HEAVY LINE # GREEN HATCH REFLECTS REVISION BY CERTIFICATE OF CORRECTION OR 920, Pg. 789 to 791
133
43,224.99 S.F.
0.9923 AC.
REM.
05-00-098-000-101
9.46 AC.
N 43° 45' 29" E
125.64
THIS CORNER IS CALLED MOST WESTERLY CORNER IN CERT. OF CORRECTION
S 73° 01' 58" E (RADIAL)
296.27
308.50'
90'
P.O.B.
20' STORM SEWER EASEMENT TO CITY OF AMHERST
(85.89)
95.56
10.23
Δ = 101° 23' 54"
R = 60.00'
T = 73.30'
L = 106.18'
C = 92.86'
S 33° 43' 55" E
PLAT VOL 50, Pgs. 42 → 44
132
59,629.88 S.F.
1.3689 AC.
286.02'
N 41°
Δ = 37° 48' 04"
R = 50.00'
T = 17.12'
L = 32.99'
#21135
APPROVED
LORAIN CO.
MAP DEPT.
DATE 11-30-94
PAGE 5-00098-C
BY T. Mahaffey
21135