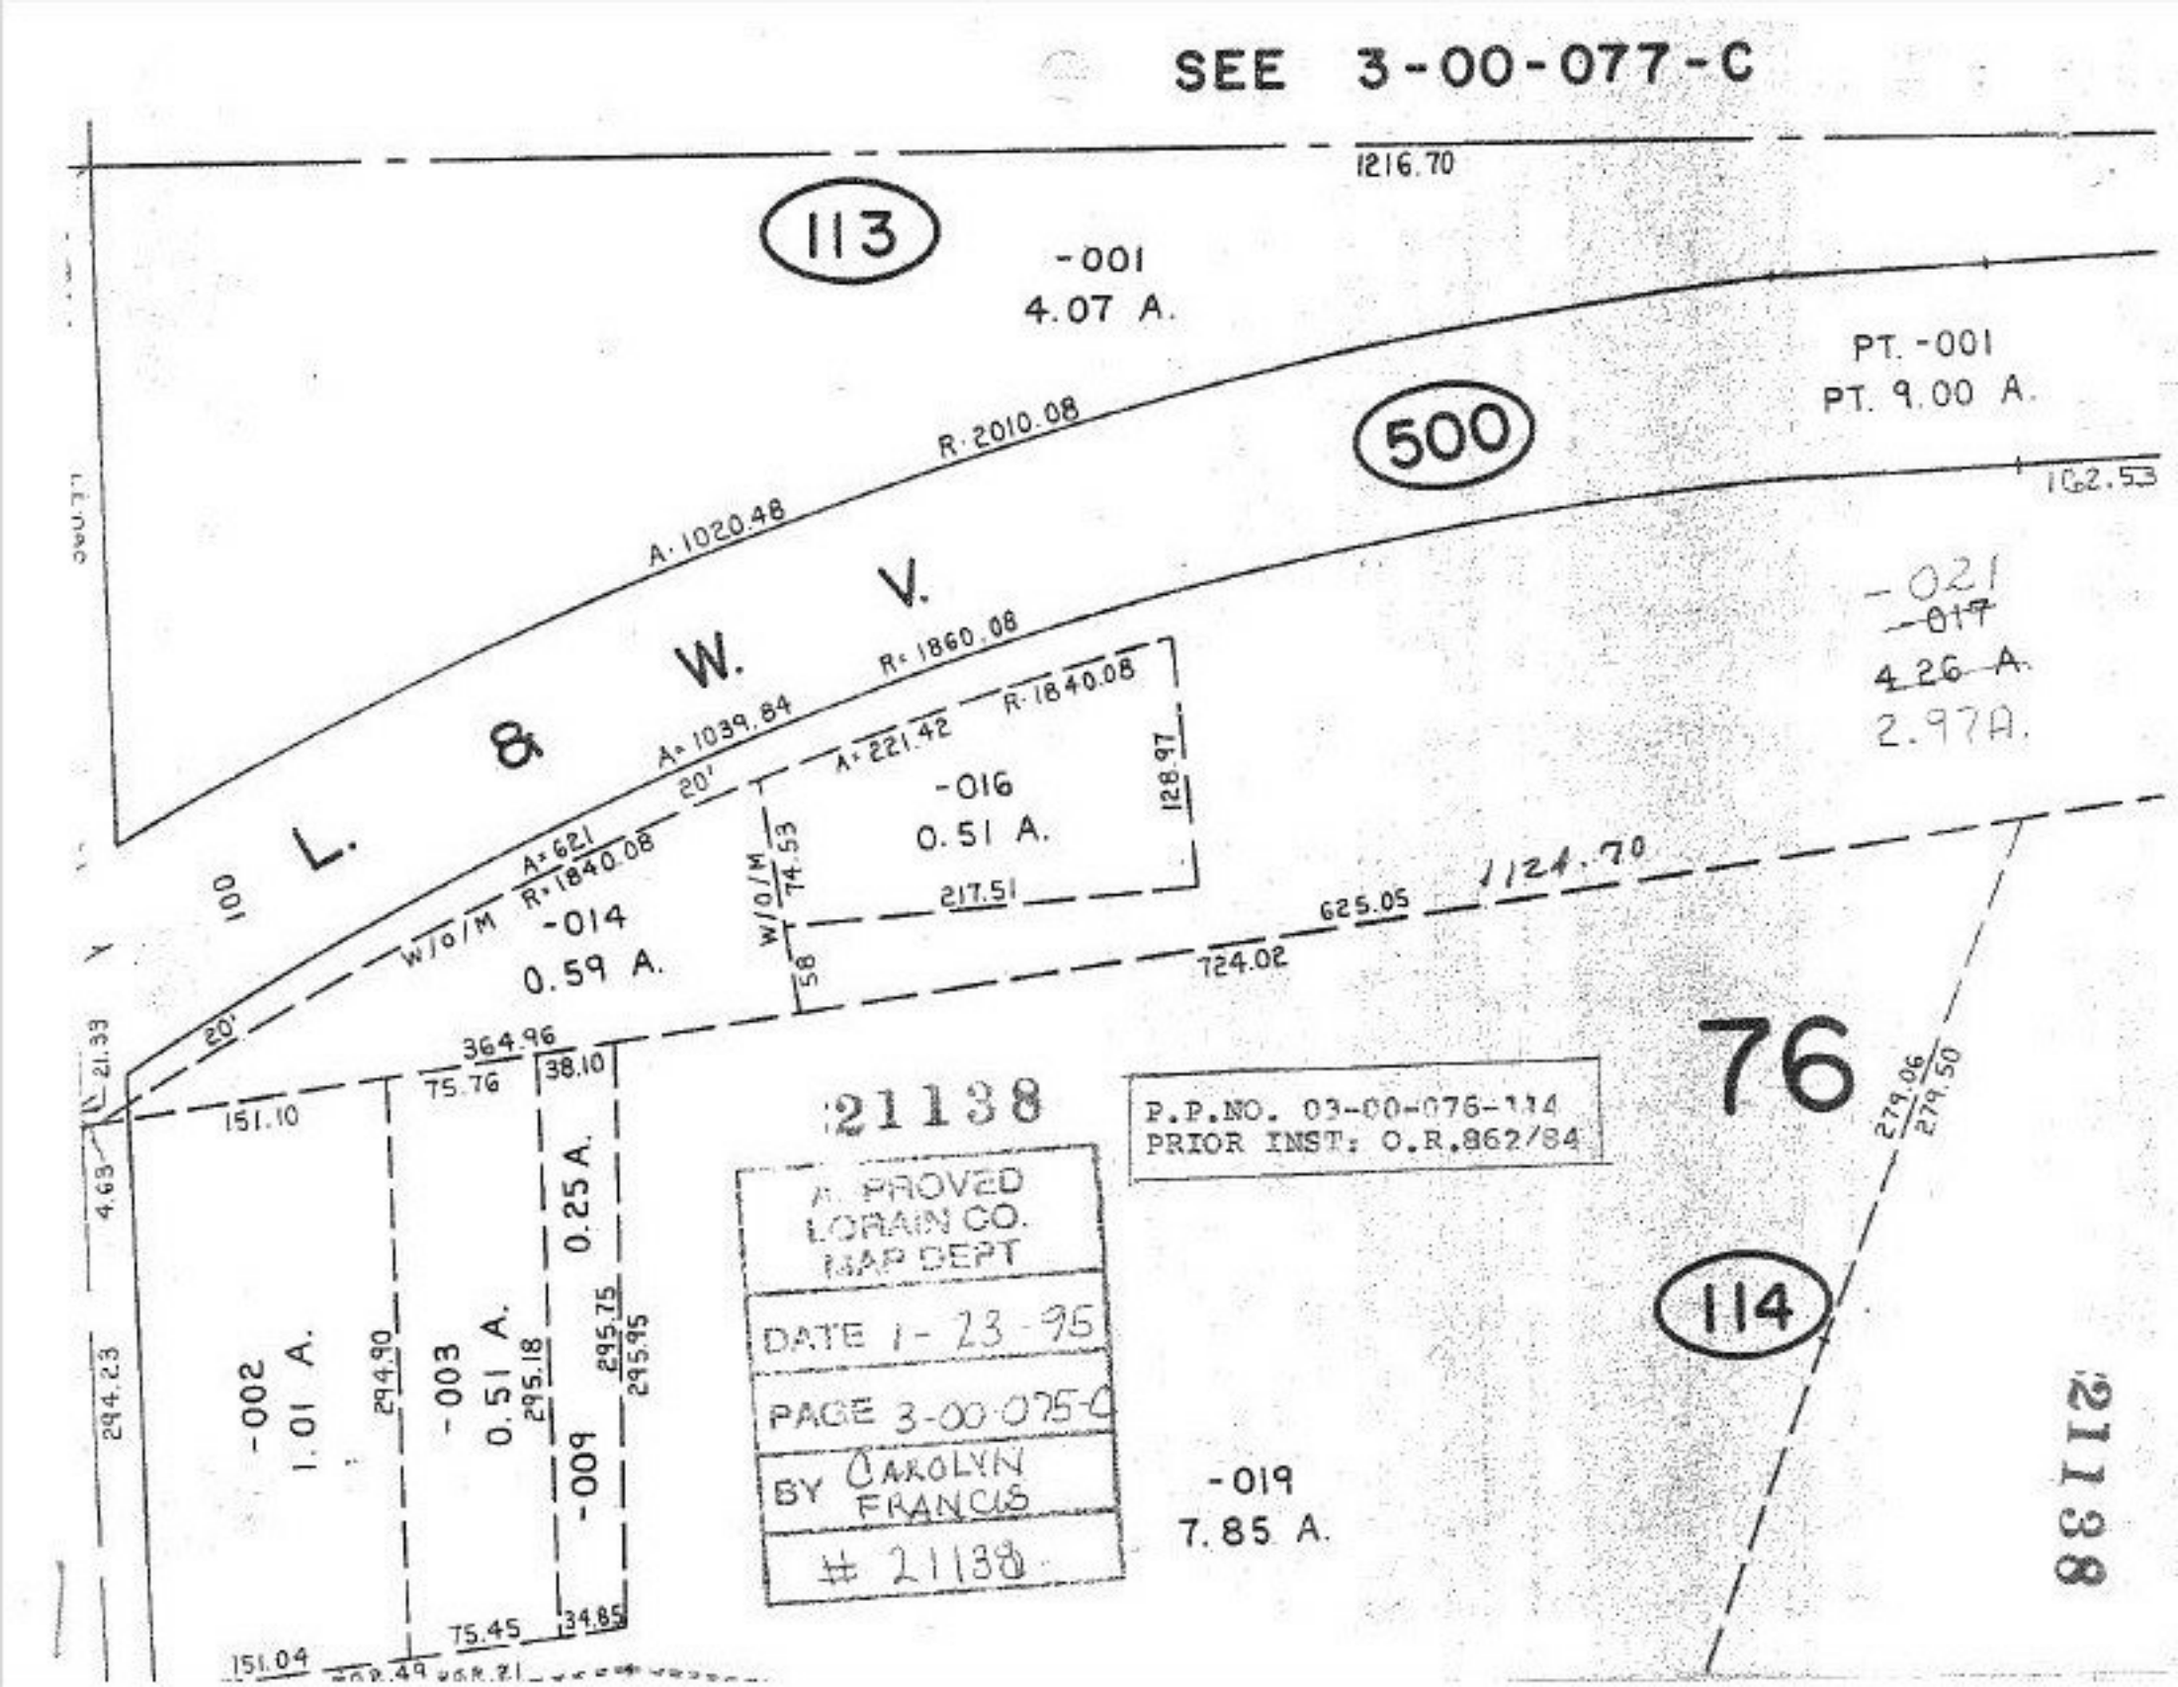
SEE 3-00-077-C
1216.70
113
-001
4.07 A.
PT. -001
PT. 9.00 A.
500
R. 2010.08
A. 1020.48
R. 1860.08
A. 1039.84
R. 1840.08
A. 221.42
20'
A. 621
R. 1840.08
W/O/M
-014
0.59 A.
-016
0.51 A.
128.97
217.51
74.53
58
724.02
625.05
1124.70
100 L. & W. V.
-021
-017
4.26 A.
2.97A.
21.33
4.63
364.96
75.76
38.10
151.10
294.23
-002
1.01 A.
294.90
-003
0.51 A.
295.18
-009
0.25 A.
295.75
295.95
75.45
34.85
151.04
21138
APPROVED
LORAIN CO.
MAP DEPT
DATE 1-23-95
PAGE 3-00-075-C
BY CAROLYN FRANCIS
21138
P.P.NO. 03-00-076-114
PRIOR INST: O.R.862/84
76
279.06
279.50
114
-019
7.85 A.
21138