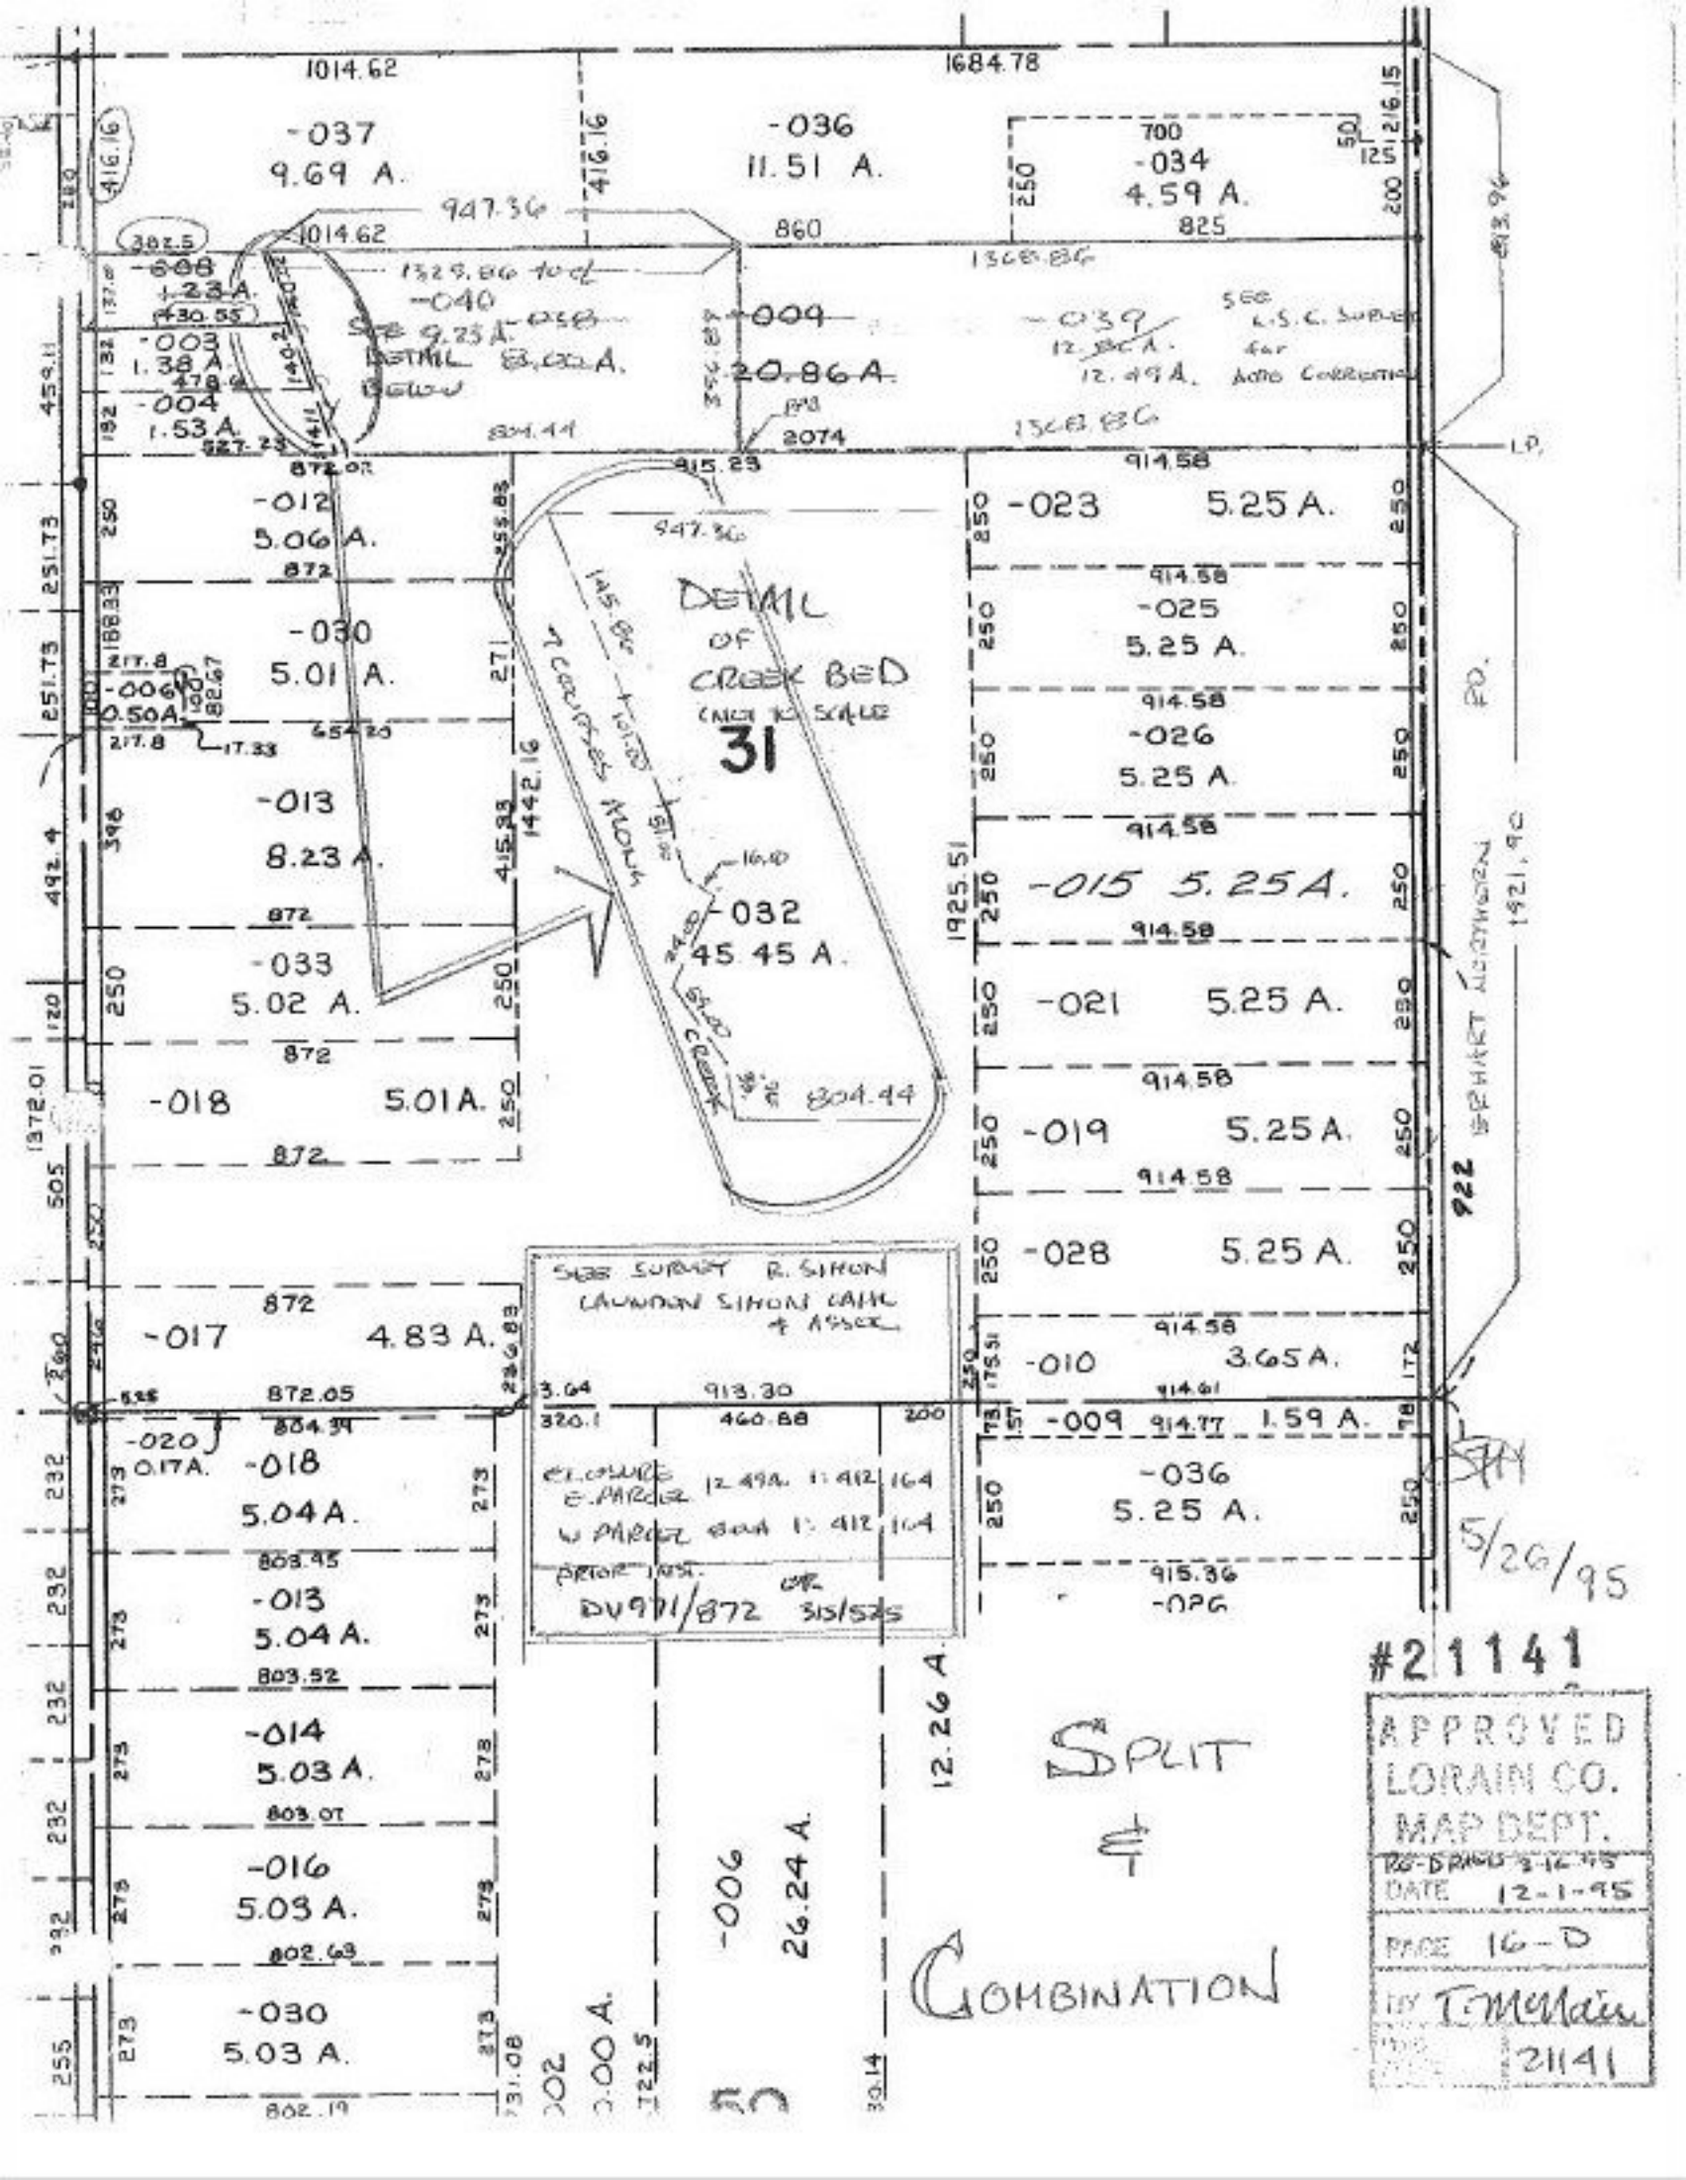
1014.62
1684.78
-037
9.69 A.
-036
11.51 A.
700
-034
4.59 A.
947.36
1014.62
860
825
1329.86 to cl
-040
9.23 A.
DETAIL 83.02 A. BELOW
-008
1.23 A.
-003
1.38 A.
-004
1.53 A.
-009
20.86 A.
-039
12.98 A.
12.49 A.
SEE U.S.C. SURVEY for ADD'L CORRECTION
1368.86
804.44
2074
915.23
914.58
-012
5.06 A.
-030
5.01 A.
-013
8.23 A.
-033
5.02 A.
-018
5.01A.
-023
5.25 A.
-025
5.25 A.
-026
5.25 A.
-015 5.25A.
-021
5.25 A.
-019
5.25 A.
-028
5.25 A.
-010
3.65A.
-009
1.59 A.
-036
5.25 A.
-026
DETAIL OF CREEK BED
CHECK TO SCALE
31
CREEK
804.44
SEE SURVEY R. SIMON
CAUNDAN SIMON CAME & ASSOC.
-017
4.83 A.
872.05
913.30
460.88
-020
0.17A.
-018
5.04 A.
-013
5.04 A.
-014
5.03 A.
-016
5.03 A.
-030
5.03 A.
-006
26.24 A.
12.26 A.
EL. CO. WIDE E. PARCEL 12.49A. I. 412/164
W. PARCEL SAME I. 412/164
PRIOR INST. DV 991/872 OR 315/525
922
LP.
SPLIT
COMBINATION
5/26/95
#21141
APPROVED
LORAIN CO.
MAP DEPT.
RE-DRAWN 2-16-95
DATE 12-1-95
PAGE 16-D
BY T. McClain
21141