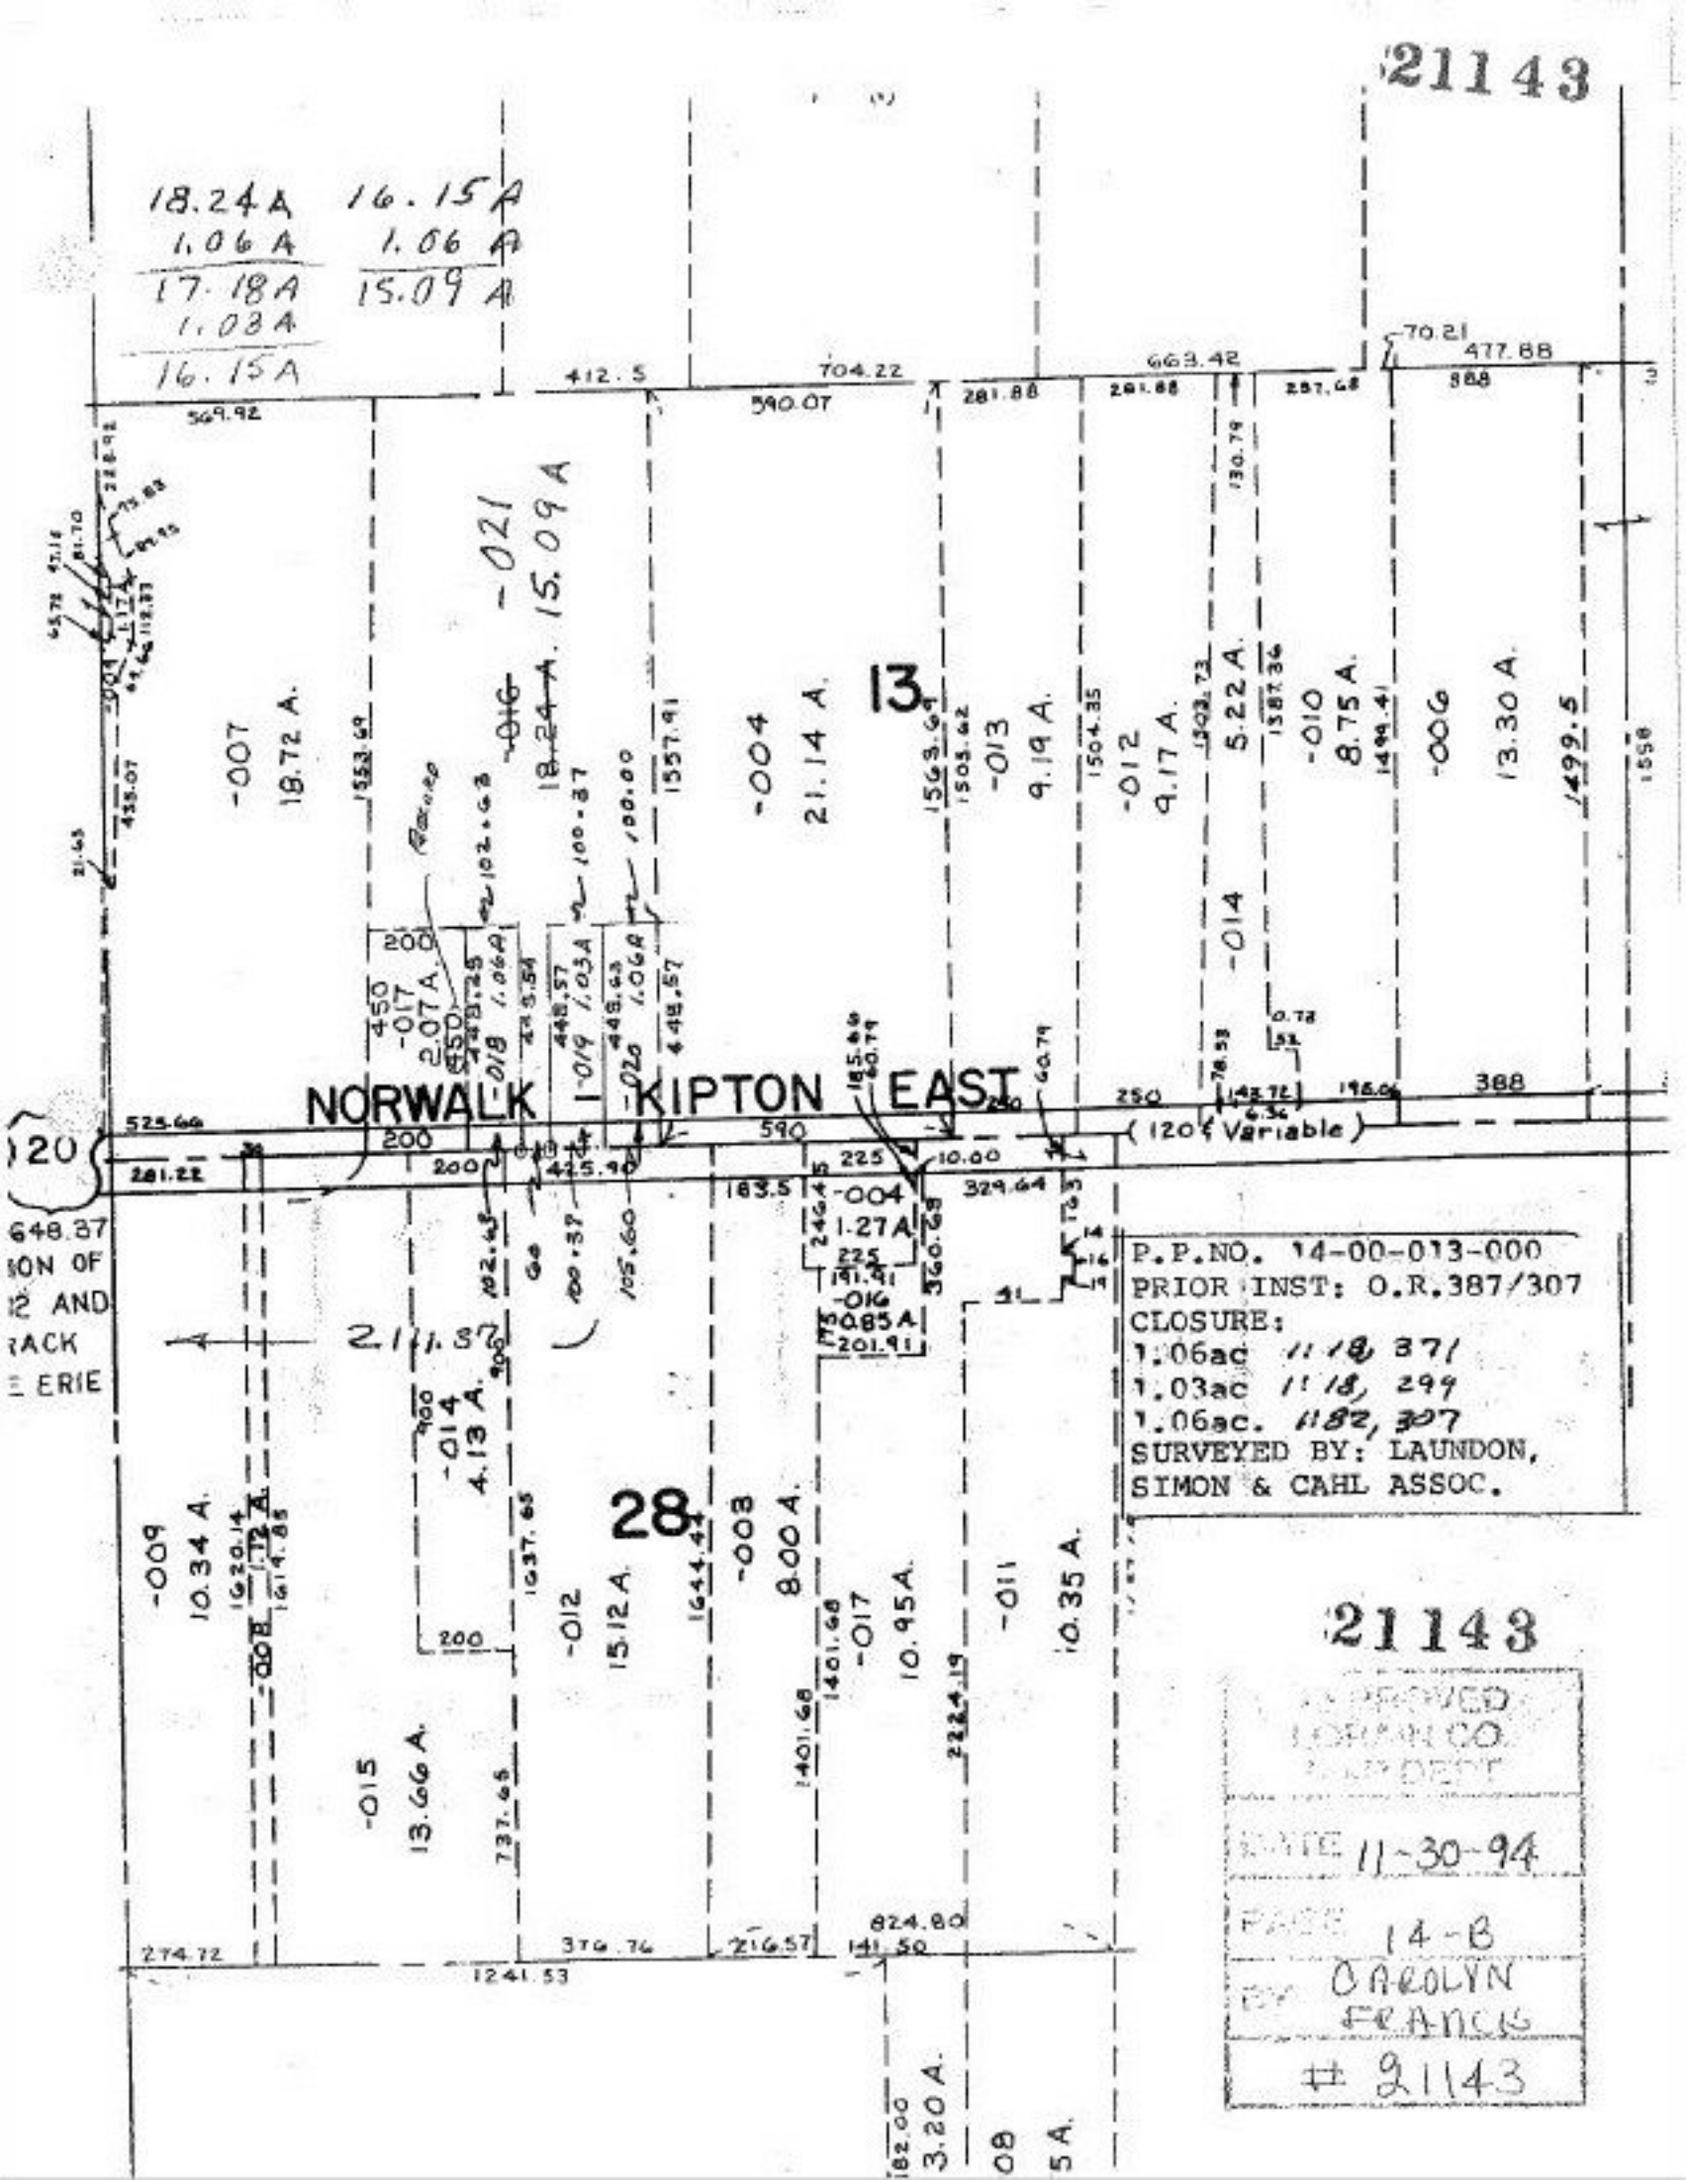
21143
18.24 A
1.06 A
17.18 A
1.03 A
16.15 A
16.15 A
1.06 A
15.09 A
NORWALK - KIPTON EAST
(120' Variable)
13
28
-007
18.72 A.
-021
15.09 A.
-016
18.24 A.
-004
21.14 A.
-013
9.19 A.
-012
9.17 A.
-014
5.22 A.
-010
8.75 A.
-006
13.30 A.
-017
2.07 A.
-018
1.06 A.
-019
1.03 A.
-020
1.06 A.
-004
1.27 A.
-016
0.85 A.
-014
4.13 A.
-009
10.34 A.
-008
1.72 A.
-015
13.66 A.
-012
15.12 A.
-003
8.00 A.
-017
10.95 A.
-011
10.35 A.
3.20 A.
P.P.NO. 14-00-013-000
PRIOR INST: O.R.387/307
CLOSURE:
1.06ac 1118 371
1.03ac 1118, 299
1.06ac. 1182, 307
SURVEYED BY: LAUNDON, SIMON & CAHL ASSOC.
21143
APPROVED
ENGR DEPT
DATE 11-30-94
PAGE 14-B
BY CAROLYN FRANCIS
21143