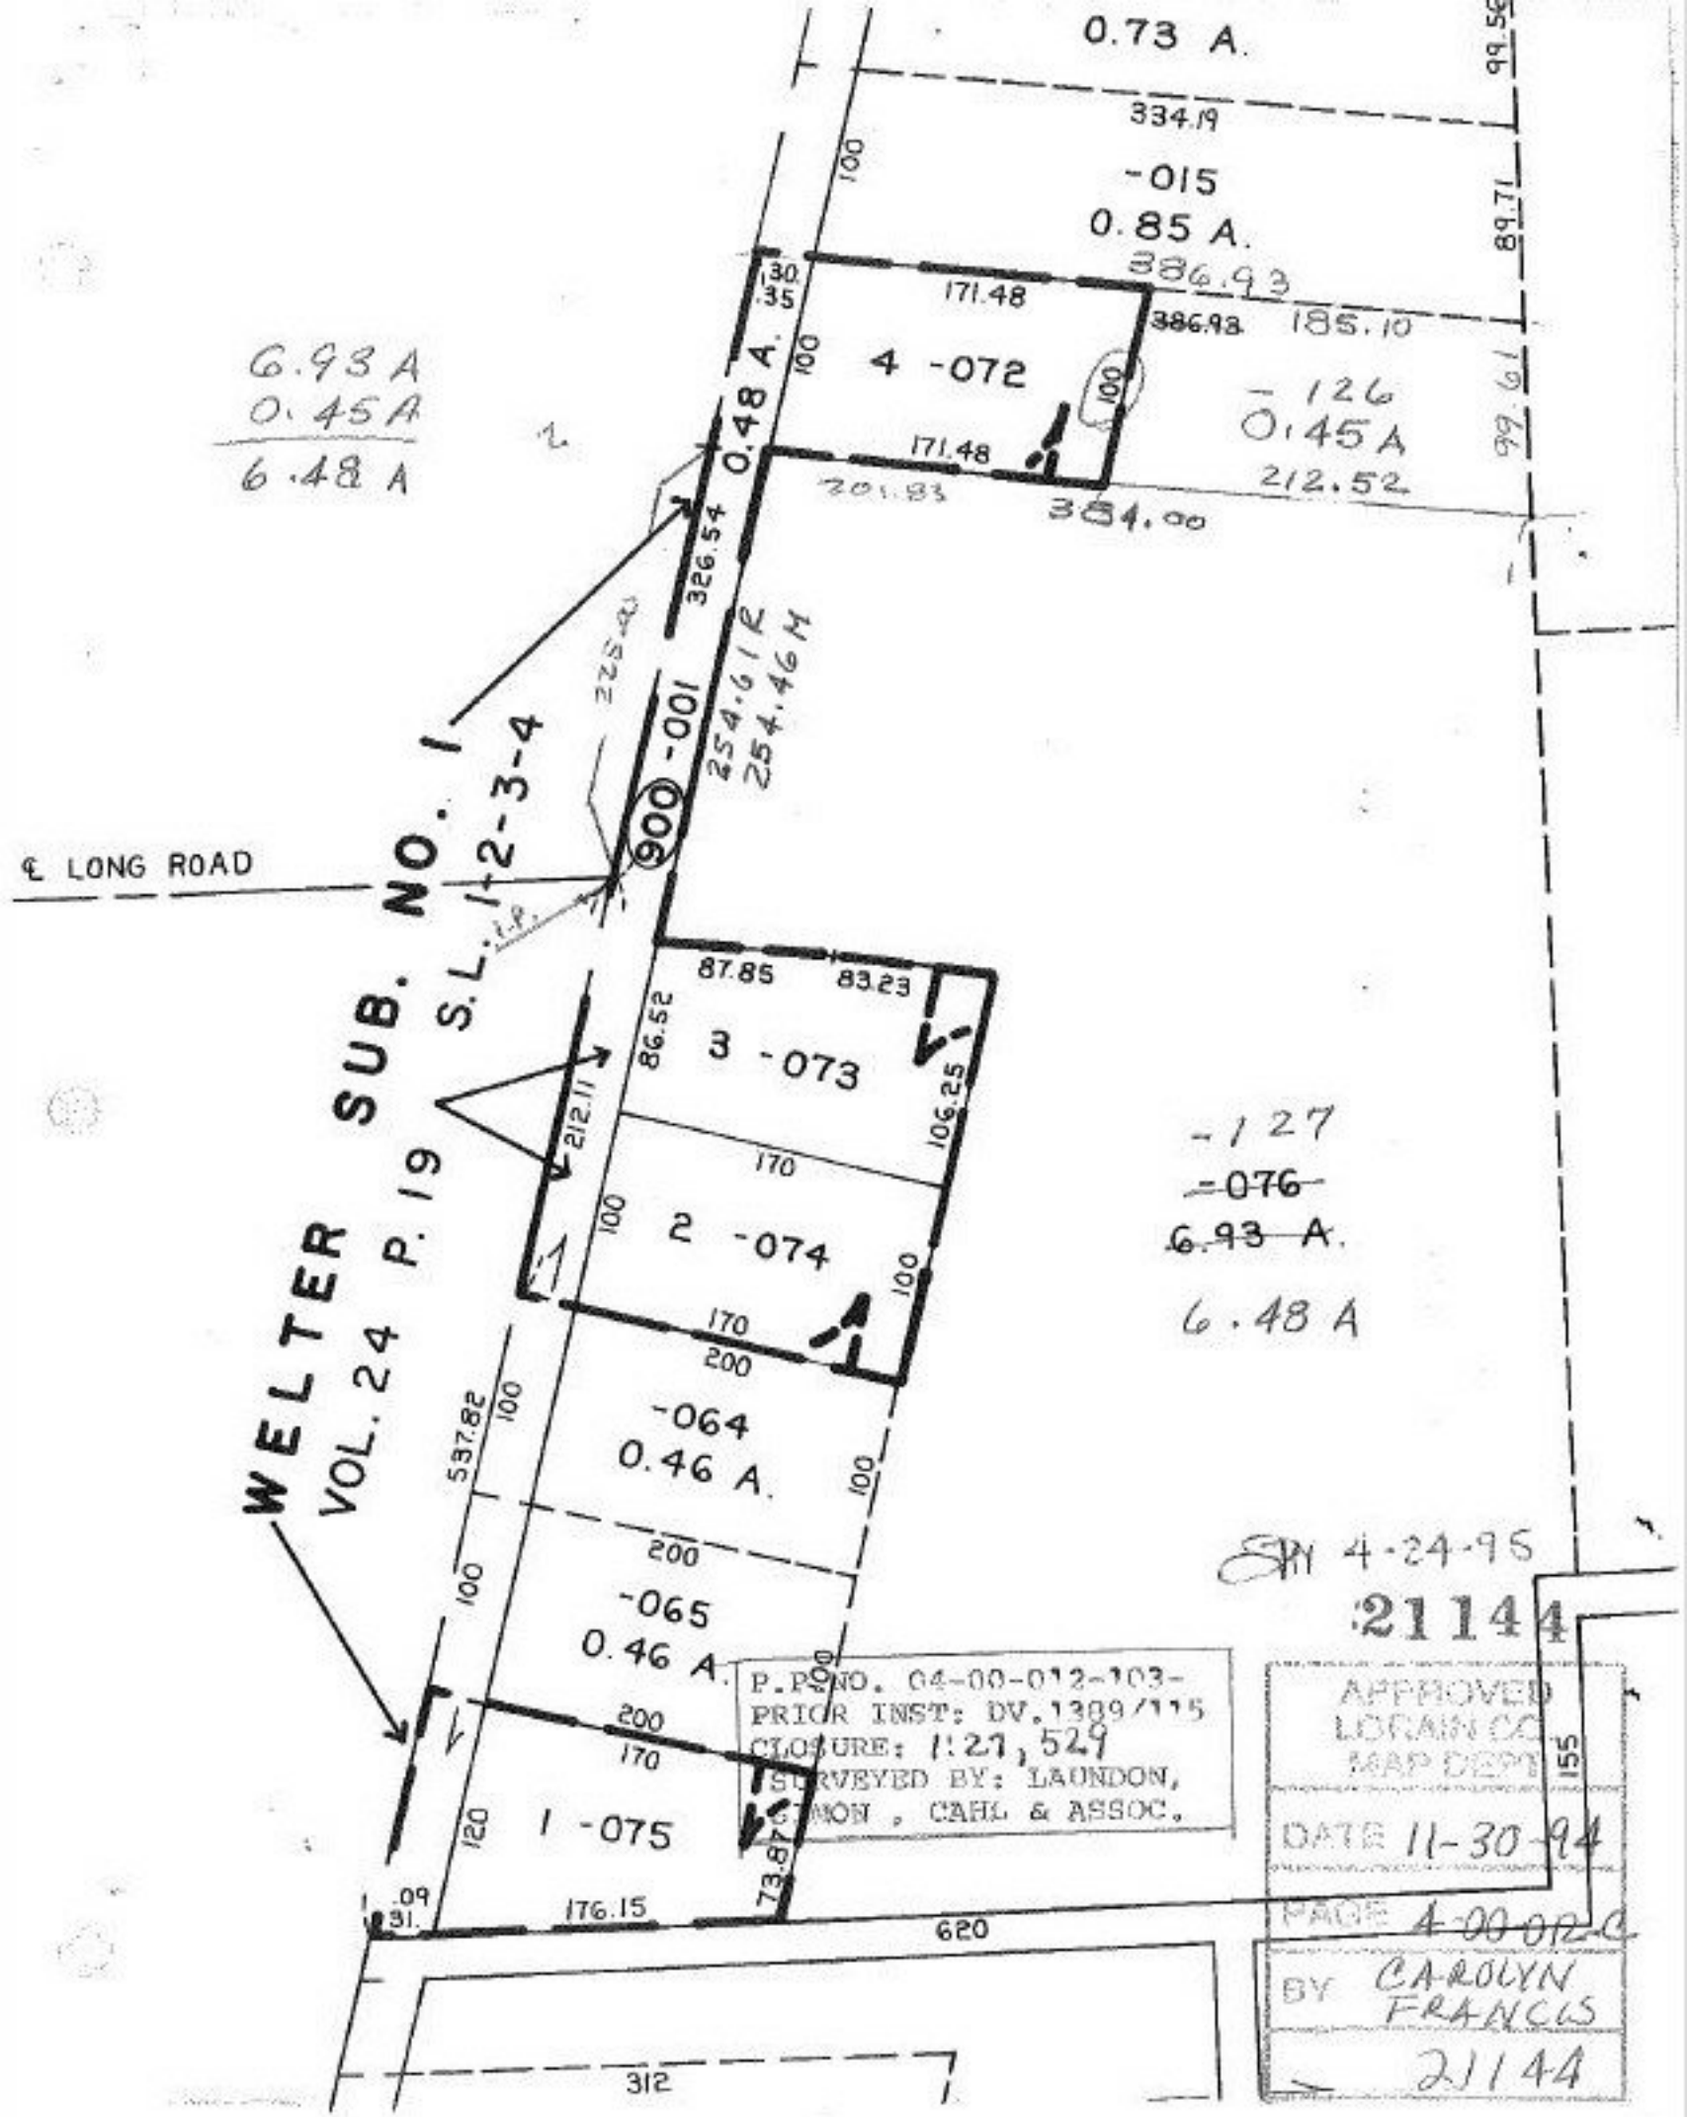
0.73 A.
334.19
99.56
-015
0.85 A.
386.93
89.71
171.48
185.10
4 -072
0.48 A.
6.93 A
0.45A
6.48 A
-126
0.45A
212.52
99.61
201.83
384.00
326.54
254.61E
254.46M
-001
900
℄ LONG ROAD
WELTER SUB. NO. 1
VOL. 24 P. 19
S.L. 1-2-3-4
87.85
83.23
86.52
3 -073
106.25
212.11
170
2 -074
-127
-076
6.93 A.
6.48 A
537.82
-064
0.46 A.
-065
0.46 A.
200
1 -075
120
73.87
176.15
620
312
155
P.P.NO. 04-00-012-103-
PRIOR INST: DV.1389/115
CLOSURE: 1:21,529
SURVEYED BY: LAUNDON, SIMON, CAHL & ASSOC.
APPROVED
LORAIN CO.
MAP DEPT.
DATE 11-30-94
PAGE 4-00-012-C
BY CAROLYN FRANCIS
21144
4-24-95
21144