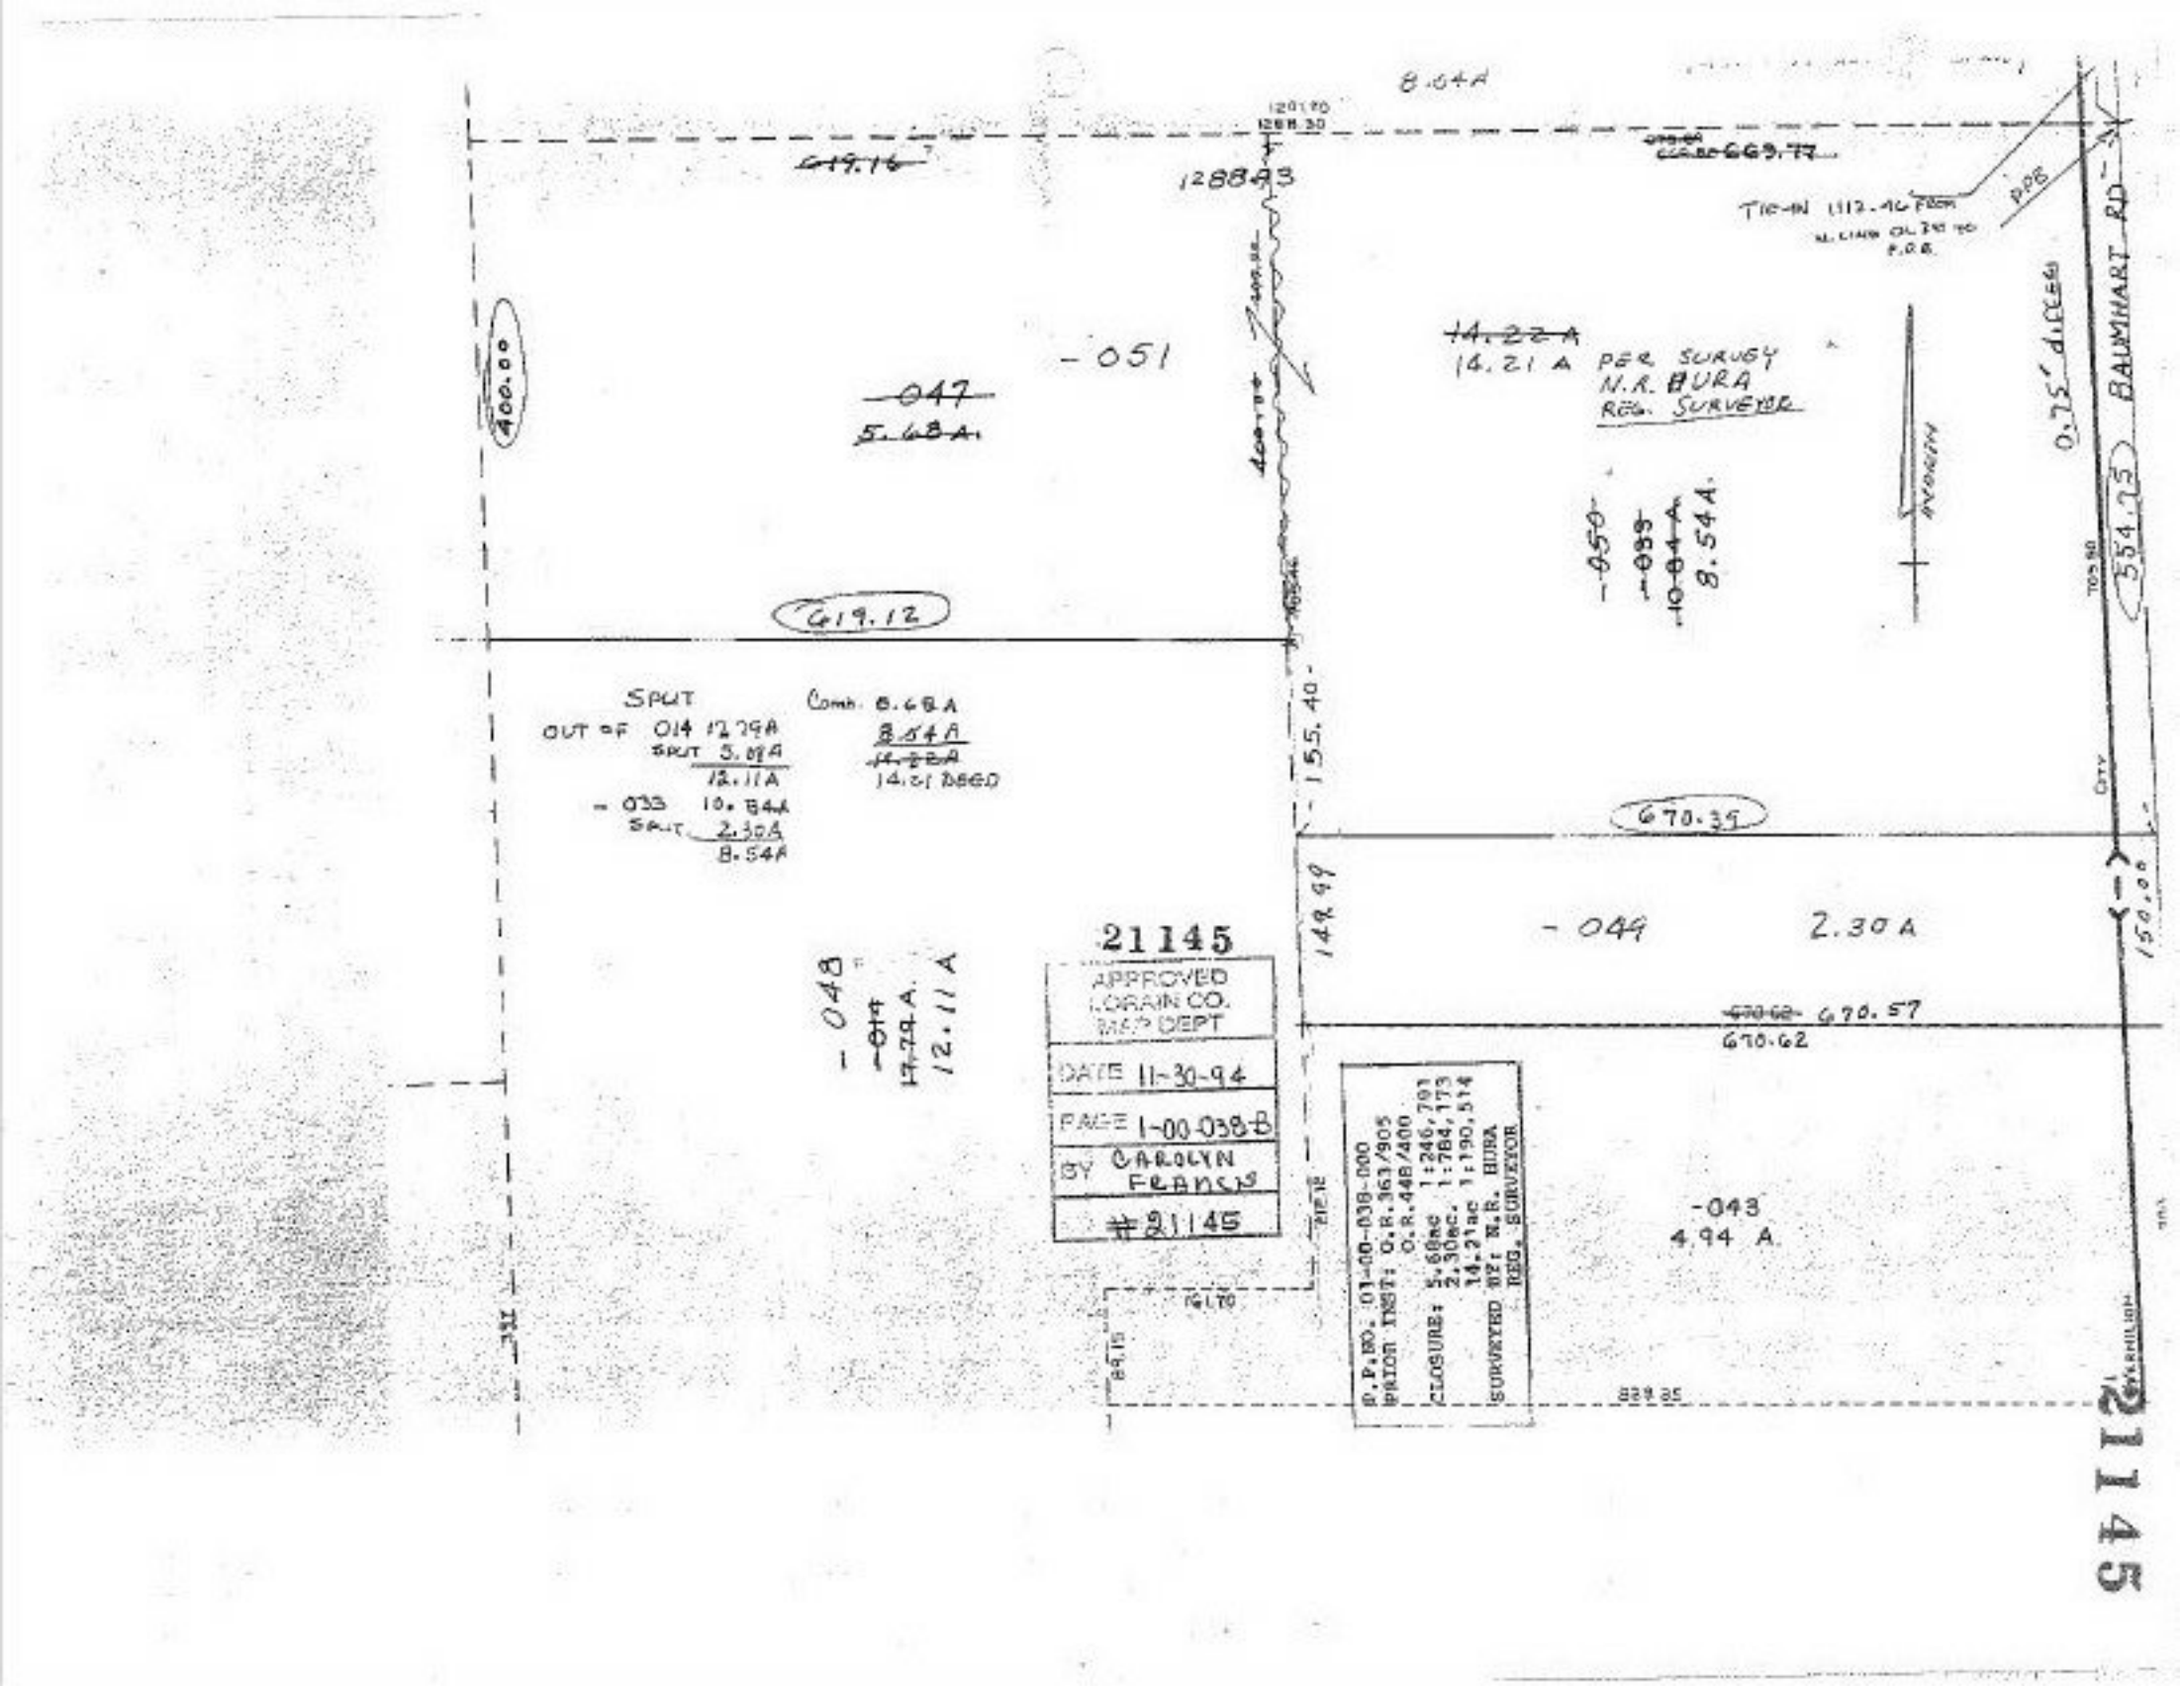
8.64A
1201.70
1288.30
619.16
1288.30
669.77
TIE-IN 113.46 FROM
N. LINE OF TR 70
P.O.B.
P.O.B.
14.22A
14.21 A PER SURVEY
N.R. BURA
REG. SURVEYOR
-051
047
5.68A.
400.00
400.00
-050
-033
10.84A.
8.54A.
0.25' dedicated
354.25
BALMHART RD
619.12
155.40
SPLIT
OUT OF 014 12.29A
SPLIT 5.68A
12.11A
-033 10.84A
SPLIT 2.30A
8.54A
Comb. 8.68A
8.54A
14.22A
14.21 DEED
670.35
21145
APPROVED
LORAIN CO.
MAP DEPT
DATE 11-30-94
PAGE 1-00-038-B
BY CAROLYN
FRANCIS
#21145
148.99
-049
2.30 A
670.62
670.57
670.62
-048
-014
17.29 A.
12.11 A
-043
4.94 A
P.P.NO: 01-00-038-000
PRIOR INST: O.R.363/905
O.R.448/400
CLOSURE: 5.68ac 1:246,791
2.30ac. 1:784,173
14.21ac 1:190,514
SURVEYED BY: N.R. BURA
REG. SURVEYOR
150.00
331
839.35
21145