21146

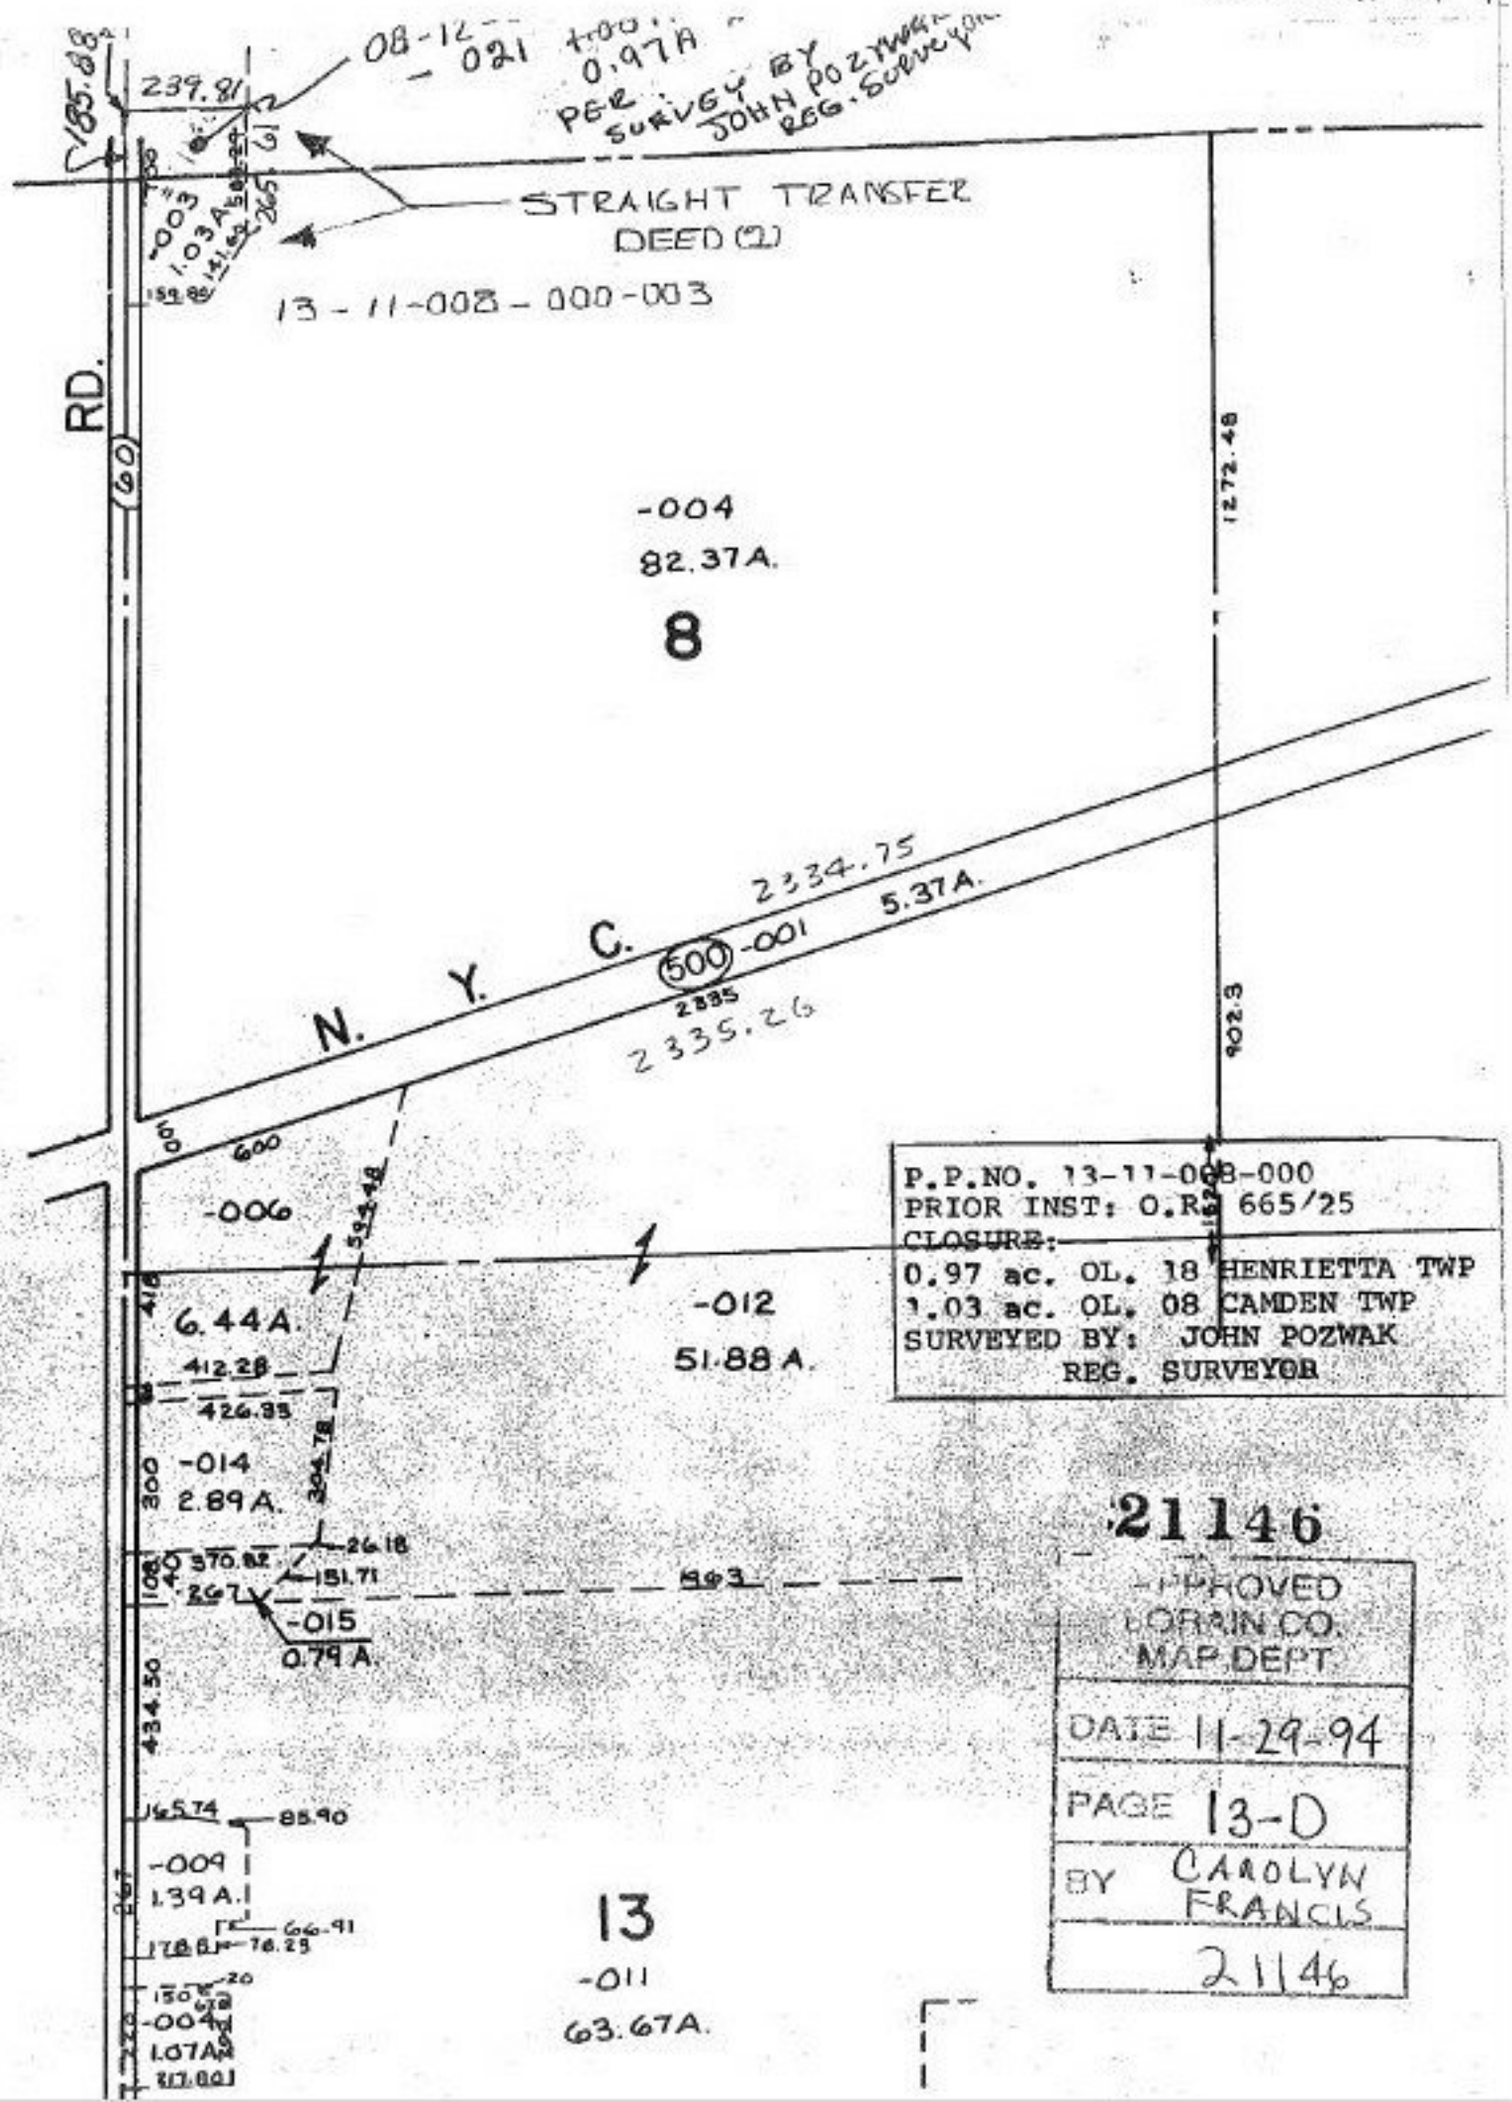

P.P.NO. 13-11-008-000
PRIOR INST: O.R. 665/25
CLOSURE:
0.97 ac. OL. 18 HENRIETTA TWP
1.03 ac. OL. 08 CAMDEN TWP
SURVEYED BY: JOHN POZWAK
REG. SURVEYOR

21146

APPROVED
LORAIN CO.
MAP DEPT.
DATE 11-29-94
PAGE 13-D
BY CAROLYN FRANCIS
21146