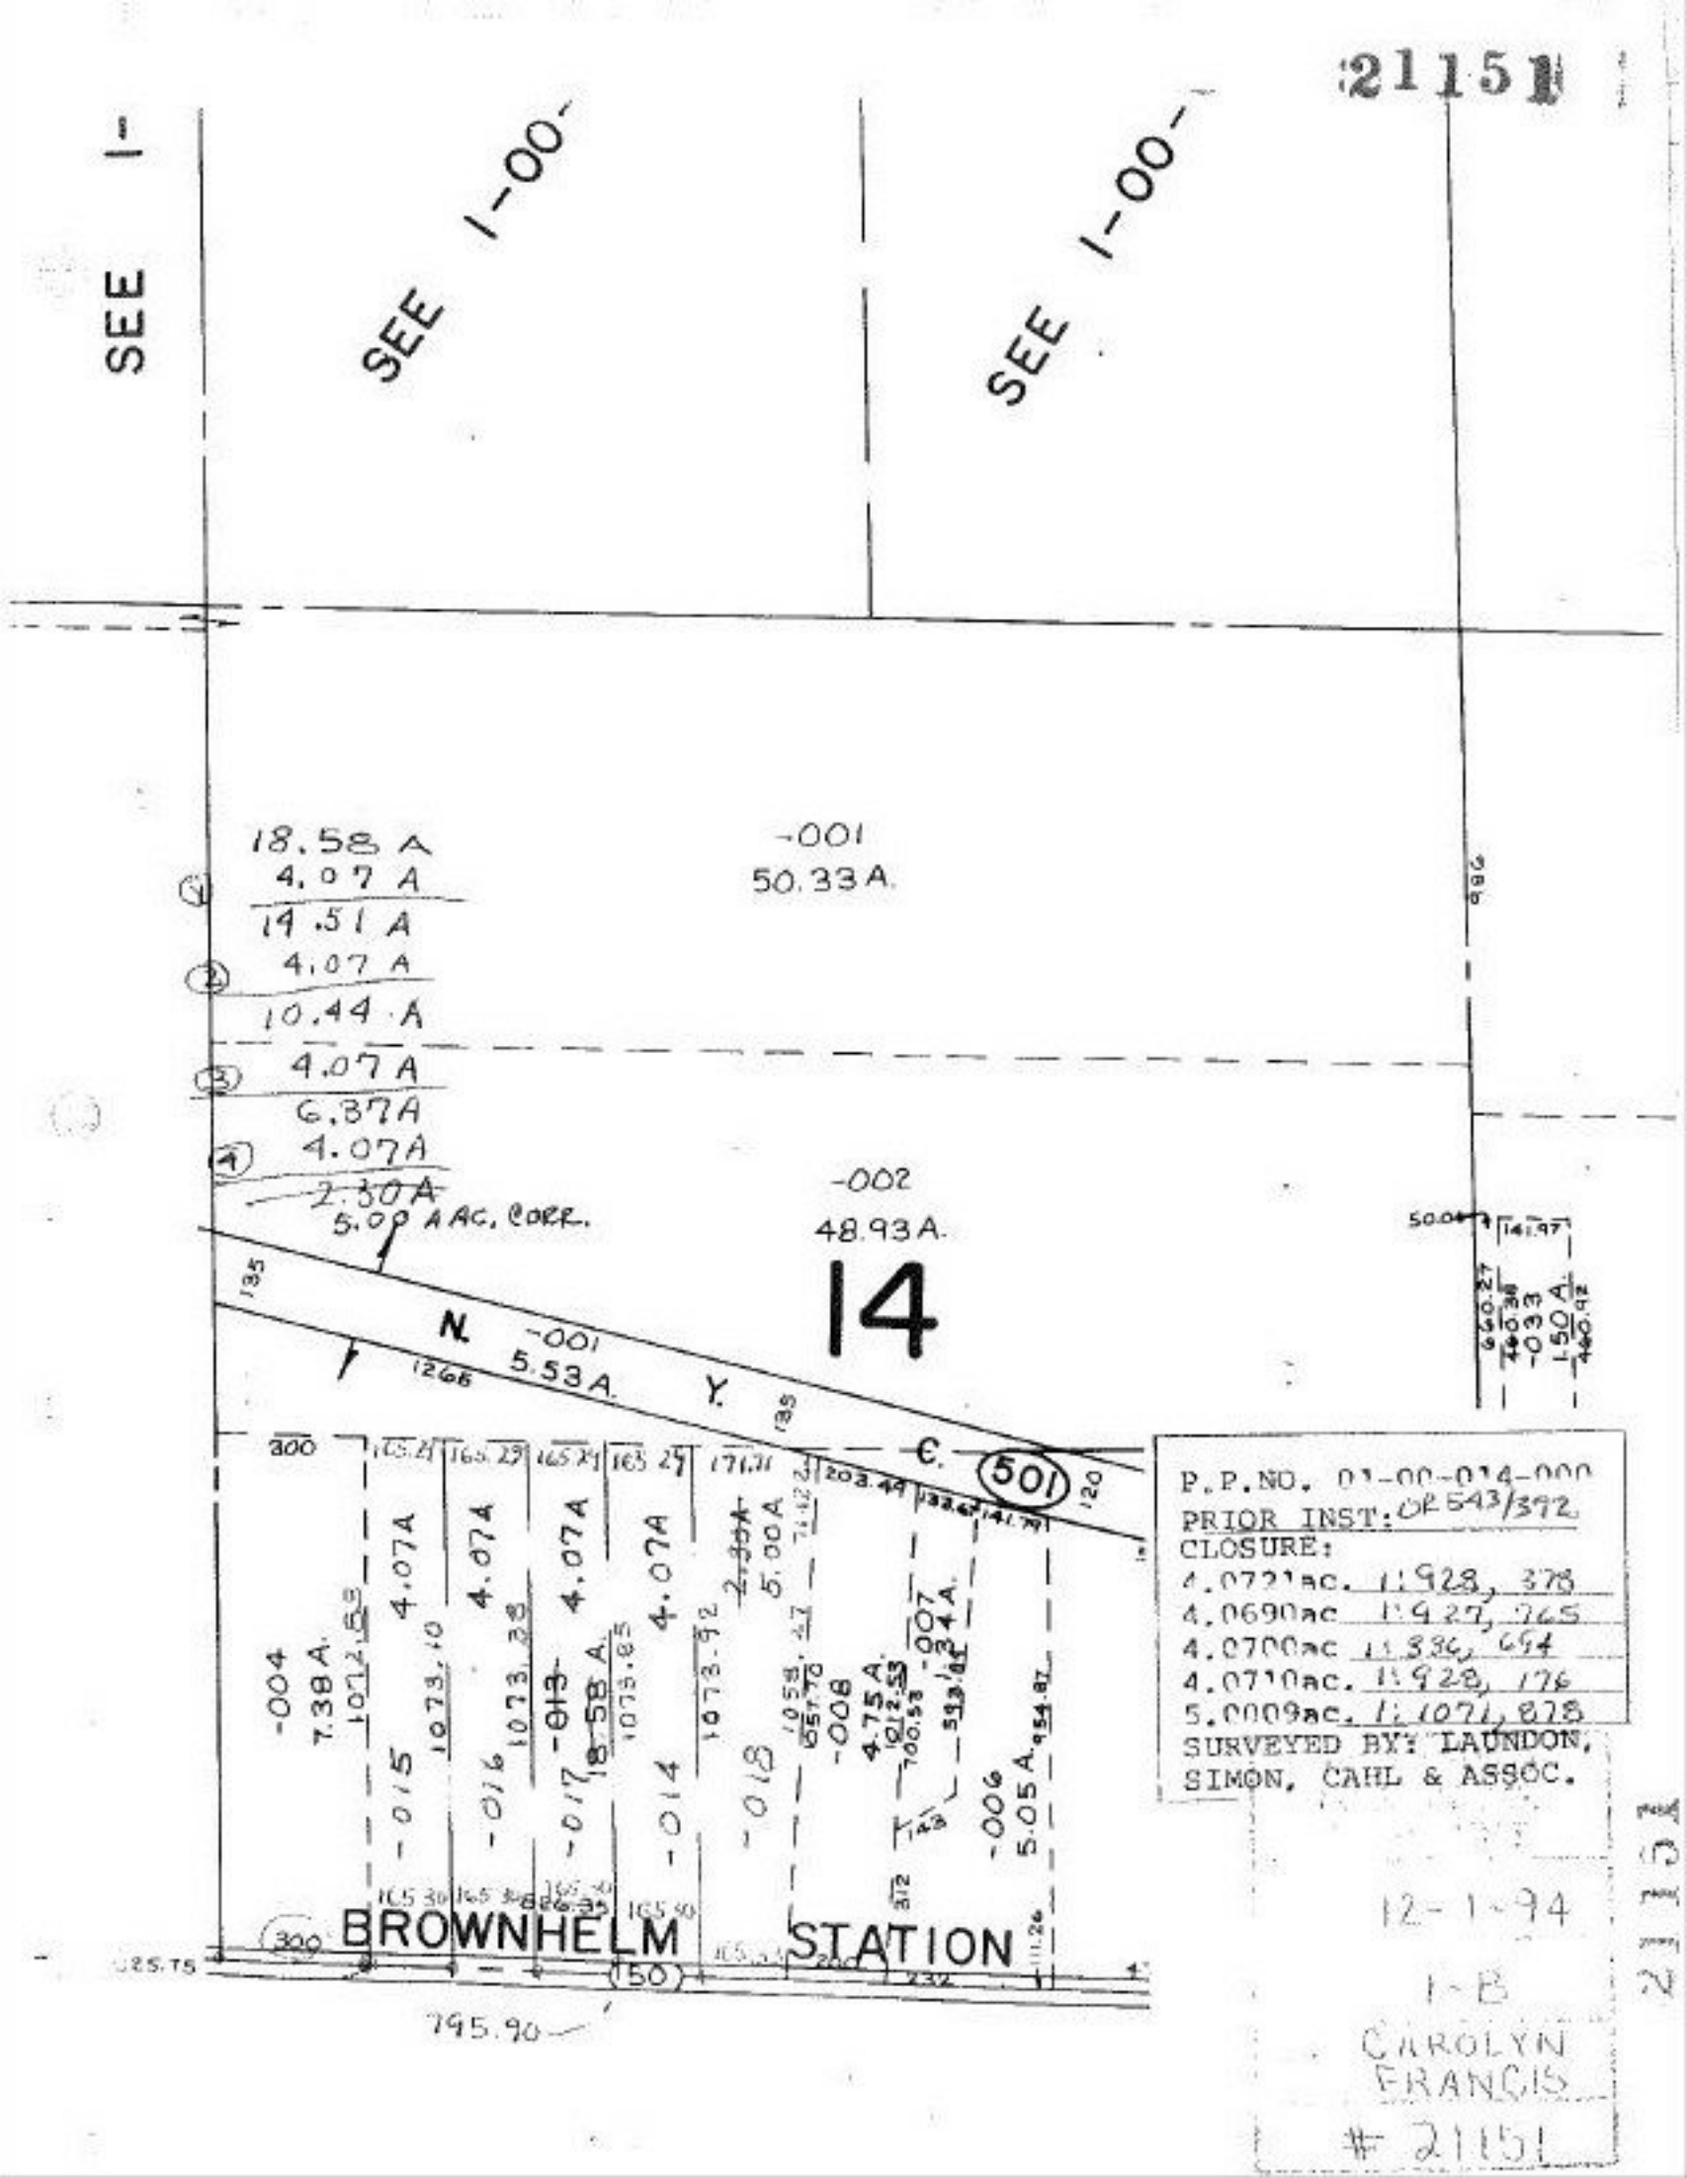

P.P.NO. 01-00-014-000
PRIOR INST: OR 543/372
CLOSURE:
4.0721ac. I: 928, 378
4.0690ac I: 927, 765
4.0700ac I: 836, 694
4.0710ac. I: 928, 176
5.0009ac. I: 1071, 878
SURVEYED BY: LAUNDON, SIMON, CAHL & ASSOC.

12-1-94
1-B
CAROLYN FRANCIS
21151

21151