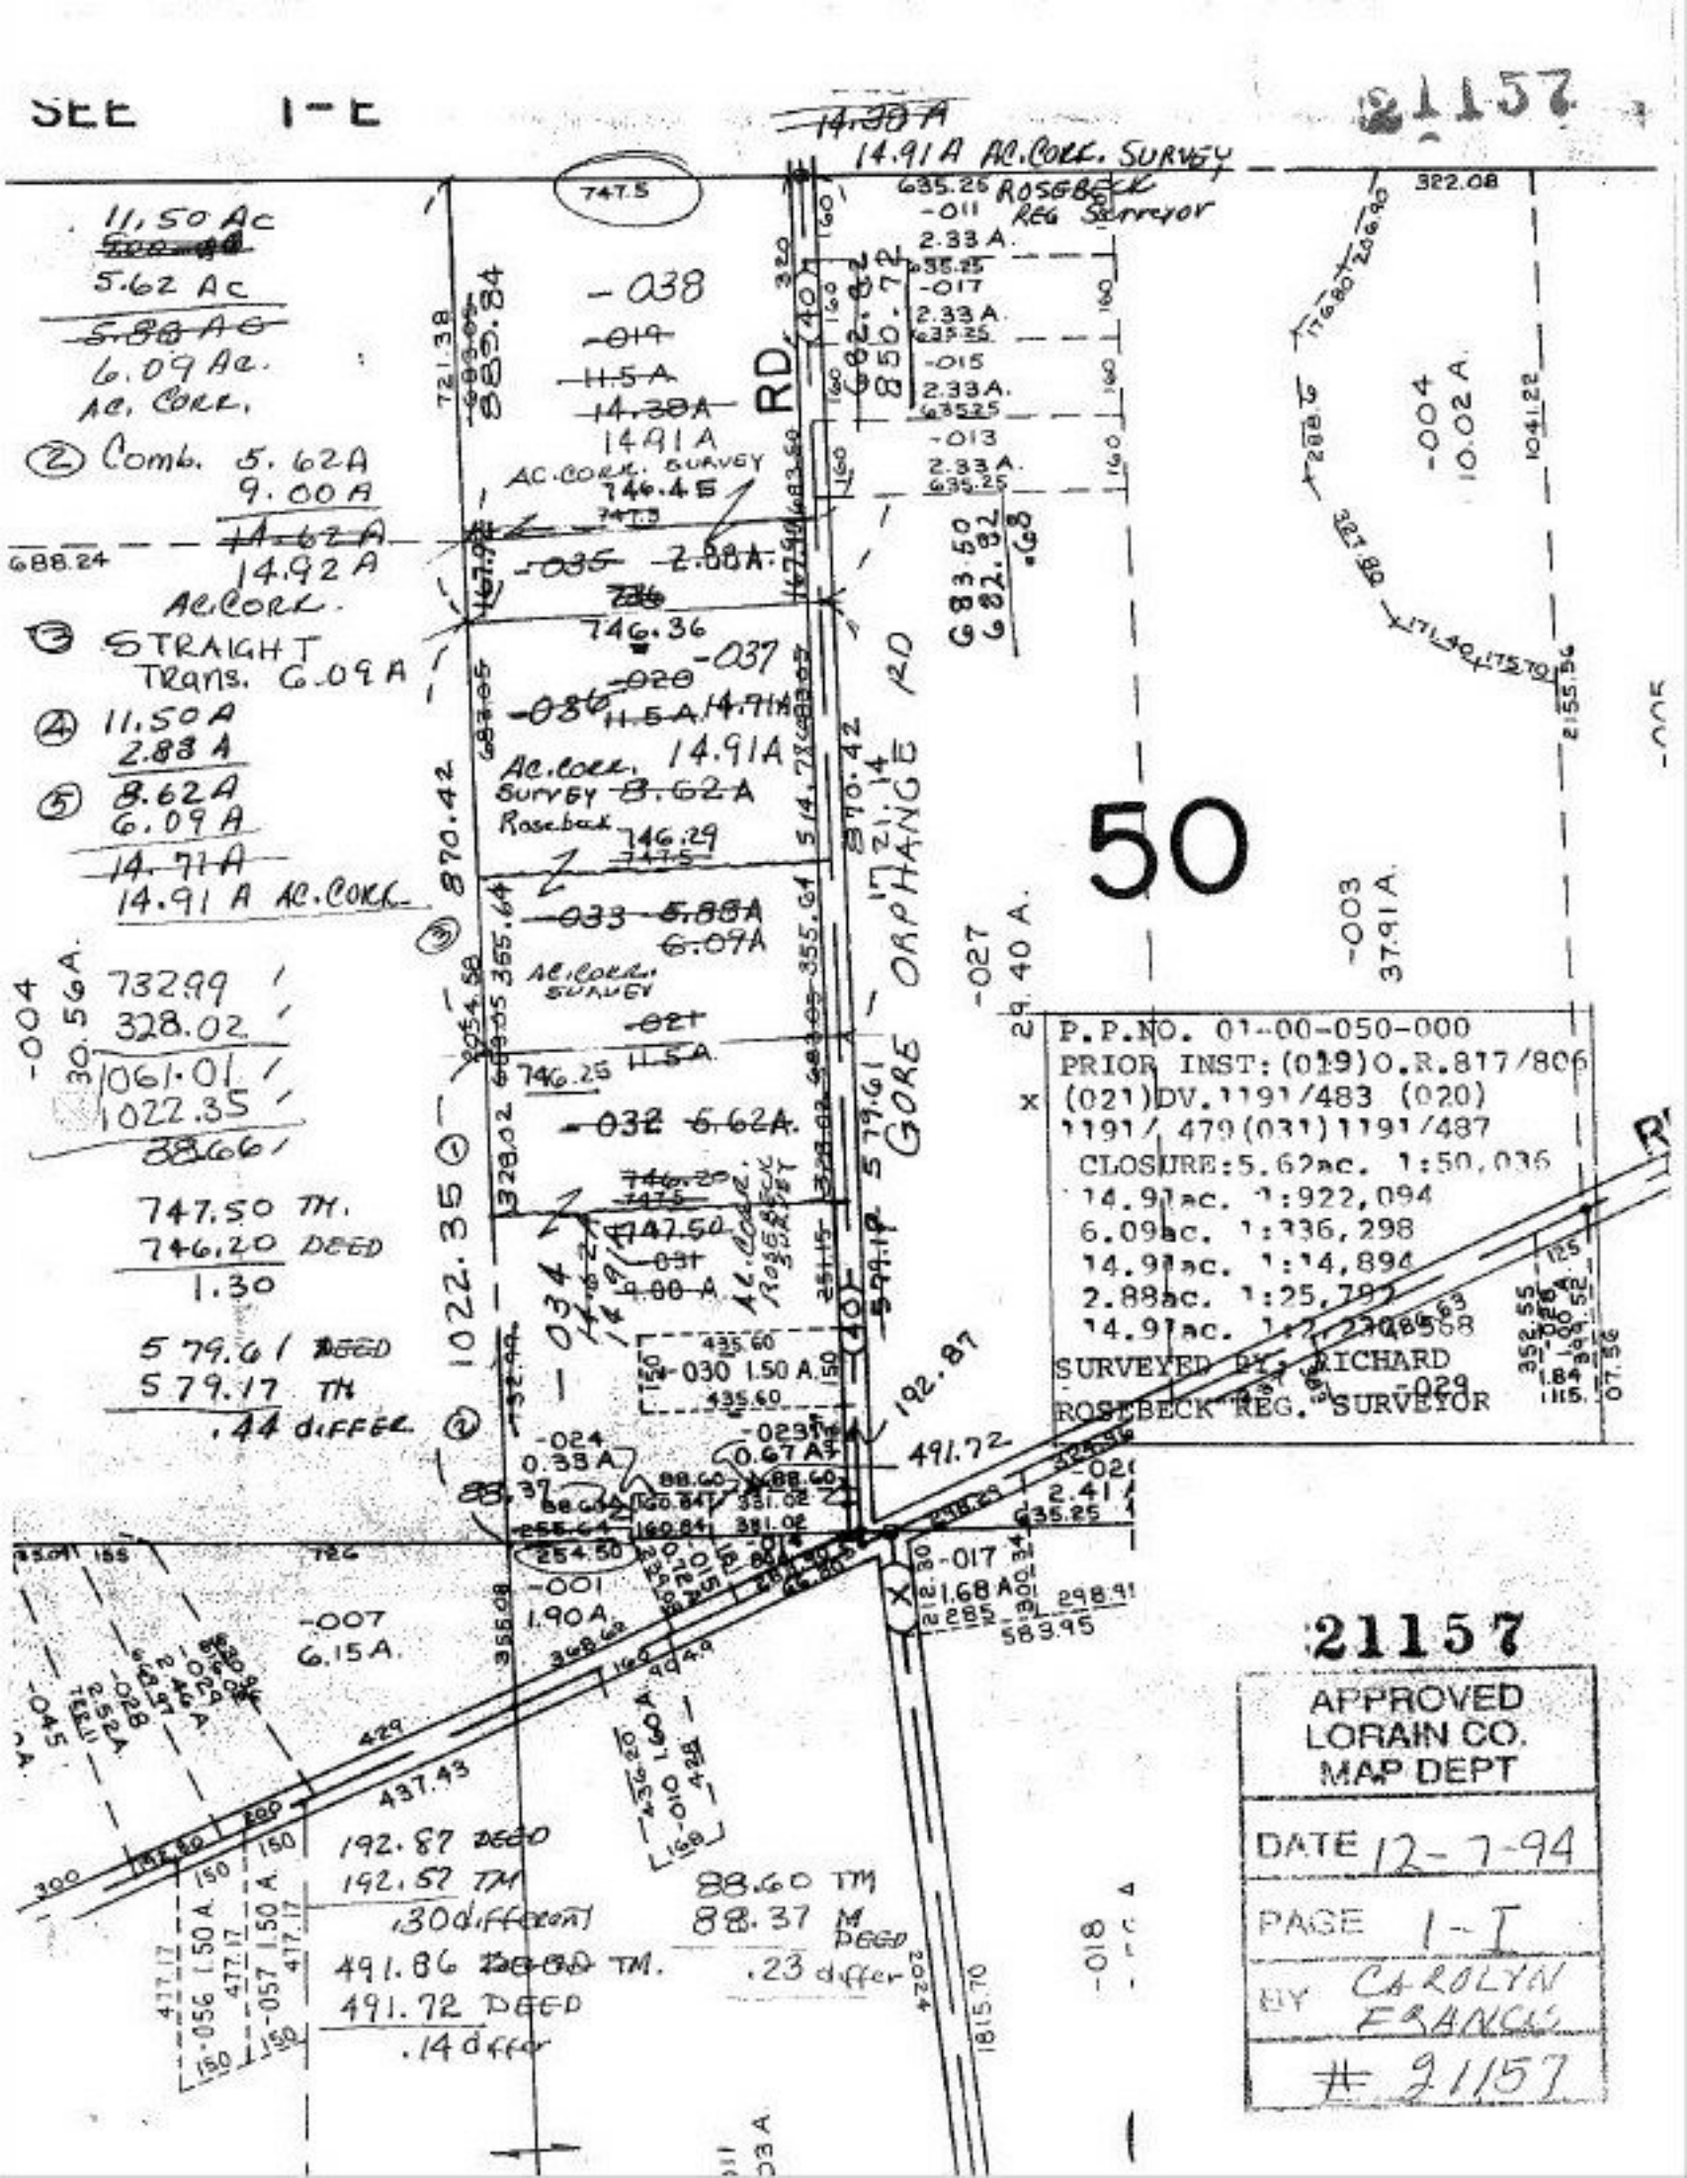
SEE 1-E
21157
14.91 A AC. CORR. SURVEY
ROSEBECK REG SURVEYOR
11.50 Ac
5.62 Ac
6.09 Ac.
AC. CORR.
② Comb. 5.62A
9.00 A
14.92 A
AC. CORR.
③ STRAIGHT TRANS. 6.09 A
④ 11.50 A
2.88 A
⑤ 8.62 A
6.09 A
14.91 A AC. CORR.
732.99
328.02
1061.01
1022.35
38.66
747.50 TM.
746.20 DEED
1.30
579.61 DEED
579.17 TM
.44 differ
-038
14.91 A
AC. CORR. SURVEY
746.45
-035
746.36
-037
14.91 A
AC. CORR. SURVEY
Rosebeck
746.29
-033
6.09 A
AC. CORR. SURVEY
746.25
-032
6.62 A
-034
-030 1.50 A.
-024
0.33 A
-023
0.67 A
-001
1.90 A
-007
6.15 A.
-017
1.68 A
-004
10.02 A
-003
37.91 A
-027
29.40 A.
GORE ORPHANGE RD
RD
50
P.P.NO. 01-00-050-000
PRIOR INST: (019) O.R. 817/806
(021) DV. 1191/483 (020)
1191/479 (031) 1191/487
CLOSURE: 5.62ac. 1:50,036
14.91ac. 1:922,094
6.09ac. 1:336,298
14.91ac. 1:14,894
2.88ac. 1:25,792
14.91ac. 1:2,230,568
SURVEYED BY: RICHARD
ROSEBECK REG. SURVEYOR
192.87 DEED
192.57 TM
.30 different
491.86 DEED TM.
491.72 DEED
.14 differ
88.60 TM
88.37 M DEED
.23 differ
21157
APPROVED
LORAIN CO.
MAP DEPT
DATE 12-7-94
PAGE 1-I
BY CAROLYN FRANCIS
21157