#21 166 -X

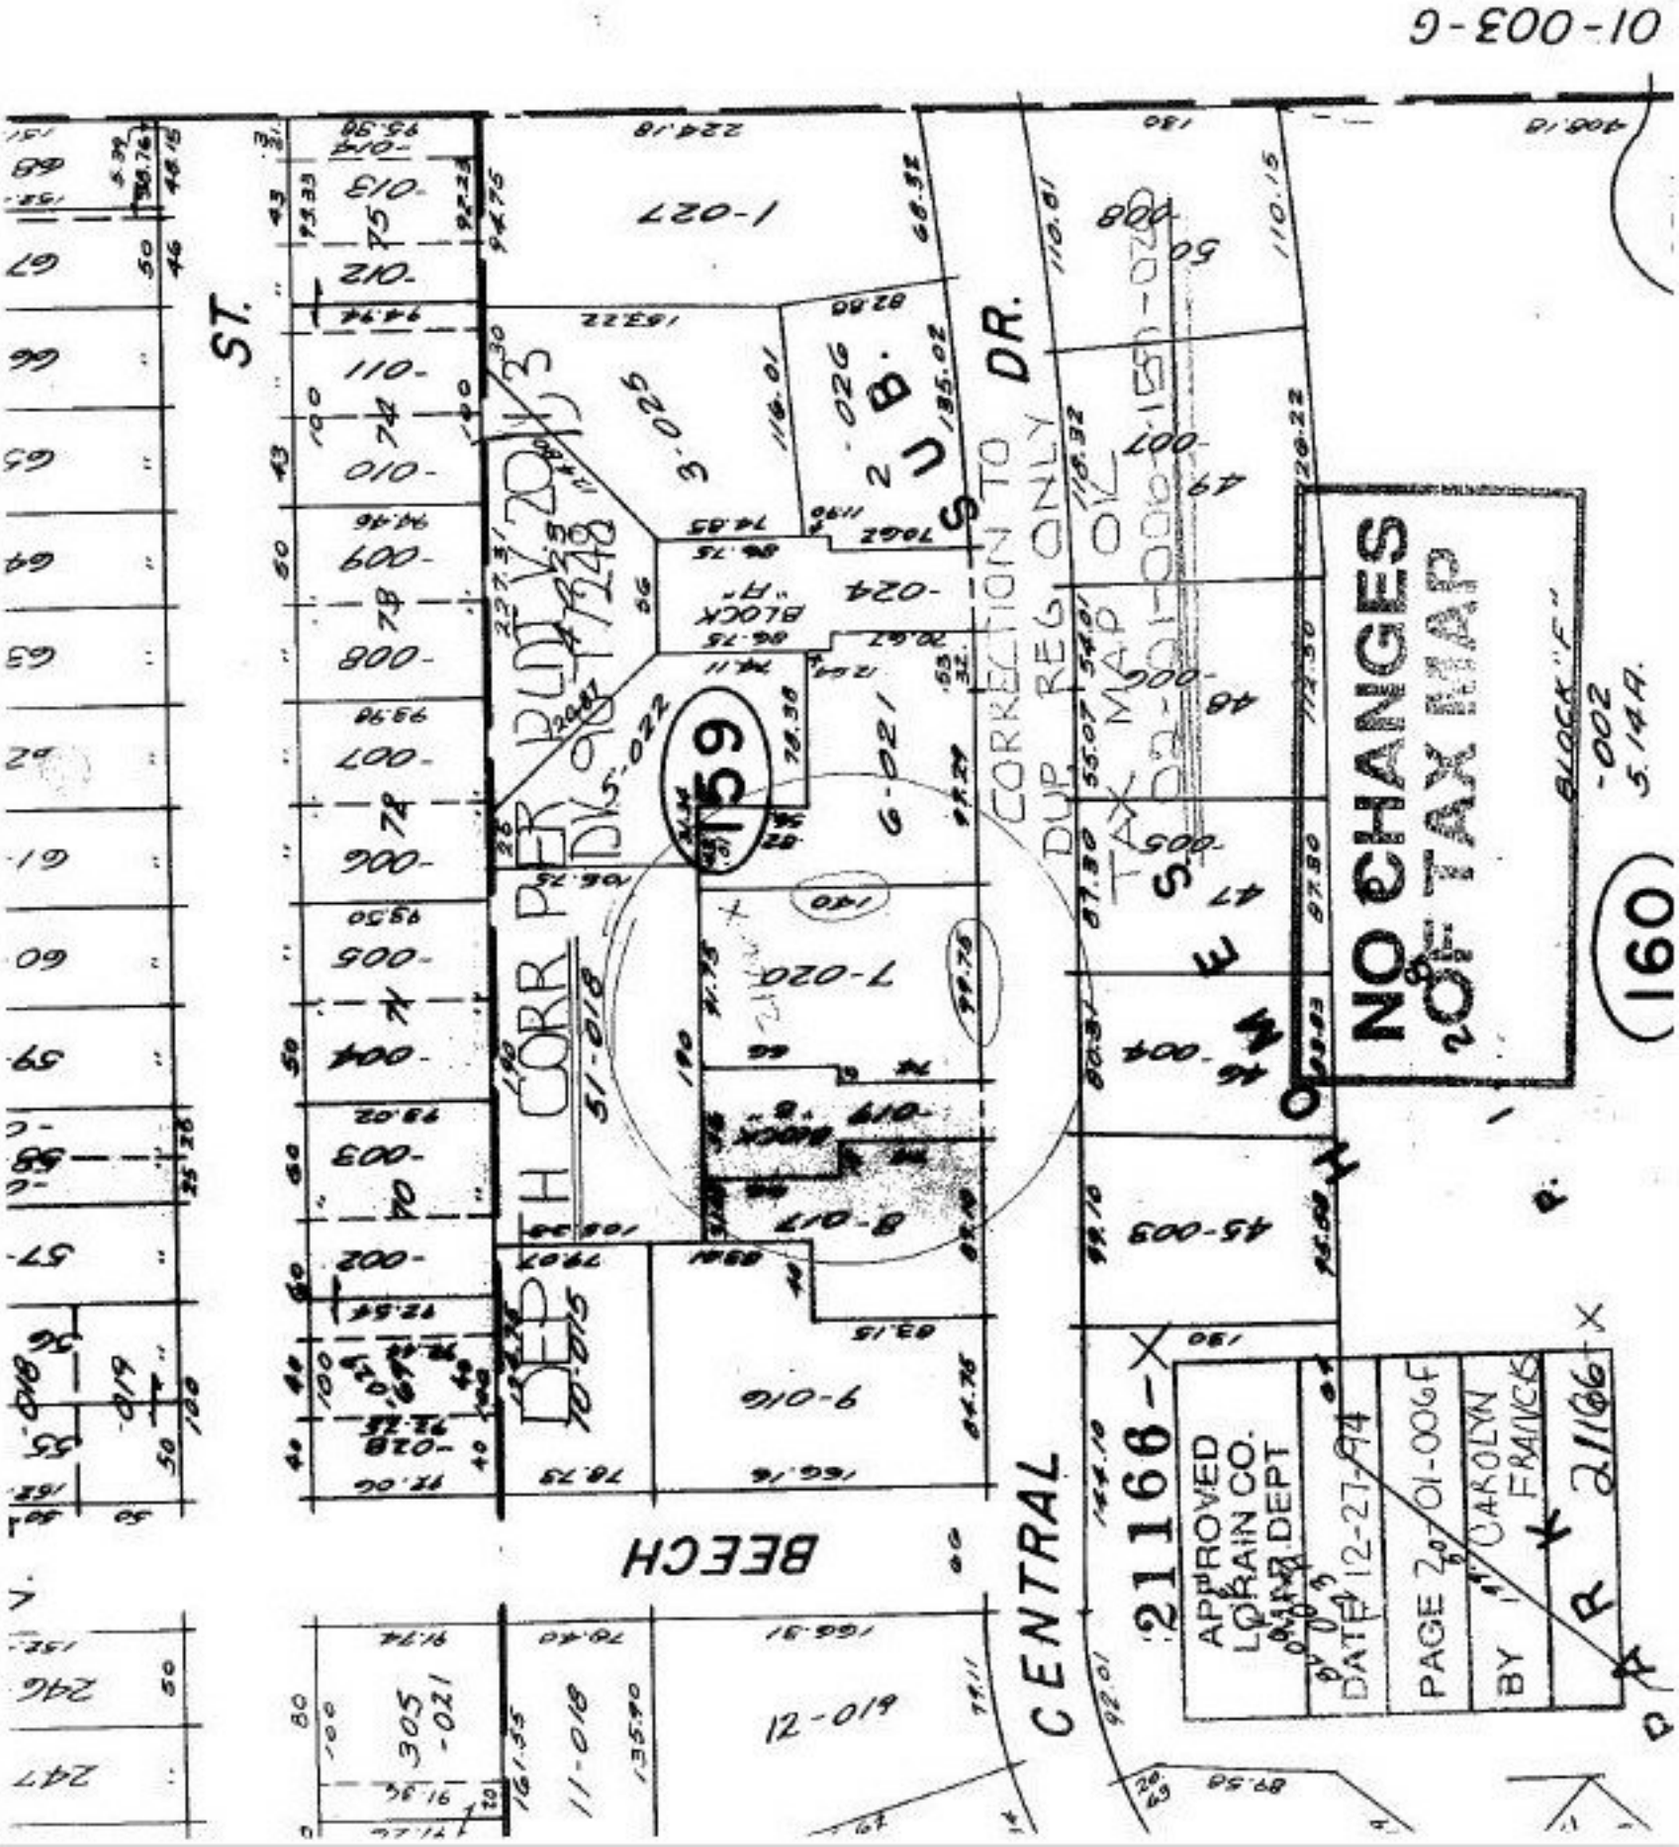

01-003-G
ST.
DR.
BEECH
CENTRAL
HOMES
SUB.
DEPTH CORR PER PUD V.20 1/3
DV 90-1/248
CORRECTION TO DUP. REG. ONLY
TAX MAP OK
159
160
NO CHANGES OF TAX MAP
BLOCK "F"
-002
5.14A.
21166-X
APPROVED
LORAIN CO.
MAP DEPT
DATE 12-27-94
PAGE 20-01-006F
BY CAROLYN FRANCIS
21166-X