21168

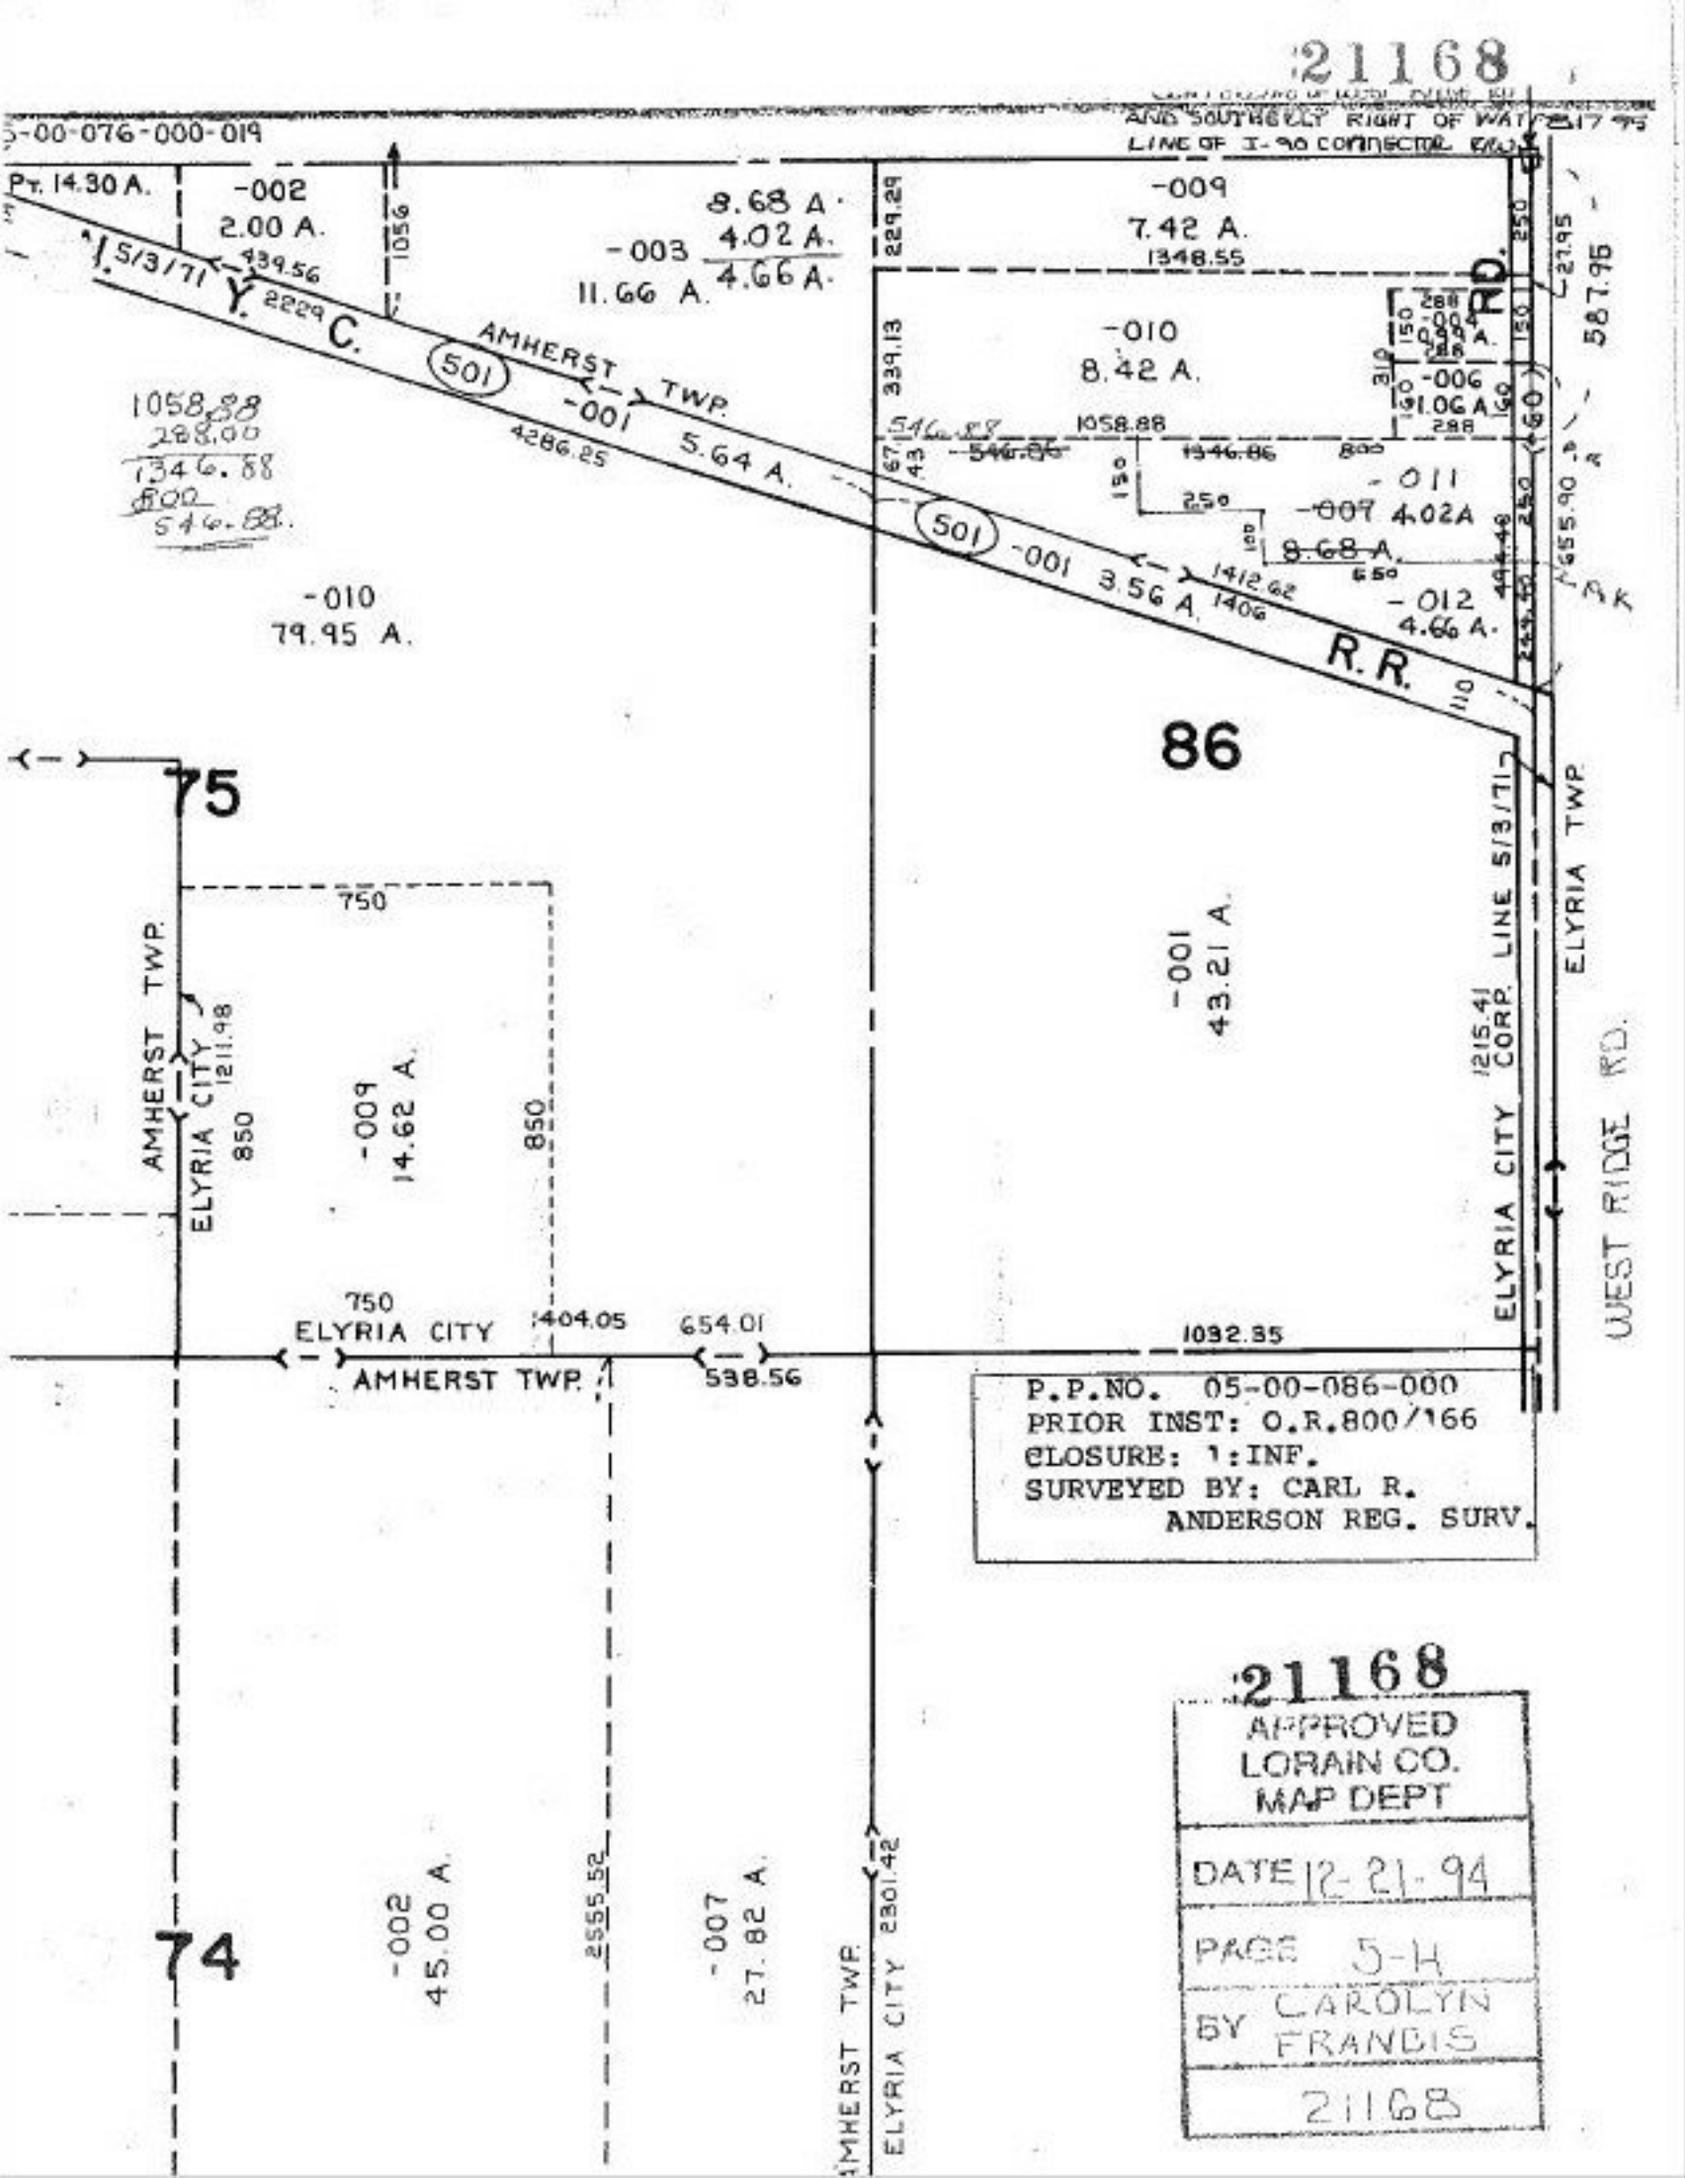

21168

APPROVED
LORAIN CO.
MAP DEPT

DATE 12-21-94

PAGE 5-H

BY CAROLYN FRANDIS

21168