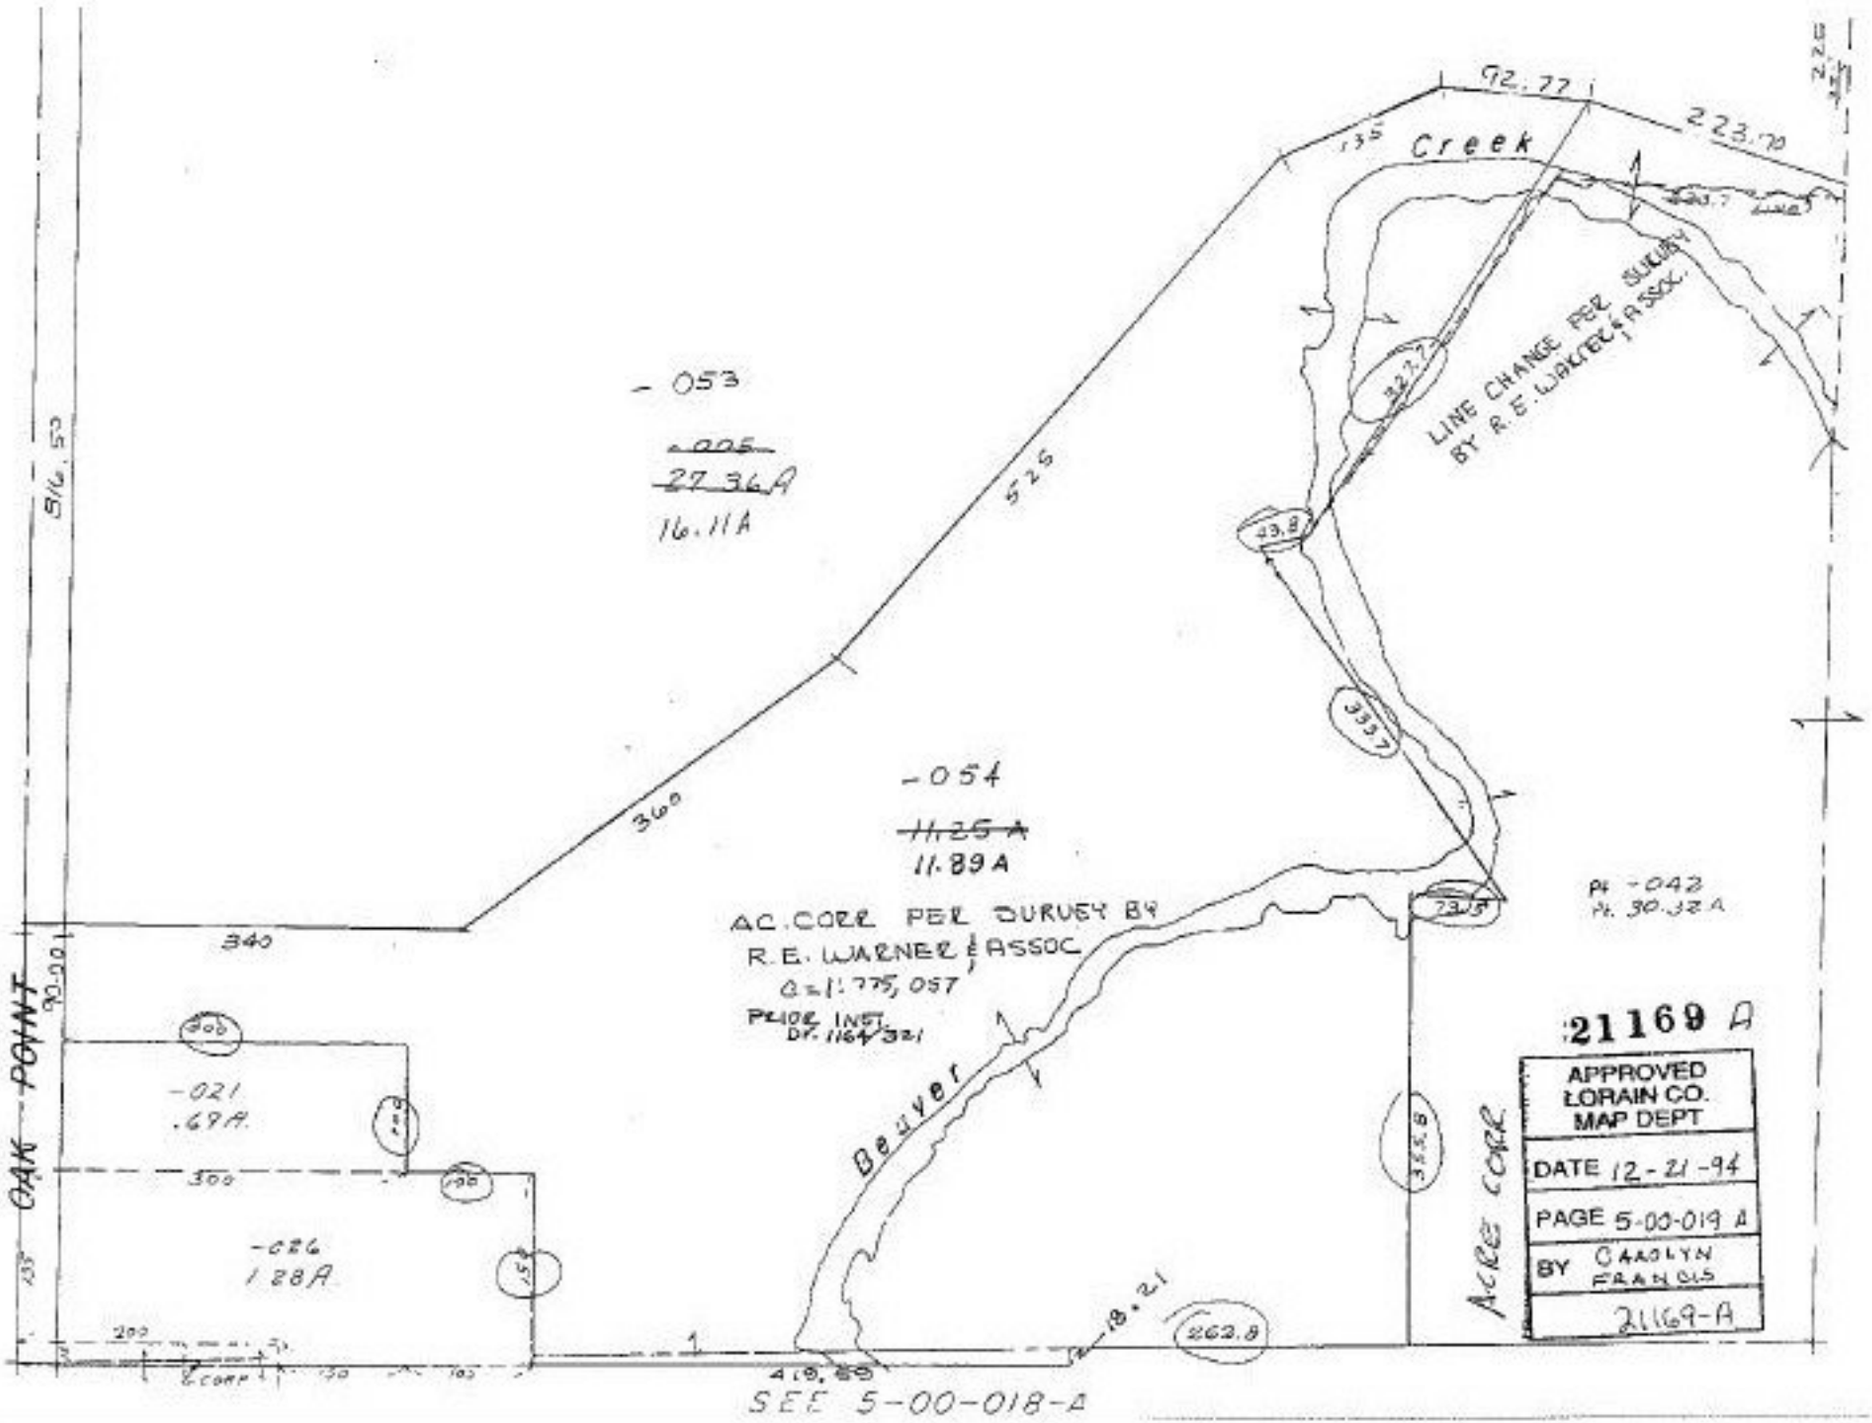
S/L 53
OAK POINT
33'
-053
-005
27.36A
16.11A
525
360
340
-054
11.25A
11.89A
AC. CORR PER SURVEY BY
R.E. WARNER & ASSOC.
Q=1.775,057
PRIOR INST.
DV. 1164/321
-021
.69A.
-026
1.28A
300
200
Beaver
Creek
92.77
223.70
LINE CHANGE PER SURVEY BY R.E. WARNER & ASSOC.
323.7
333.7
23.8
23.5
355.8
262.8
418.89
18.21
-042
Pt. 30.32A
ACRES CORR.
21169 A
APPROVED
LORAIN CO.
MAP DEPT
DATE 12-21-94
PAGE 5-00-019 A
BY CAROLYN FRANCIS
21169-A
SEE 5-00-018-A

21169-A