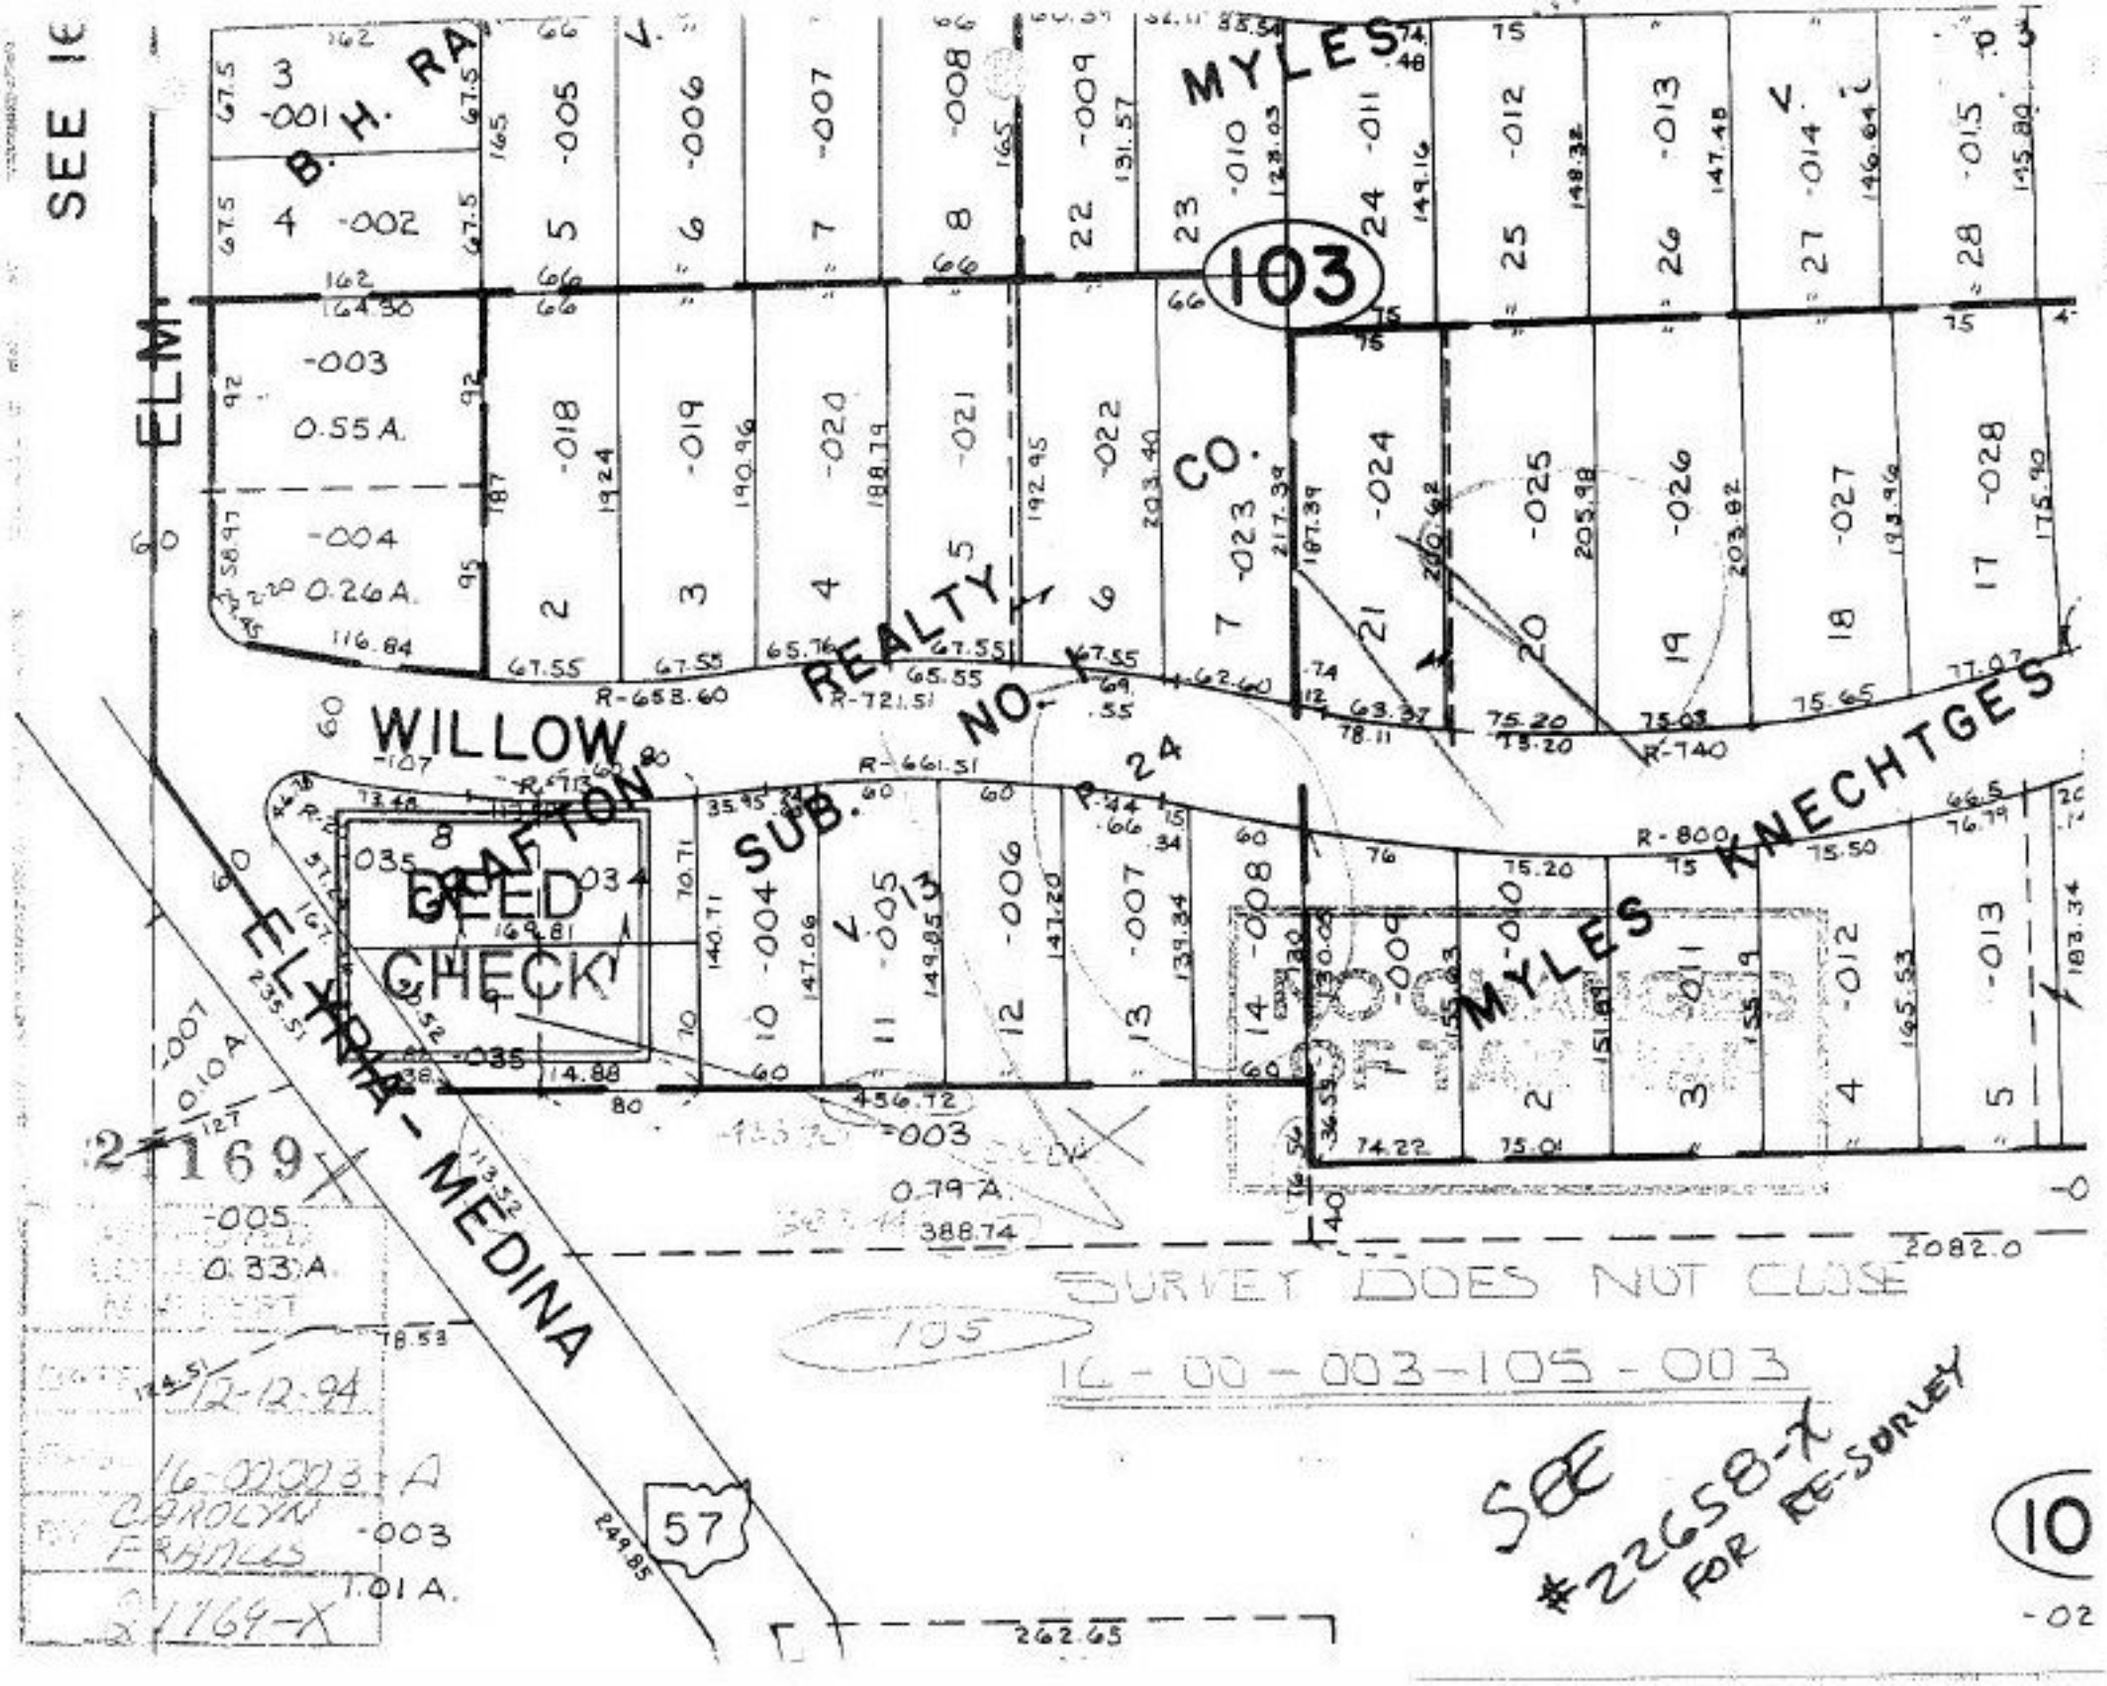
SEE 16
B. H. RA
ELM
WILLOW
GRAFTON
REALTY
NO. 1
CO.
SUB.
MYLES
KNECHTGES
103
ELYRIA - MEDINA
57
2169
0.33 A.
0.26 A.
0.55 A.
0.79 A.
1.01 A.
SURVEY DOES NOT CLOSE
105
16-00-003-105-003
12-12-94
16-00003.A
CAROLYN ERMILES
2169-X
SEE #22658-X FOR RE-SURVEY
10
-02