21169

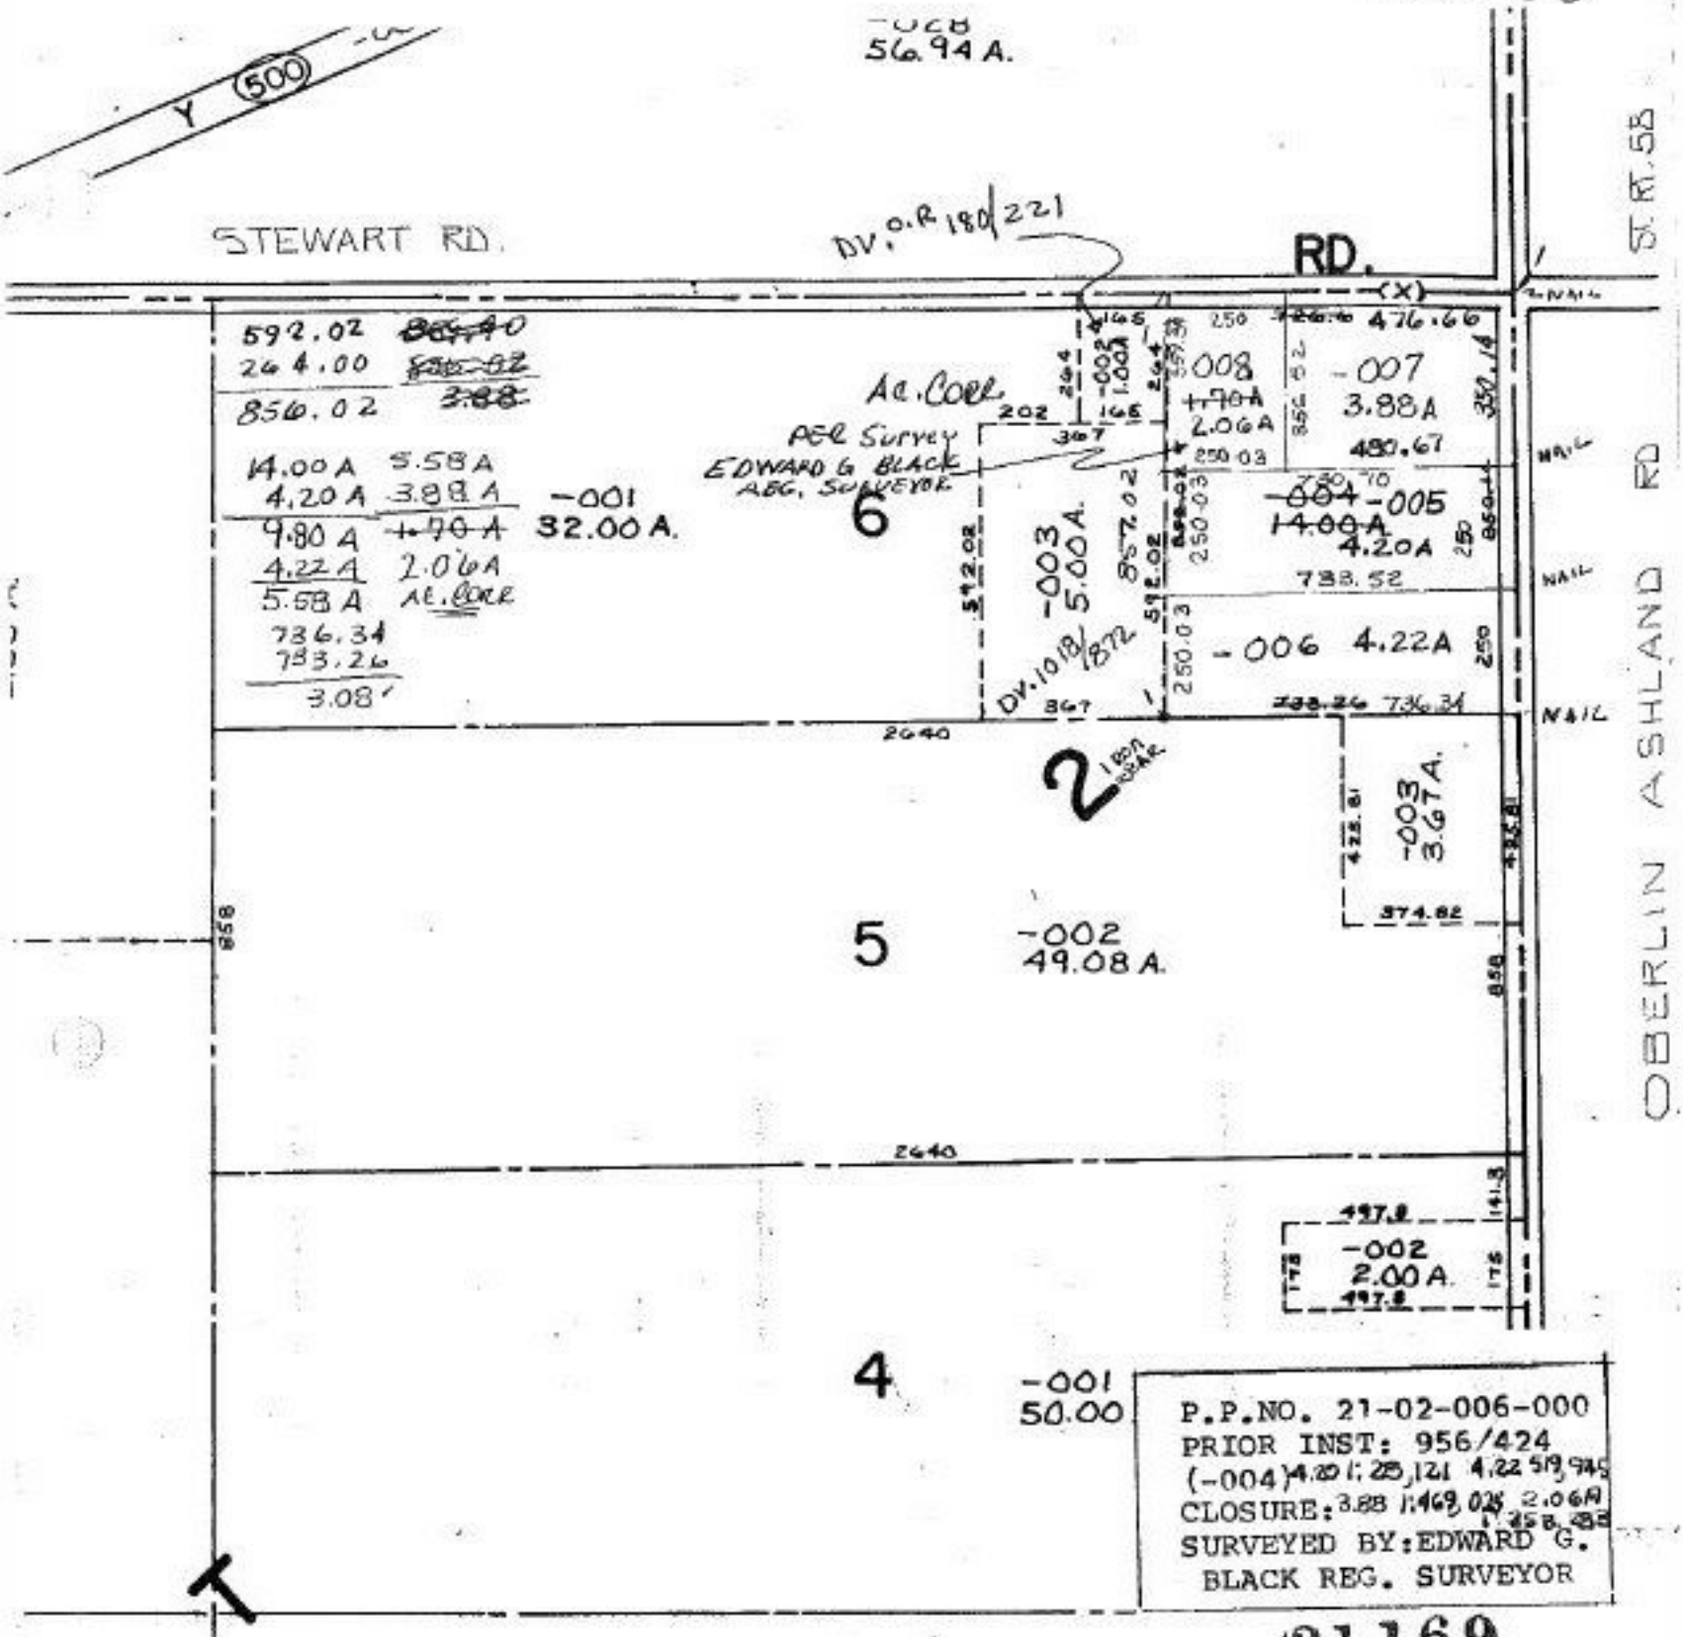

P.P.NO. 21-02-006-000
PRIOR INST: 956/424
(-004) 4.20 1:28,121 4.22 519,945
CLOSURE: 3.88 1:469,025 2.06A 1:258,283
SURVEYED BY: EDWARD G. BLACK REG. SURVEYOR

21169

APPROVED
LORAIN CO.
MAP DEPT

DATE 12-21-94

PAGE 21-F

BY CAROLYN FRANCIS

#21169