ORD. NO. 3023-94

AN ORDINANCE VACATING THE TWELVE (12) FOOT ALLEY OF BLOCK 7 IN THE RIDGEVILLE HEIGHTS NO. 2 from MONROE AVE. TO MADISON AVE. BETWEEN WASHINGTON AVE. & LINCOLN AVE.

SEE 7-00-008-C

VACATION ORD. NO. 3023-94
11-21-94

ORD. NO. 3024-94

an ord. vacating the 12 ft. ALLEY OF BLOCK 8 in the RIDGEVILLE HEIGHTS NO. 2 FROM MONROE AVE. TO MADISON AVE. BETWEEN LINCOLN AVE. AND HARDING AVE.

VACATING ORD. NO. 3024-94
11-21-94

21172-V

APPROVED
LORAIN CO.
MAP DEPT

DATE 1-5-95

PAGE 7-00-009-A

BY CAROLYN FRANCIS

21172-V
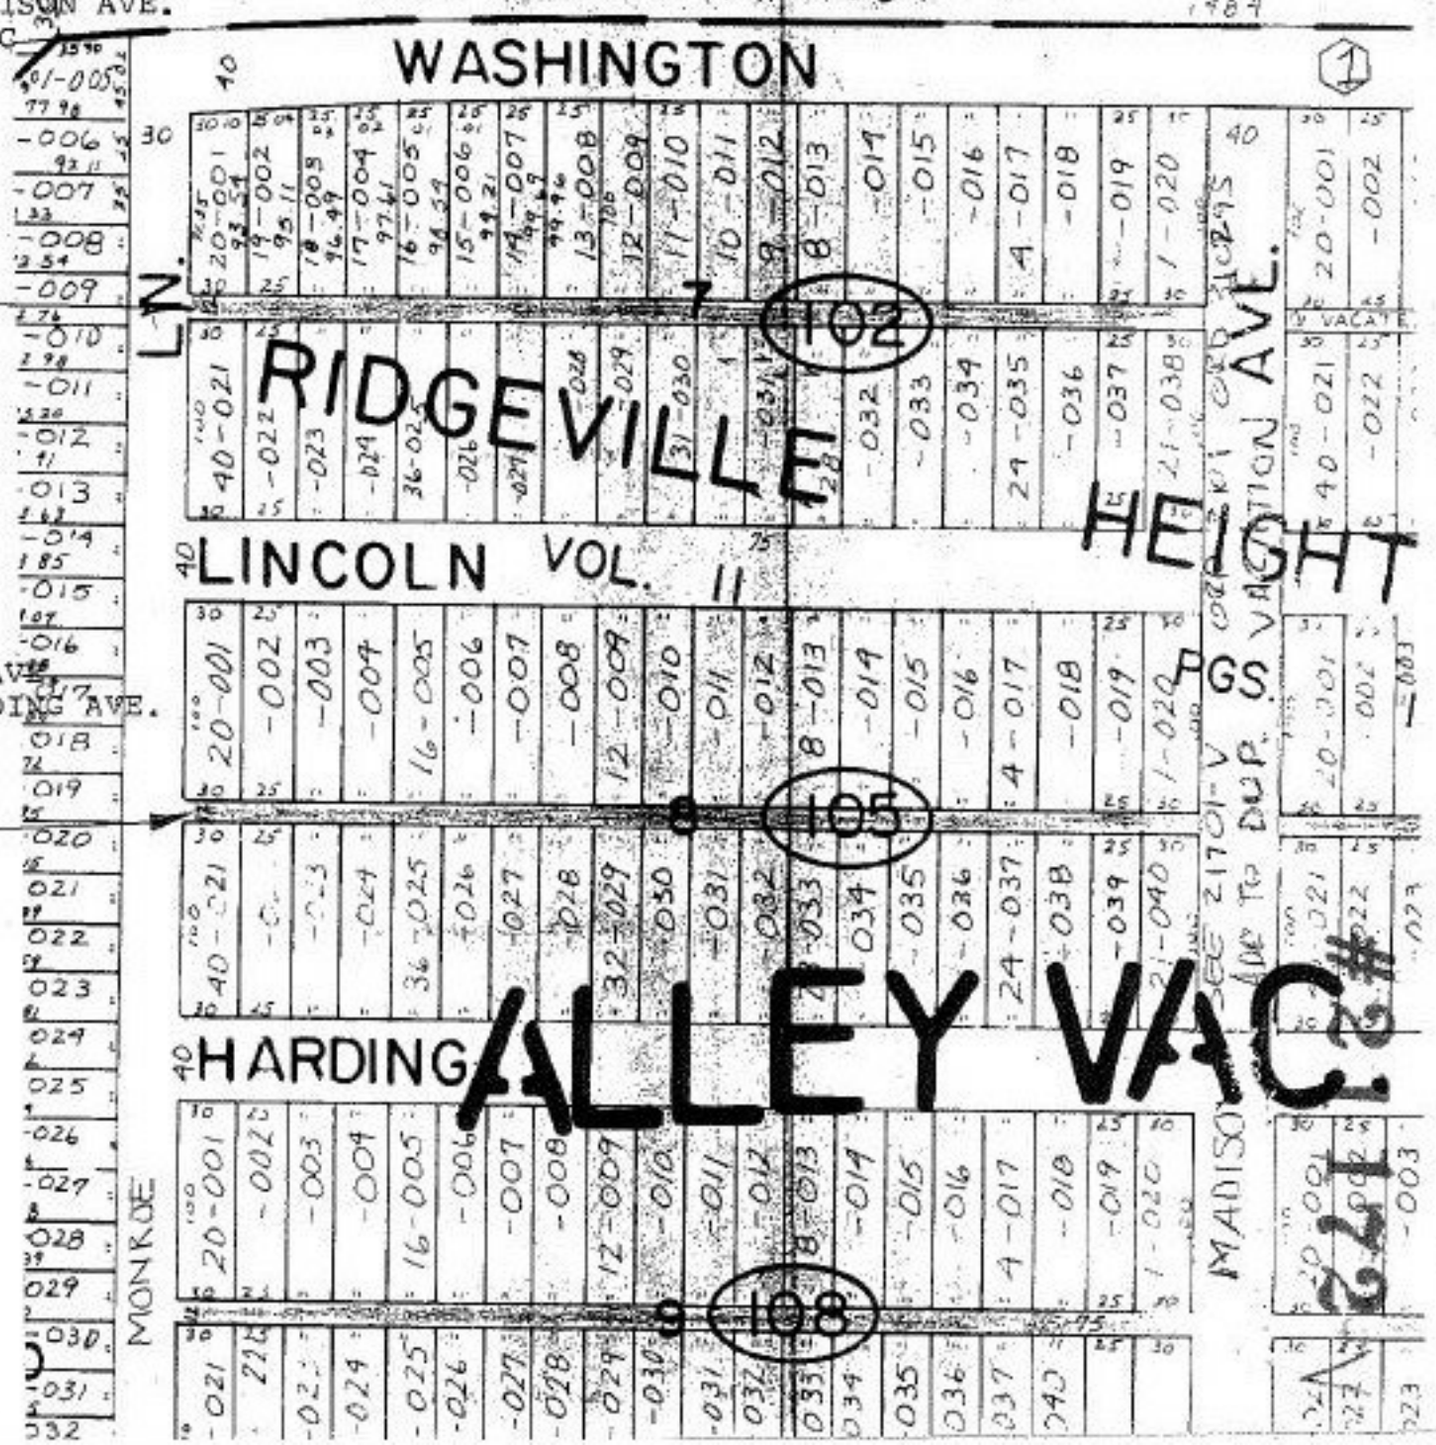
* SEE 21822-V