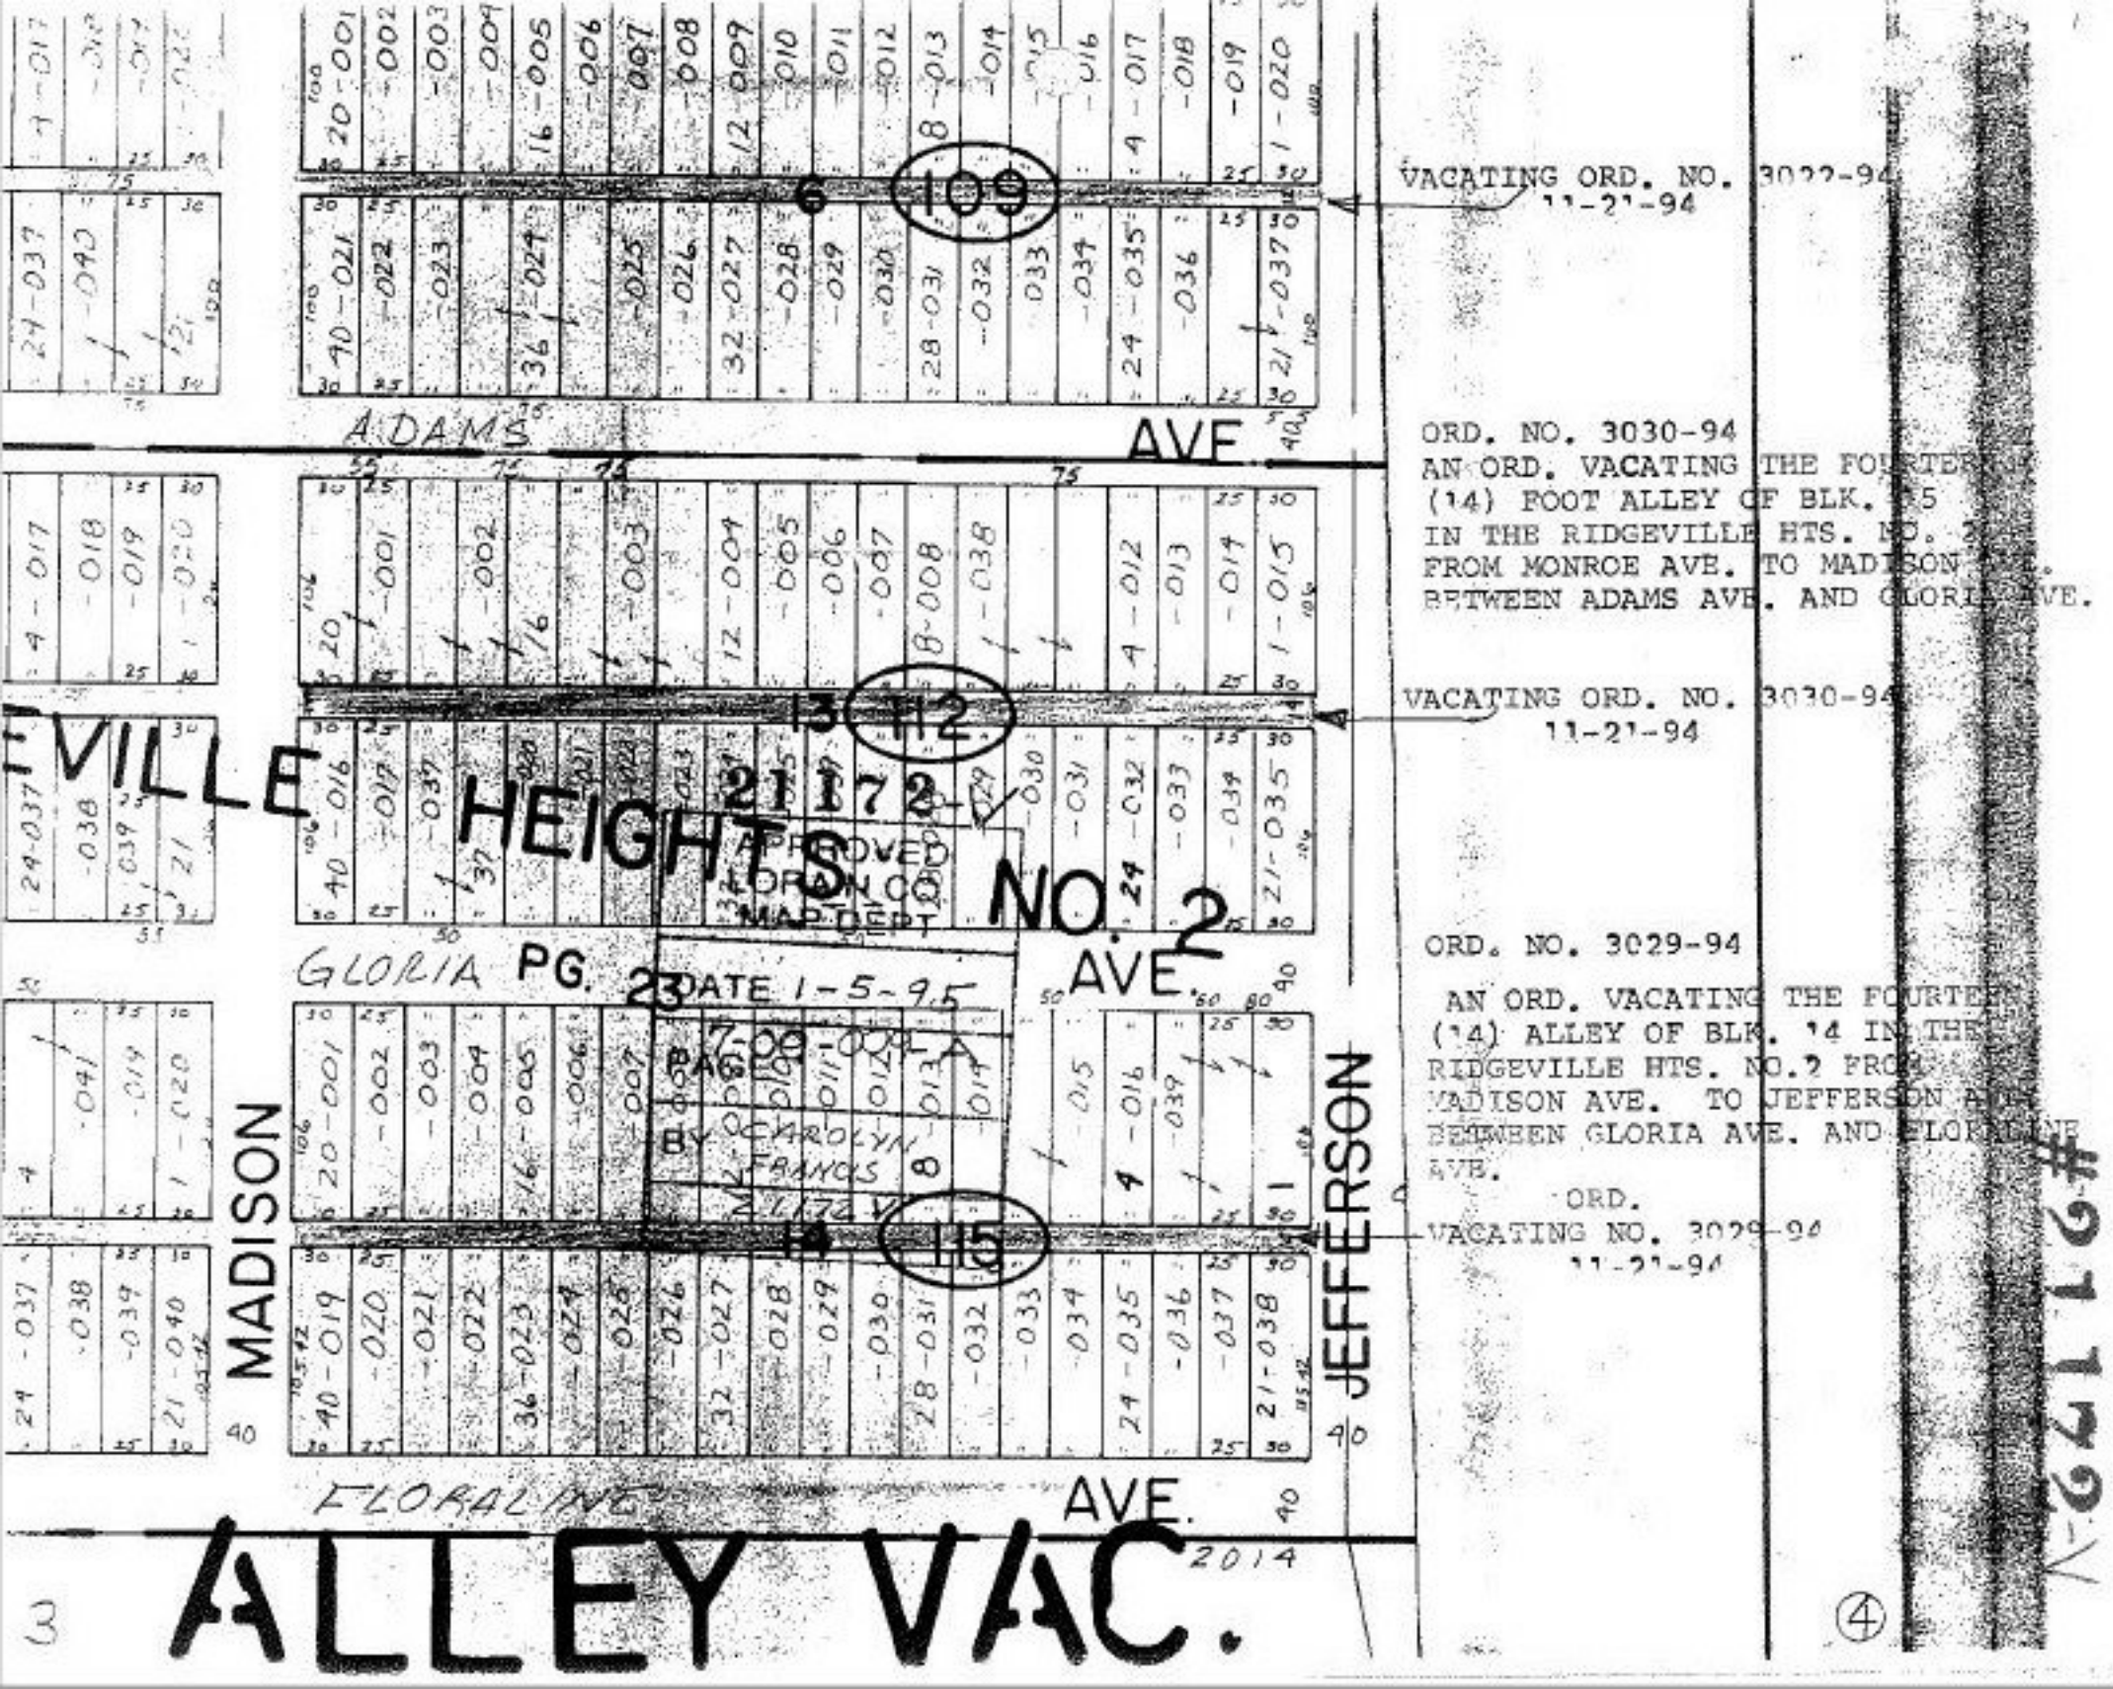
VACATING ORD. NO. 3022-94
11-21-94
ADAMS AVE.
ORD. NO. 3030-94
AN ORD. VACATING THE FOURTEEN (14) FOOT ALLEY OF BLK. 15 IN THE RIDGEVILLE HTS. NO. 2 FROM MONROE AVE. TO MADISON AVE. BETWEEN ADAMS AVE. AND GLORIA AVE.
VACATING ORD. NO. 3030-94
11-21-94
RIDGEVILLE HEIGHTS NO. 2
APPROVED FOR RECORD MAP DEPT
DATE 1-5-95
PAGE
BY
GLORIA AVE.
ORD. NO. 3029-94
AN ORD. VACATING THE FOURTEEN (14) ALLEY OF BLK. 14 IN THE RIDGEVILLE HTS. NO. 2 FROM MADISON AVE. TO JEFFERSON AVE. BETWEEN GLORIA AVE. AND FLORALINE AVE.
ORD.
VACATING NO. 3029-94
11-21-94
MADISON
JEFFERSON
FLORALINE AVE.
2014
ALLEY VAC.
#9179
(3)
(4)