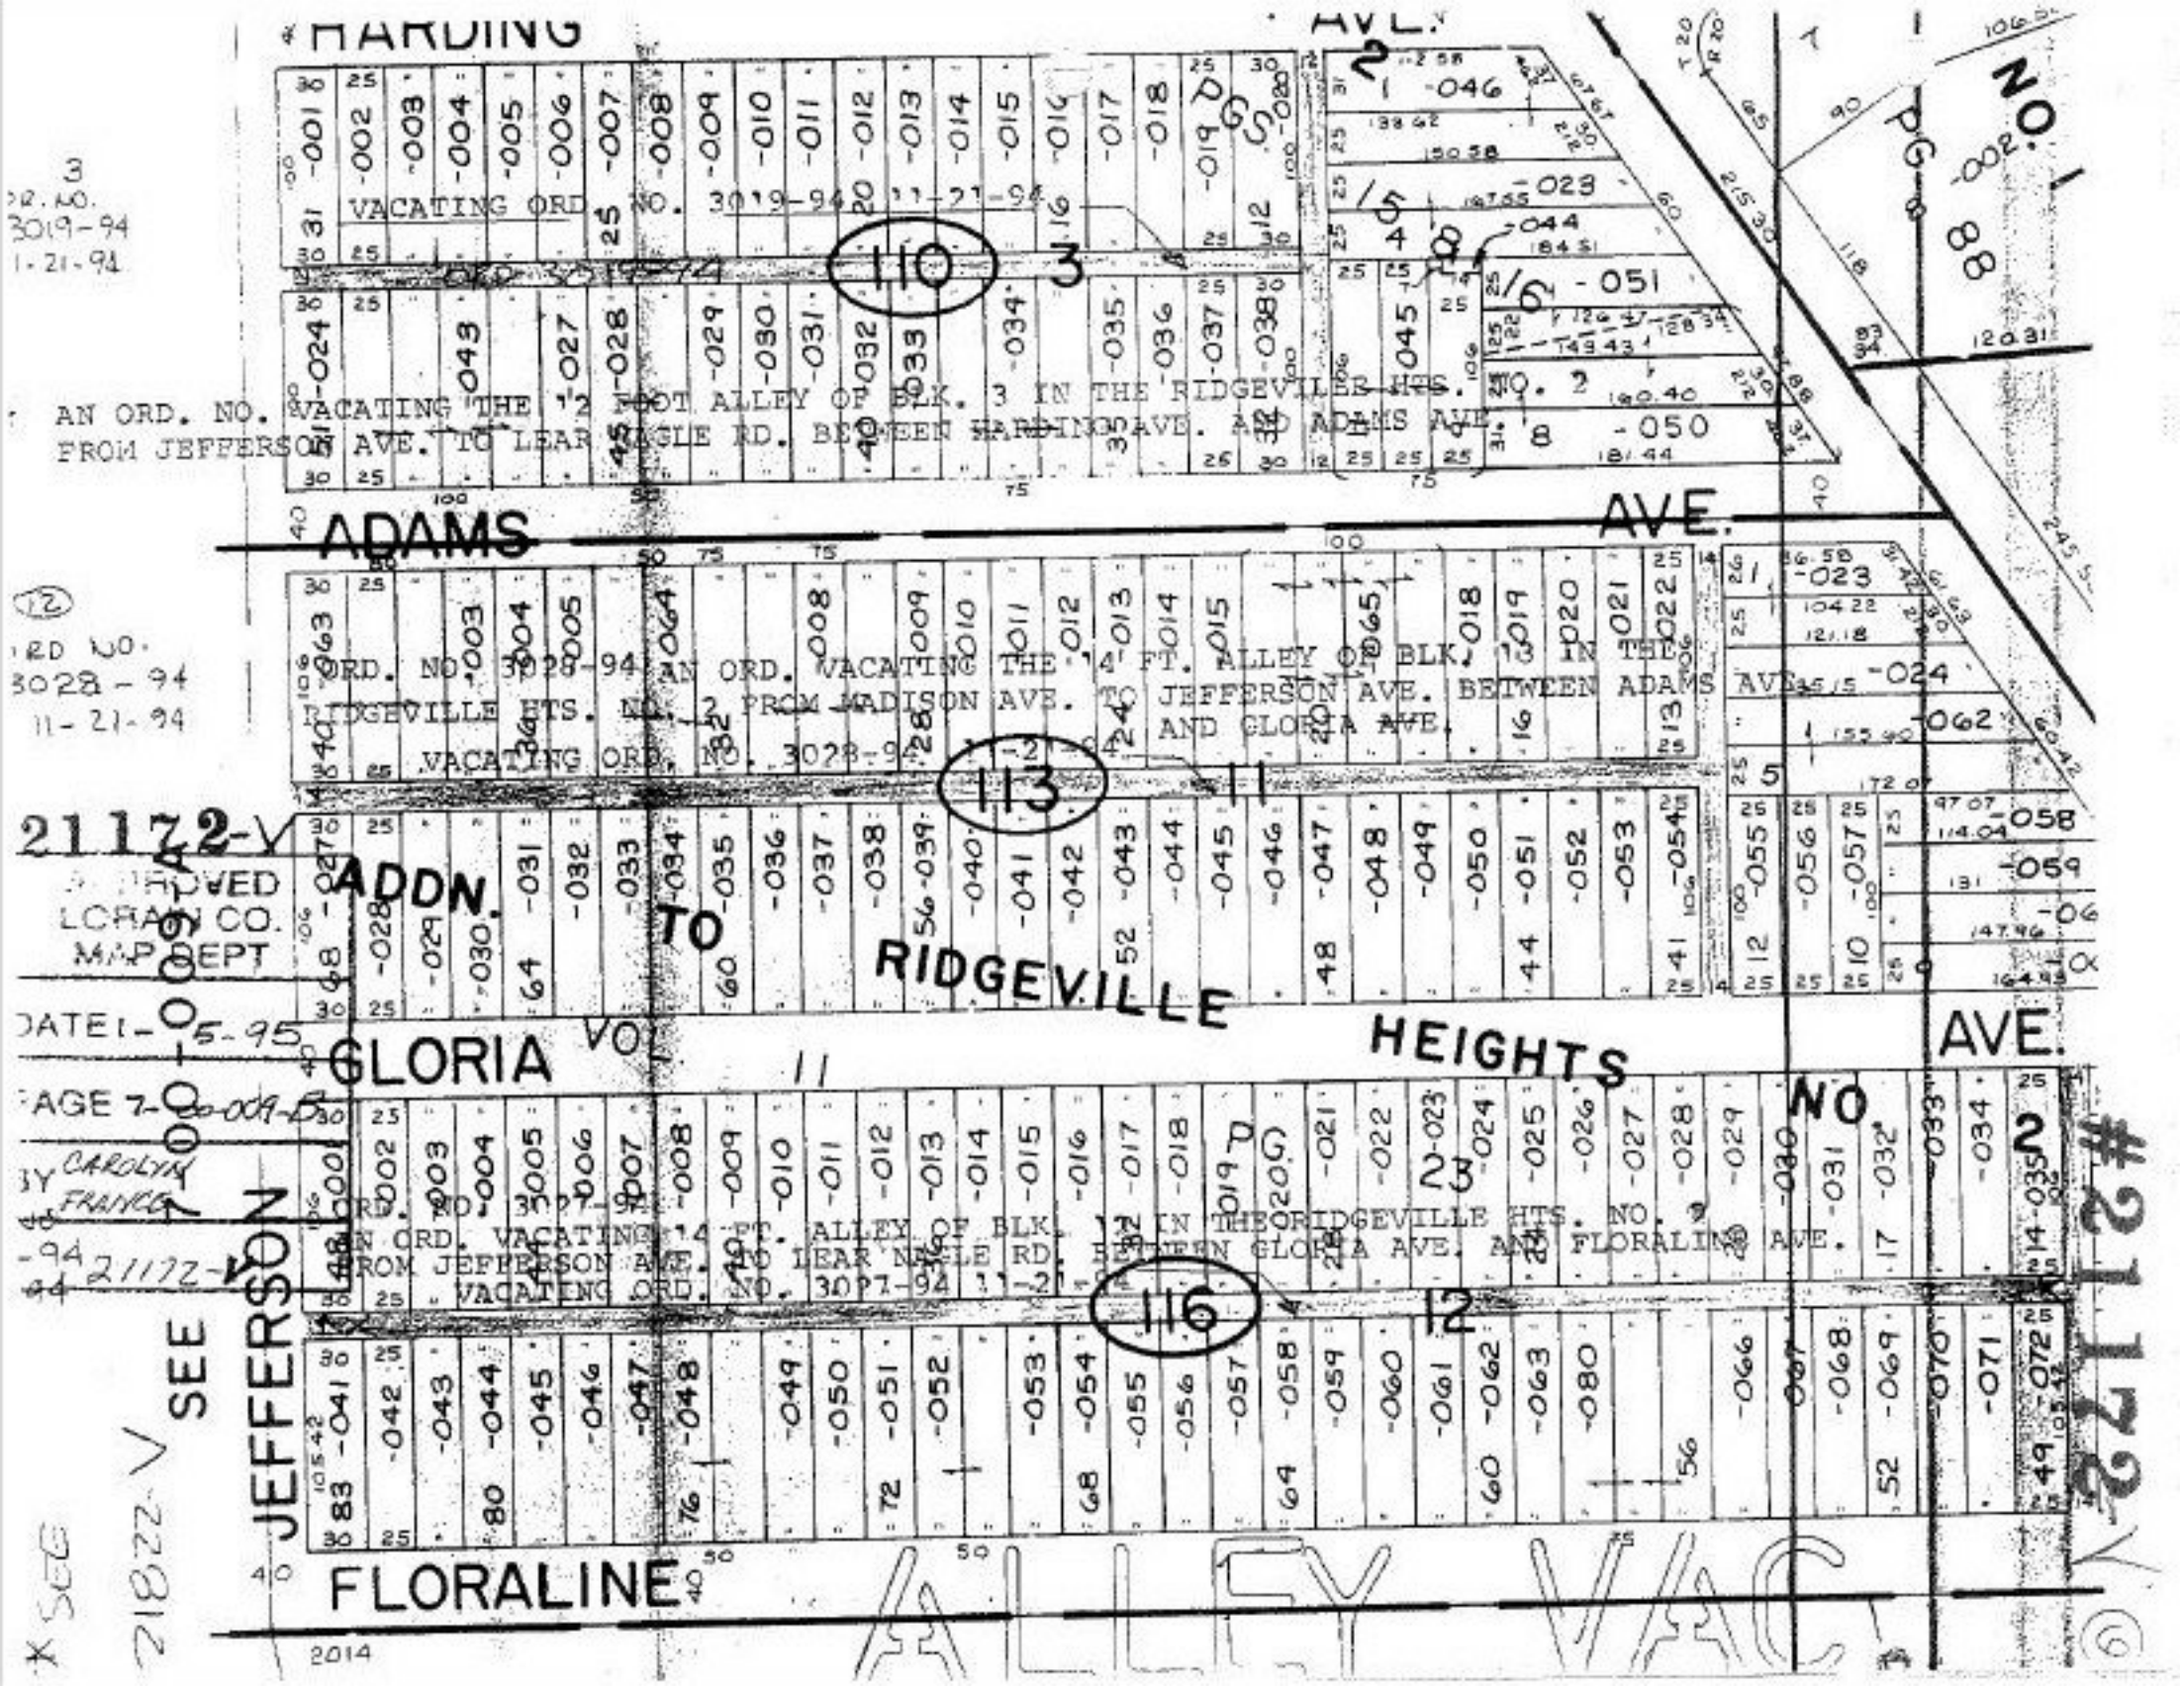
HARDING AVE.
VACATING ORD. NO. 3019-94 11-21-94
AN ORD. NO. VACATING THE 12 FOOT ALLEY OF BLK. 3 IN THE RIDGEVILLE HTS. NO. 2 FROM JEFFERSON AVE. TO LEAR NAGLE RD. BETWEEN HARDING AVE. AND ADAMS AVE.
ADAMS AVE.
ORD. NO. 3028-94 AN ORD. VACATING THE 14 FT. ALLEY OF BLK. 13 IN THE RIDGEVILLE HTS. NO. 2 FROM MADISON AVE. TO JEFFERSON AVE. BETWEEN ADAMS AVE. AND GLORIA AVE.
VACATING ORD. NO. 3028-94 11-21-94
ADDN. TO RIDGEVILLE HEIGHTS NO. 2
GLORIA AVE.
ORD. NO. 3027-94 AN ORD. VACATING 14 FT. ALLEY OF BLK. 12 IN THE RIDGEVILLE HTS. NO. 2 FROM JEFFERSON AVE. TO LEAR NAGLE RD. BETWEEN GLORIA AVE. AND FLORALINE AVE.
VACATING ORD. NO. 3027-94 11-21-94
JEFFERSON
FLORALINE
ALLEY VAC.
NO. 1
PG. 88
110
113
116
21172-V
APPROVED LORAIN CO. MAP DEPT
DATE 1-5-95
PAGE 7-00-009-B
BY CAROLYN FRANCE
21172-V
SEE 21822-V
#21172-V
2014