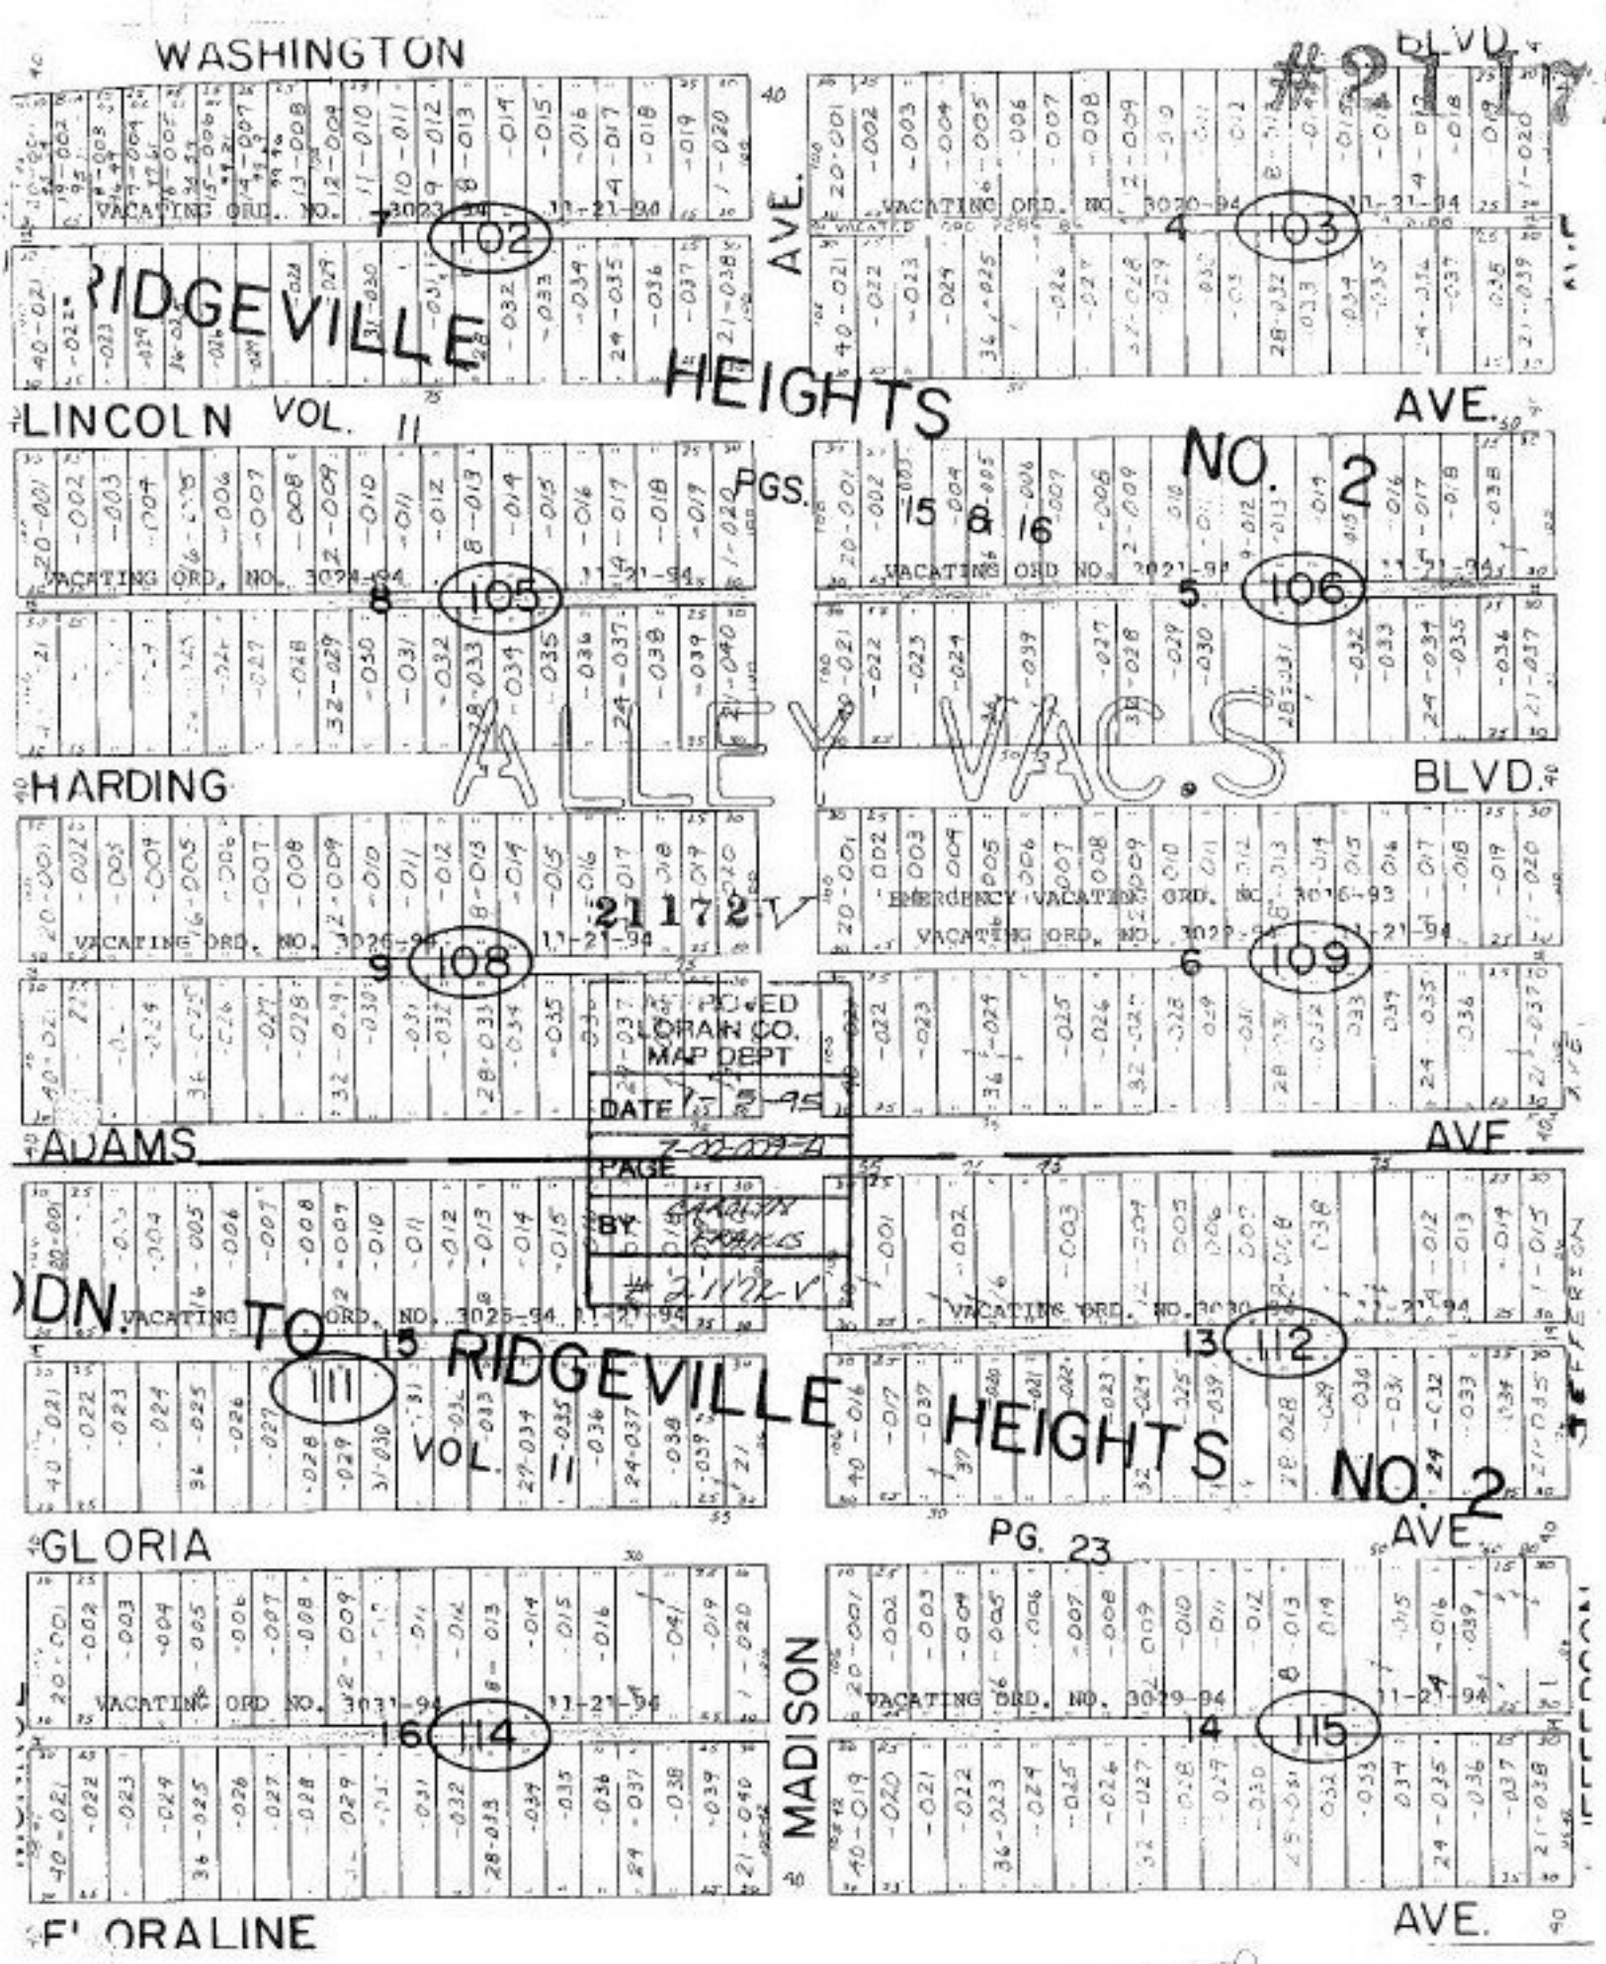
WASHINGTON
BLVD.
AVE.
VACATING ORD. NO. 3023-94 11-21-94
VACATING ORD. NO. 3030-94 11-21-94
RIDGEVILLE HEIGHTS
LINCOLN
VOL. 11 PGS. 15 & 16
NO. 2
VACATING ORD. NO. 3024-94 11-21-94
VACATING ORD NO. 3021-94
ALLEY VACATED
HARDING
BLVD.
21172-V
EMERGENCY VACATING ORD. NO. 3027-94 11-21-94
VACATING ORD. NO. 3026-94 11-21-94
VACATING ORD. NO. 3025-94 11-21-94
DATE 1-2-95
7-02.09-A
PAGE
BY
21172-V
ADAMS
AVE
VACATING ORD. NO. 3030-94 11-21-94
TO 15 RIDGEVILLE HEIGHTS NO. 2
VOL. 11
GLORIA
PG. 23
AVE
VACATING ORD NO. 3031-94 11-21-94
VACATING ORD. NO. 3029-94 11-21-94
MADISON
AVE.
FLORALINE
REDUCED