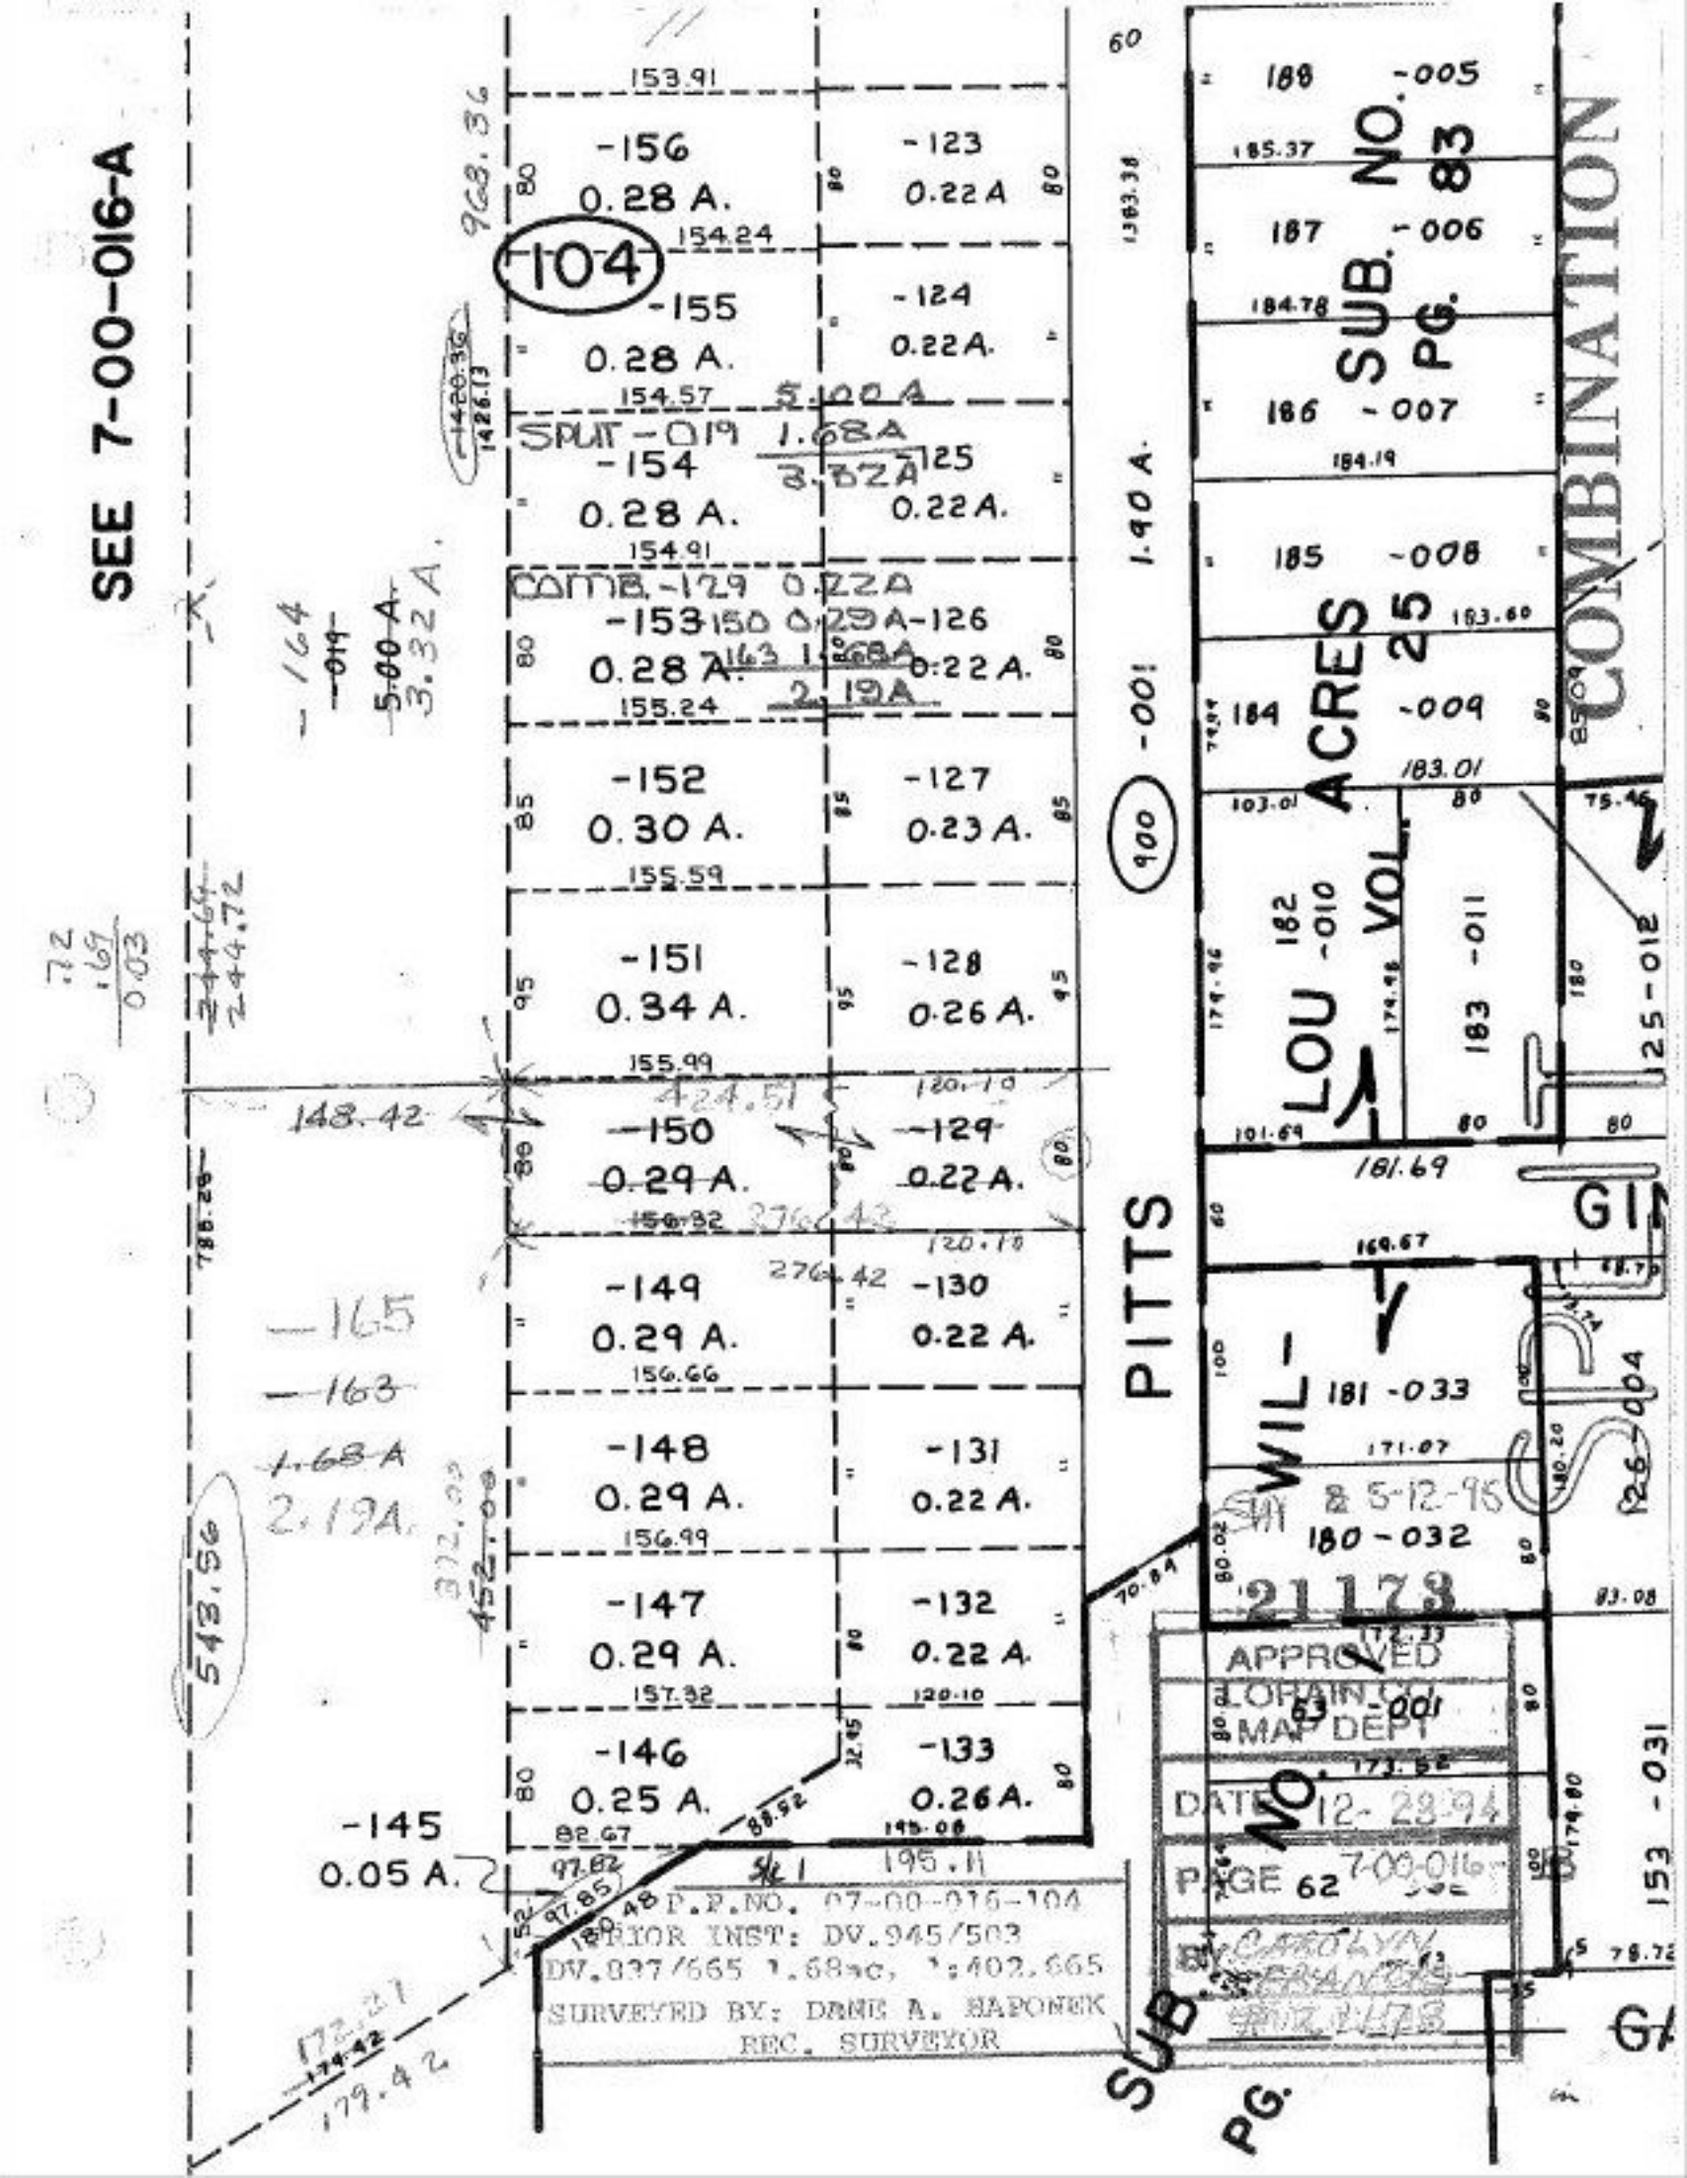
SEE 7-00-016-A
104
-156
0.28 A.
-123
0.22 A
-155
0.28 A.
-124
0.22 A.
SPLIT -019 1.68A
3.32A
-154
0.28 A.
-125
0.22 A.
COMB. -129 0.22A
-153 150 0.29A -126
0.28 A. 163 1.68A 0.22 A.
2.19A
-152
0.30 A.
-127
0.23 A.
-151
0.34 A.
-128
0.26 A.
-150
0.29 A.
-129
0.22 A.
-149
0.29 A.
-130
0.22 A.
-148
0.29 A.
-131
0.22 A.
-147
0.29 A.
-132
0.22 A.
-146
0.25 A.
-133
0.26 A.
-145
0.05 A.
PITTS
900 -001 1.90 A.
SUB. NO. 83
PG.
COMBINATION
LOU ACRES 25
VOL.
182 -010
183 -011
181 -033
180 -032
GI
WIL-
SUB. NO.
PG.
153 -031
P.P.NO. 07-00-016-104
PRIOR INST: DV.945/503
DV.837/665 1.68ac, 1:402.665
SURVEYED BY: DANE A. HAPONEK
REC. SURVEYOR
APPROVED
LORAIN CO.
MAP DEPT
DATE 12-28-94
PAGE 62
7-00-016-B
21173