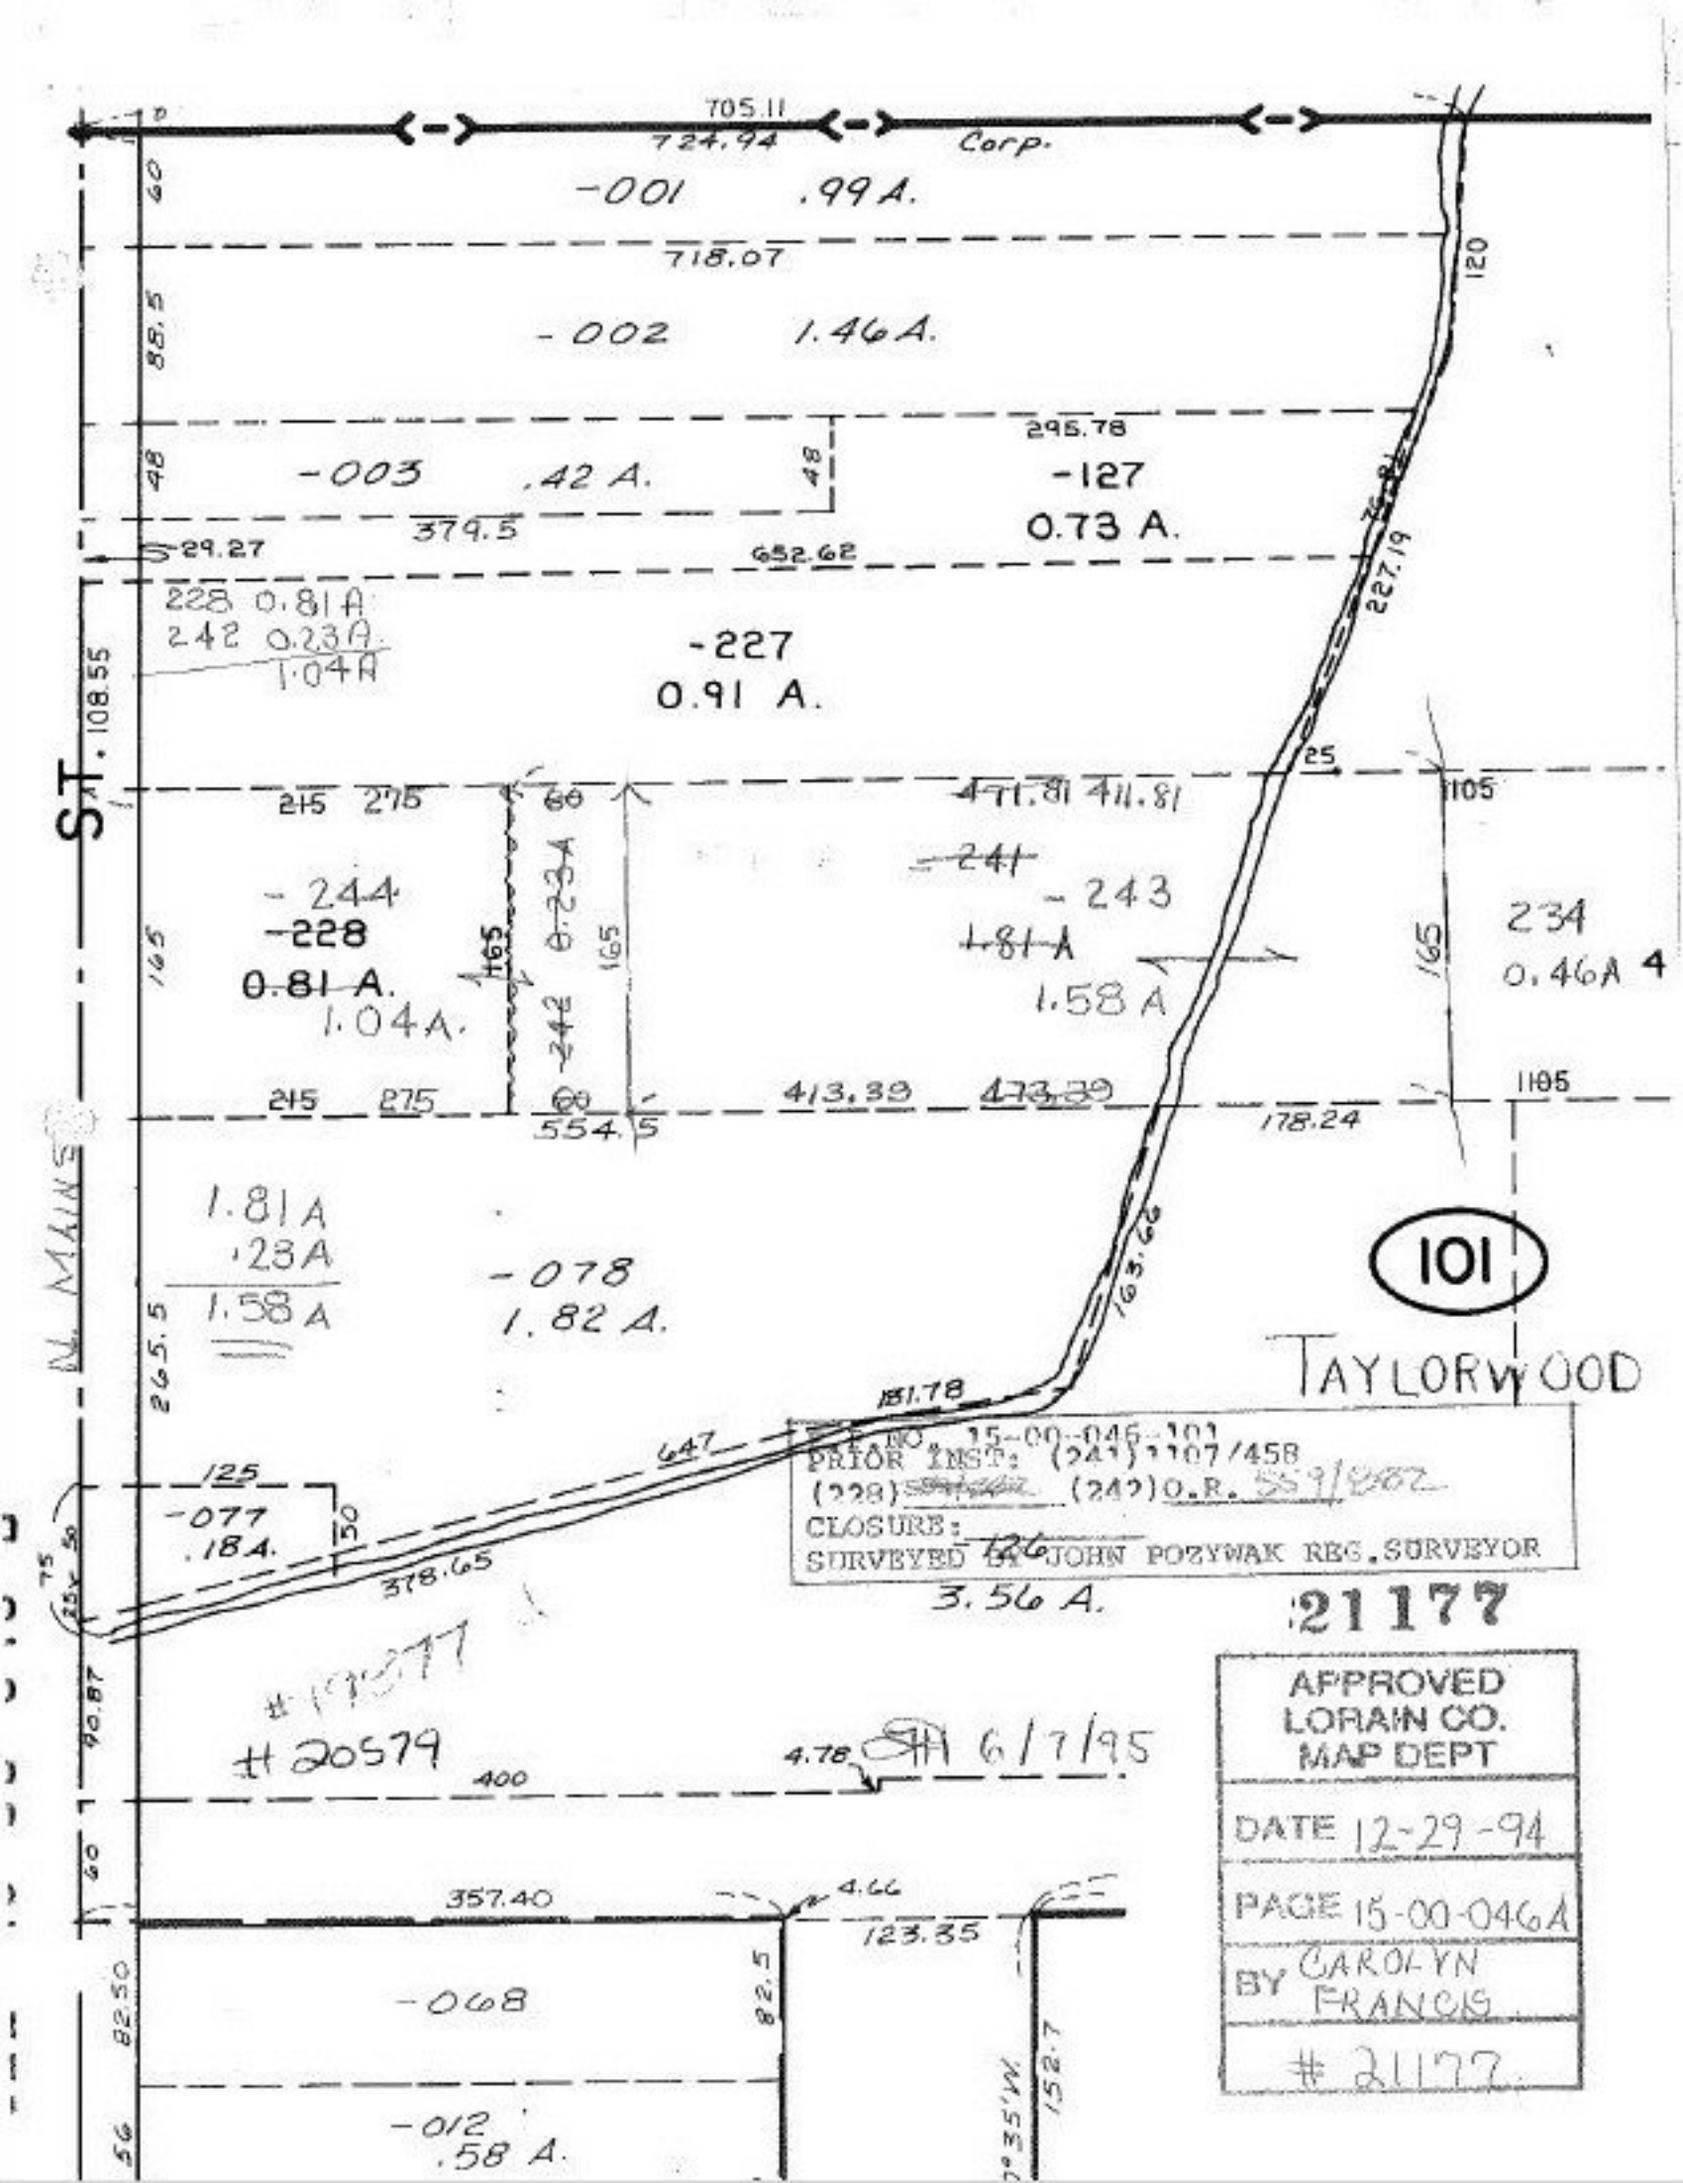
705.11
724.94
Corp.
-001 .99A.
718.07
-002 1.46A.
295.78
-003 .42 A.
379.5
-127
0.73 A.
652.62
228 0.81A
242 0.23A
1.04A
-227
0.91 A.
ST.
N. MAIN
-244
-228
0.81 A.
1.04A.
-243
1.81 A
1.58 A
234
0.46A
411.81
413.39
554.5
178.24
1.81A
.23A
1.58A
-078
1.82 A.
265.5
318.65
647
-077
.18A.
3.56 A.
#20579
4.78
6/7/95
357.40
4.66
123.35
-068
-012
.58 A.
152.7
101
TAYLORWOOD
PARCEL NO. 15-00-046-101
PRIOR INST: (241) 1107/458
(228) (242) O.R. 559/862
CLOSURE:
SURVEYED BY JOHN POZYWAK REG. SURVEYOR
21177
APPROVED
LORAIN CO.
MAP DEPT
DATE 12-29-94
PAGE 15-00-046A
BY CAROLYN FRANCIS
21177