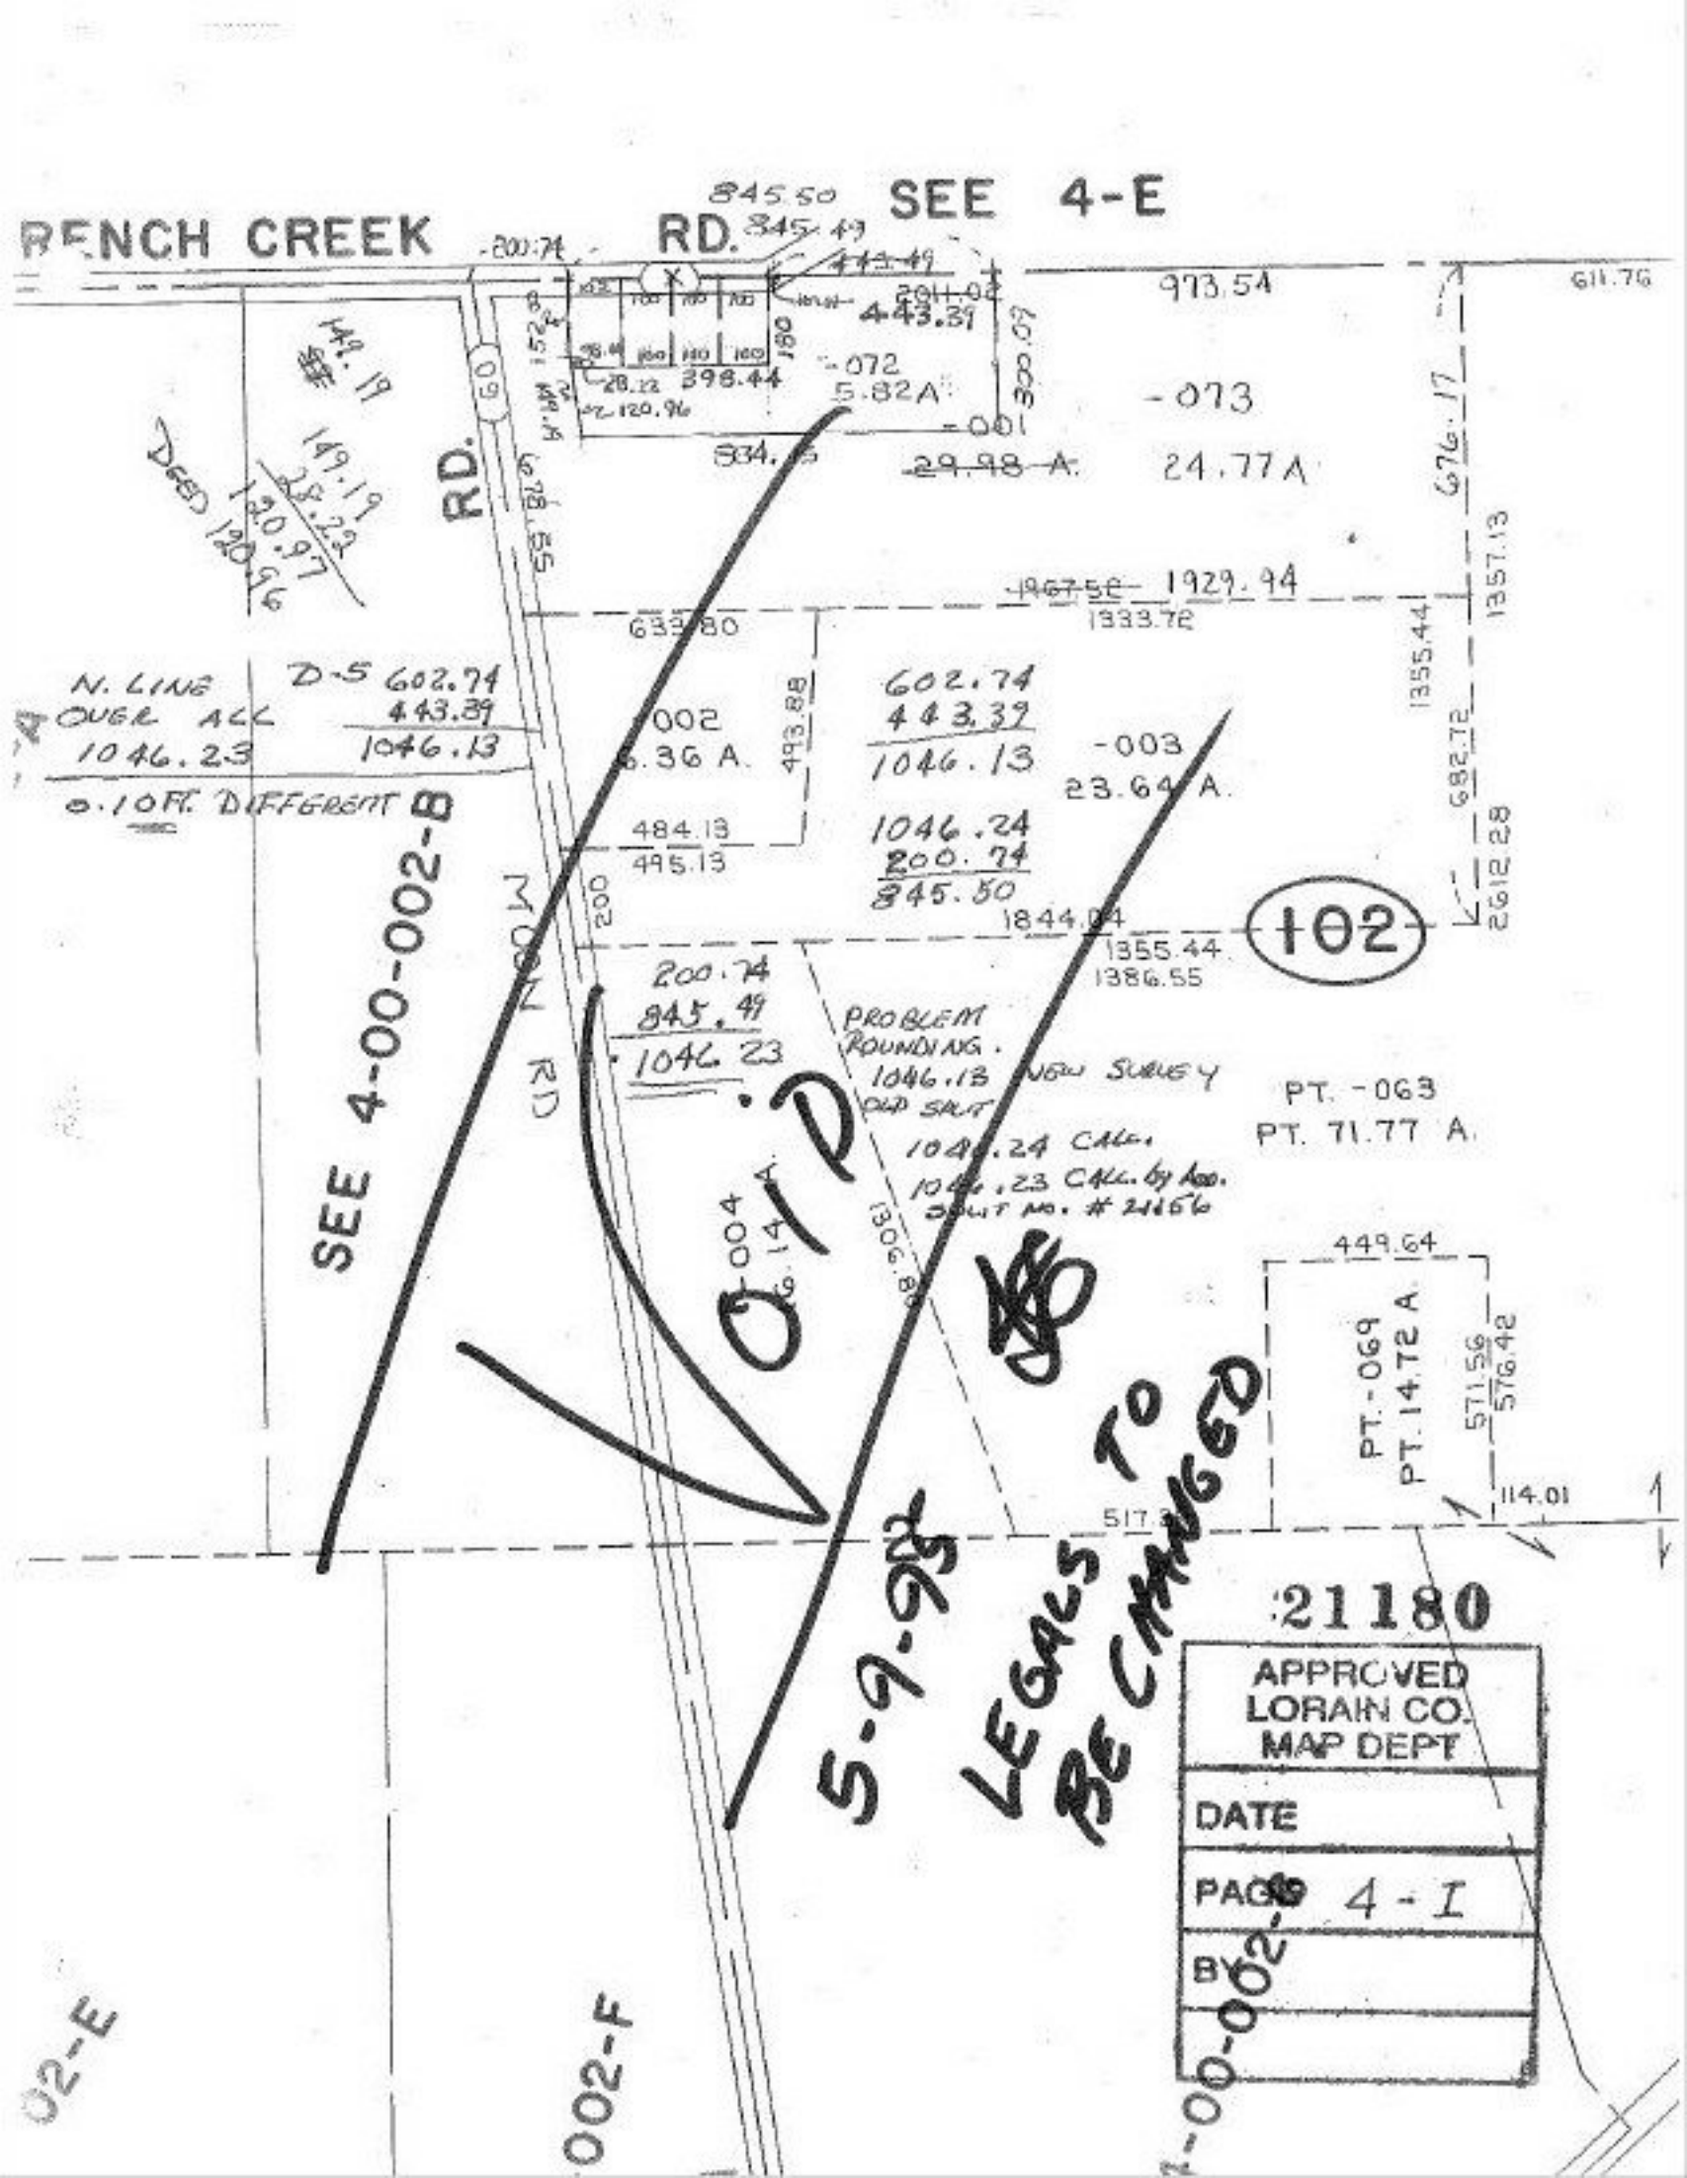

RENCH CREEK RD.
SEE 4-E
845.50
845.49
443.49
443.39
973.54
611.76
-072
5.82A
398.44
-073
24.77A
-001
29.98 A.
834.15
676.17
149.19
149.19
28.22
120.97
120.96
DEED 120.96
RD.
678.55
1967.52
1929.94
1333.72
1357.13
633.80
1355.44
N. LINE OVER ALL 1046.23
D-5 602.74
443.39
1046.13
0.10 FT. DIFFERENT
-002
6.36 A.
493.88
602.74
443.39
1046.13
-003
23.64 A.
682.72
484.13
495.13
1046.24
200.74
845.50
2612.28
1844.04
1355.44
1386.55
102
200.74
845.49
1046.23
PROBLEM ROUNDING.
1046.13 NEW SURVEY
OLD SPLIT
1046.24 CALC.
1046.23 CALC. by Acc.
SPLIT NO. # 21156
PT. -063
PT. 71.77 A.
SEE 4-00-002-B
MOON RD
-004
6.14 A.
1306.80
449.64
PT. -069
PT. 14.72 A
571.56
576.42
114.01
517.3
VOID
5-9-95
LEGALS TO BE CHANGED
21180
APPROVED
LORAIN CO.
MAP DEPT
DATE
PAGE 4-I
BY
02-E
002-F
-00-002-