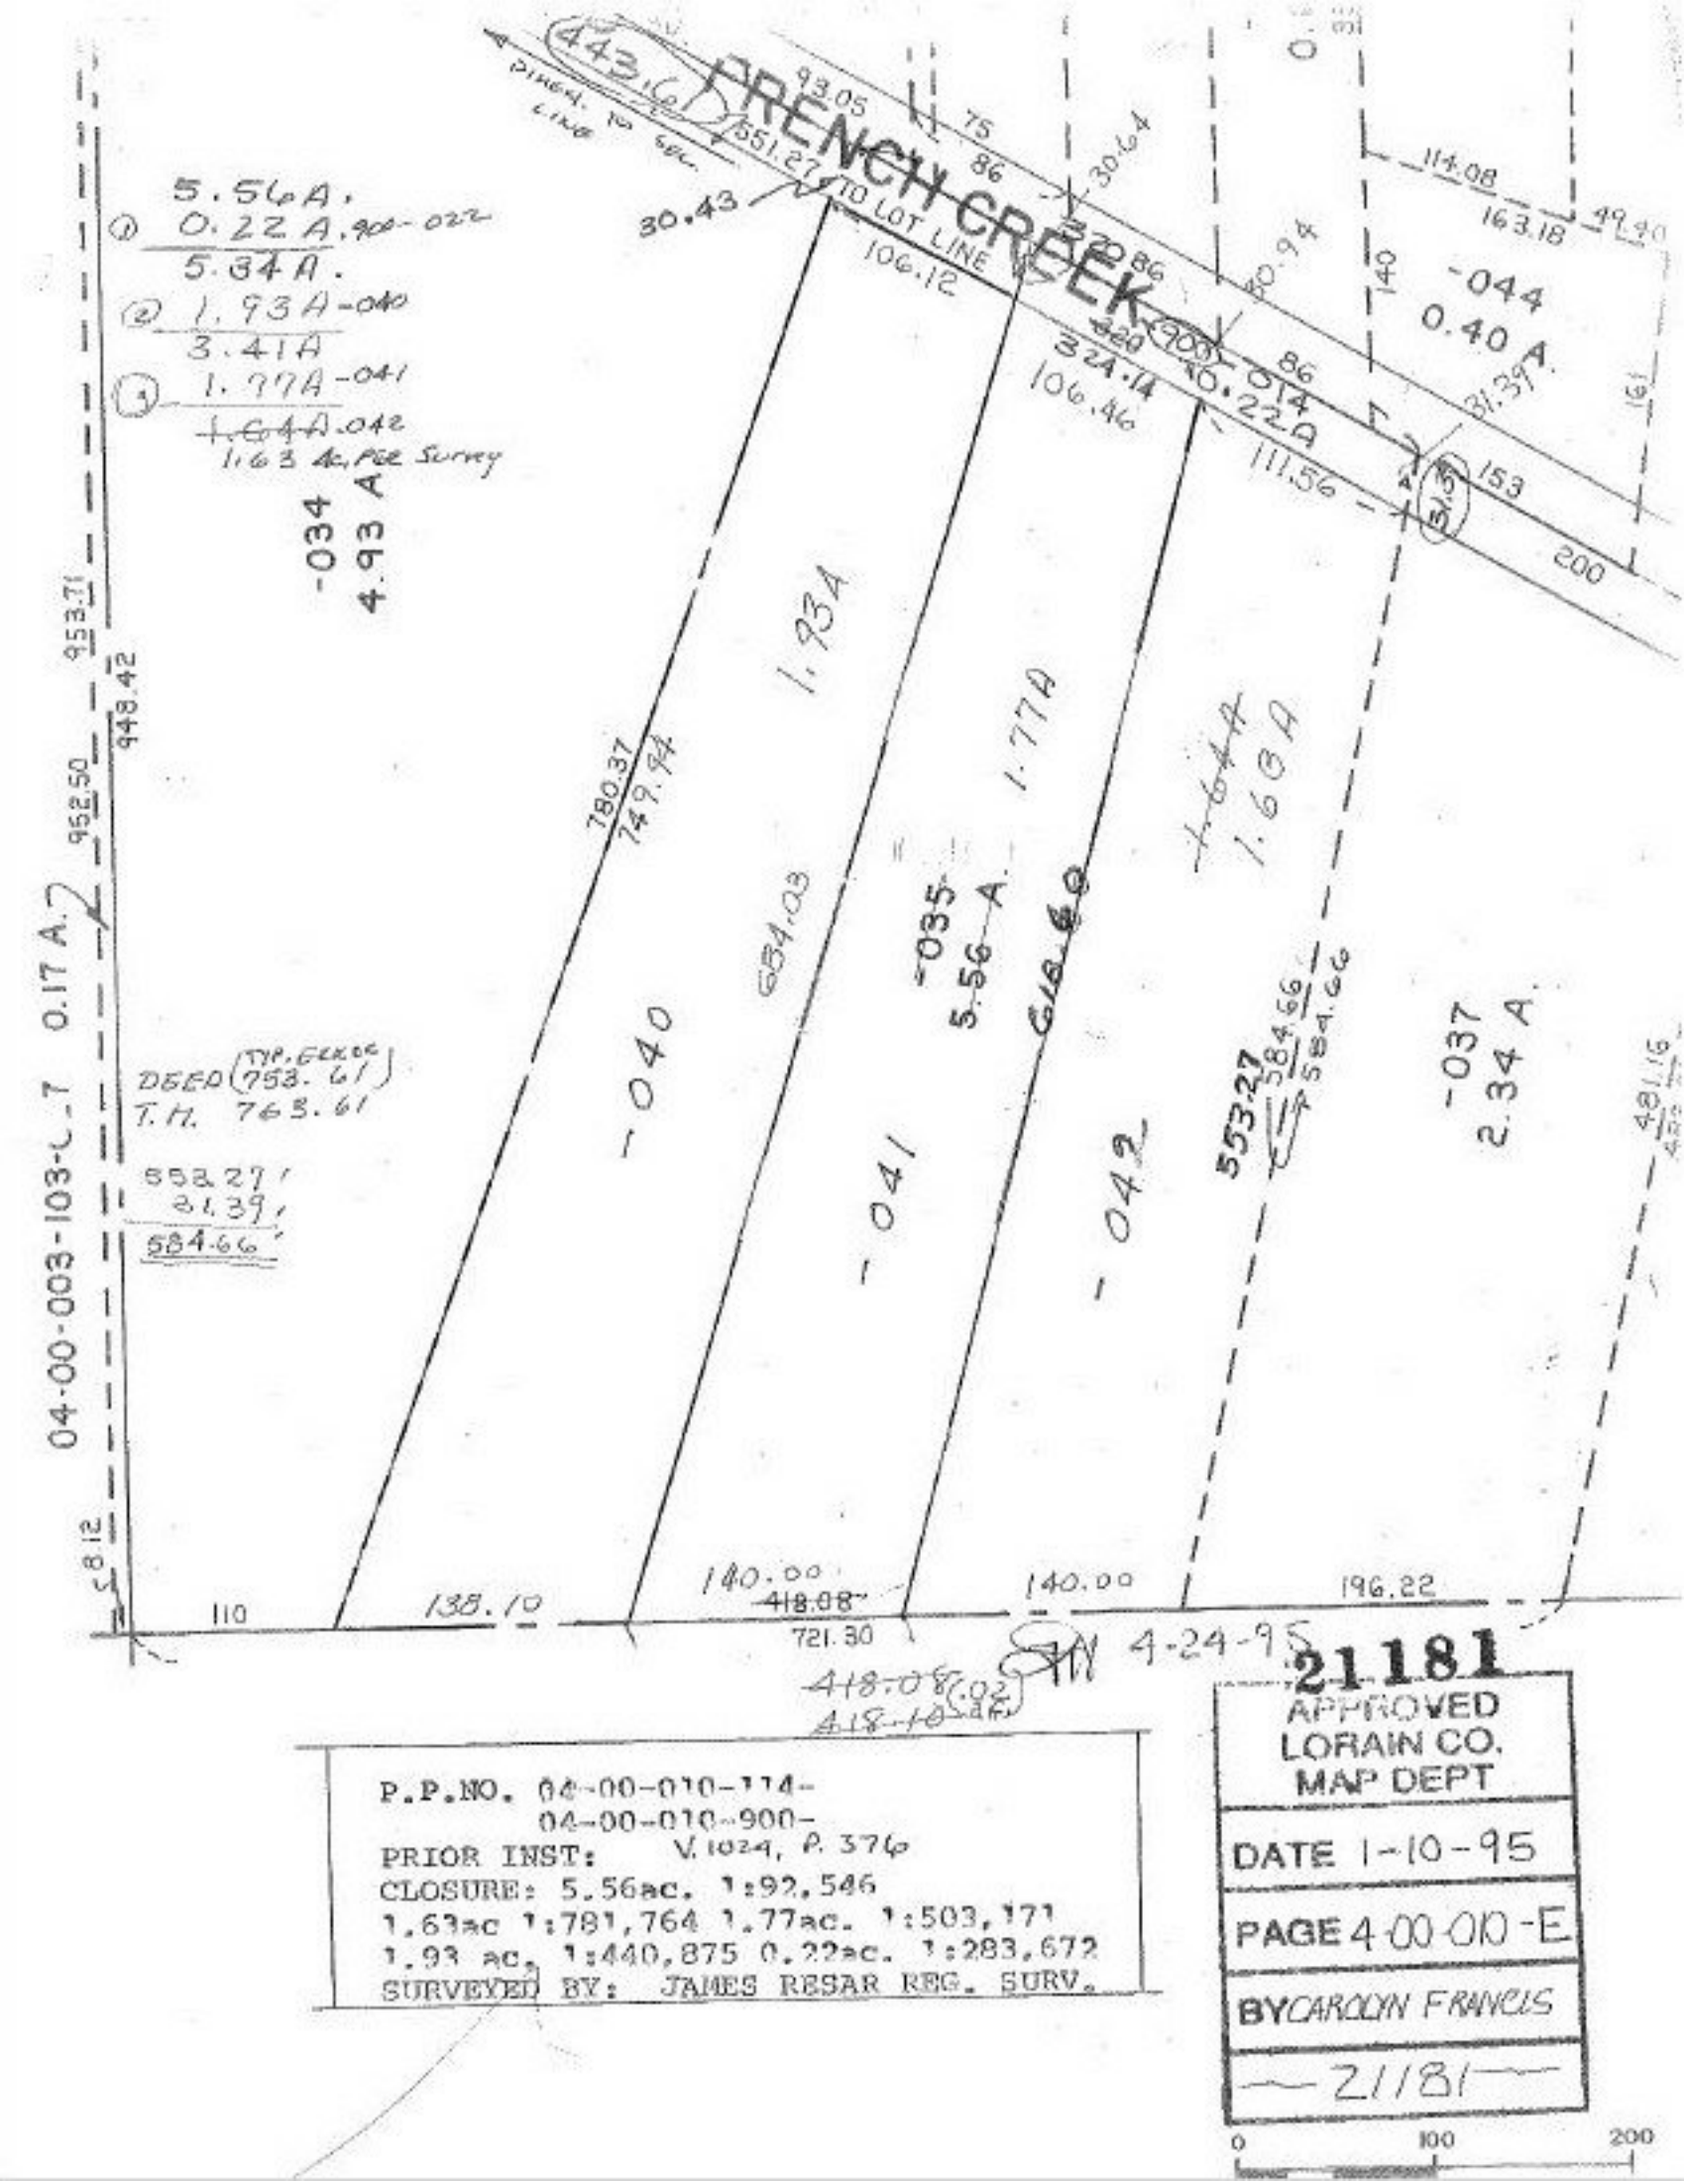

P.P.NO. 04-00-010-114-
04-00-010-900-
PRIOR INST: V. 1024, P. 376
CLOSURE: 5.56ac. 1:92,546
1.63ac 1:781,764 1.77ac. 1:503,171
1.93 ac. 1:440,875 0.22ac. 1:283,672
SURVEYED BY: JAMES RESAR REG. SURV.