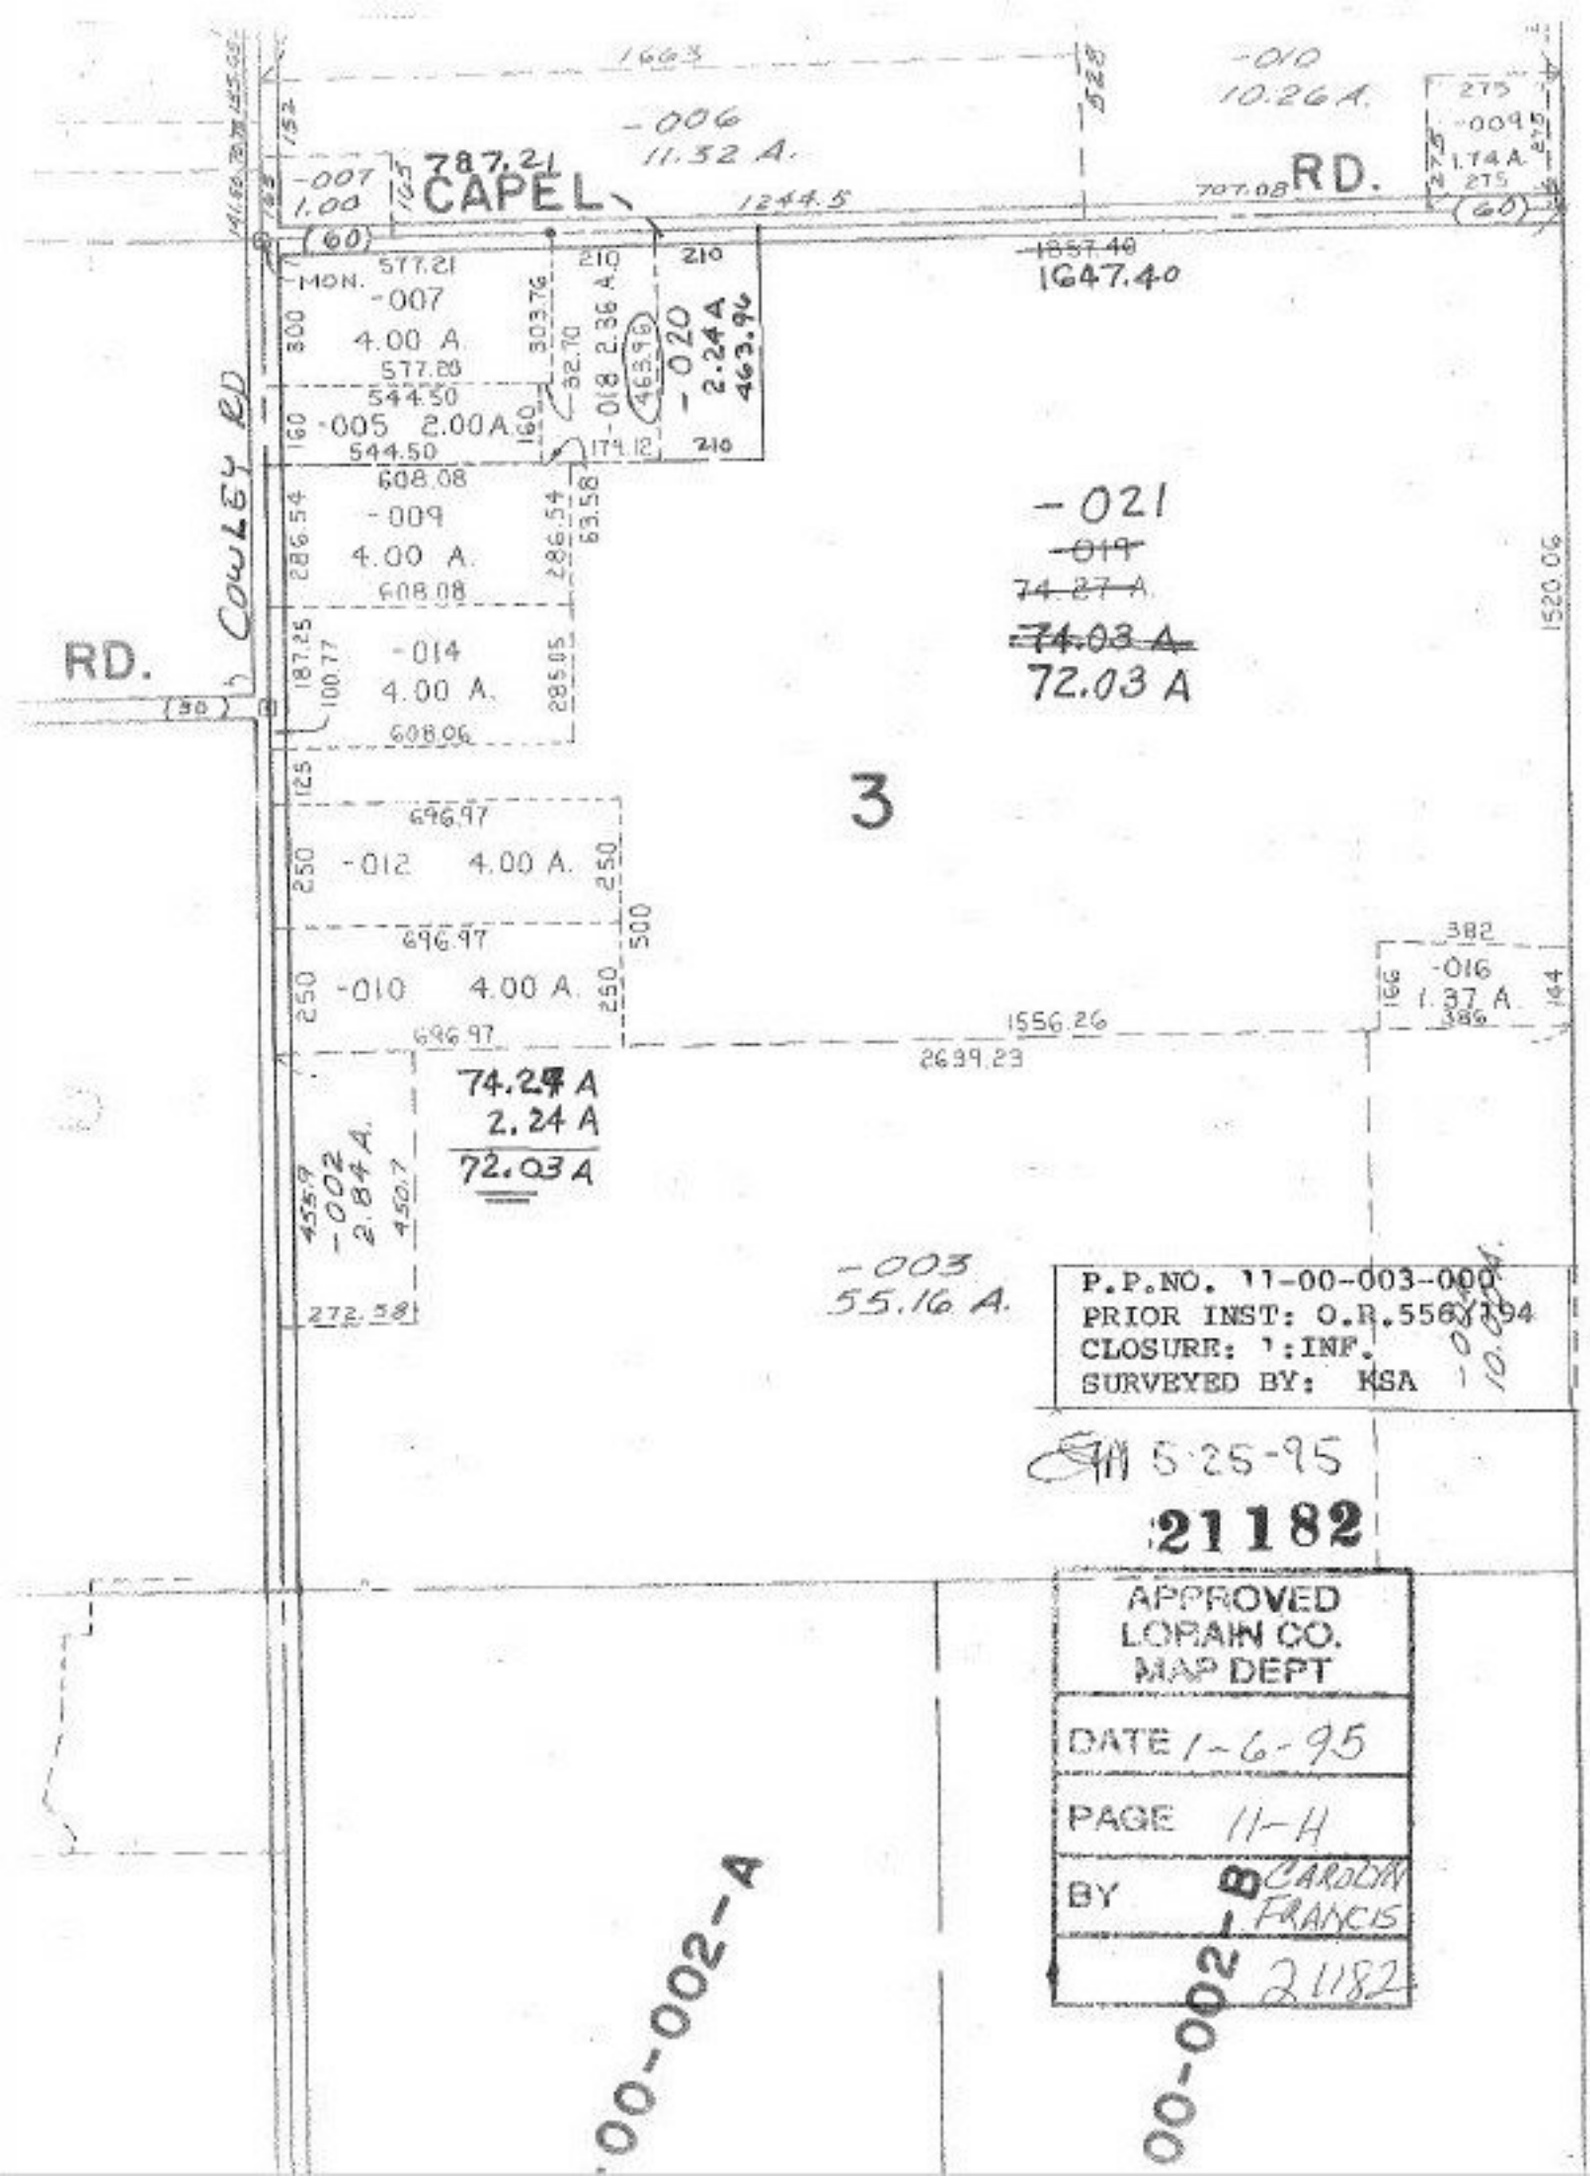
1663
-010
10.26 A.
-006
11.32 A.
787.21
CAPEL
707.08 RD.
1244.5
-007
1.00
-009
1.74 A.
1857.40
1647.40
MON.
577.21
-007
4.00 A.
577.88
544.50
-005 2.00 A.
544.50
608.08
-009
4.00 A.
608.08
-014
4.00 A.
608.06
COWLEY RD
RD.
-018 2.36 A.
-020
2.24 A
463.96
-021
-019
74.27 A.
74.03 A
72.03 A
1520.06
3
696.97
-012 4.00 A.
696.97
-010 4.00 A.
696.97
1556.26
2639.23
-016
1.37 A.
74.27 A
2.24 A
72.03 A
-002
2.84 A.
-003
55.16 A.
-004
10.00 A.
P.P.NO. 11-00-003-000
PRIOR INST: O.R.556/194
CLOSURE: 1:INF.
SURVEYED BY: KSA
5-25-95
21182
APPROVED
LORAIN CO.
MAP DEPT
DATE 1-6-95
PAGE 11-H
BY CAROLYN J. FRANCIS
21182
00-002-A
00-002-B