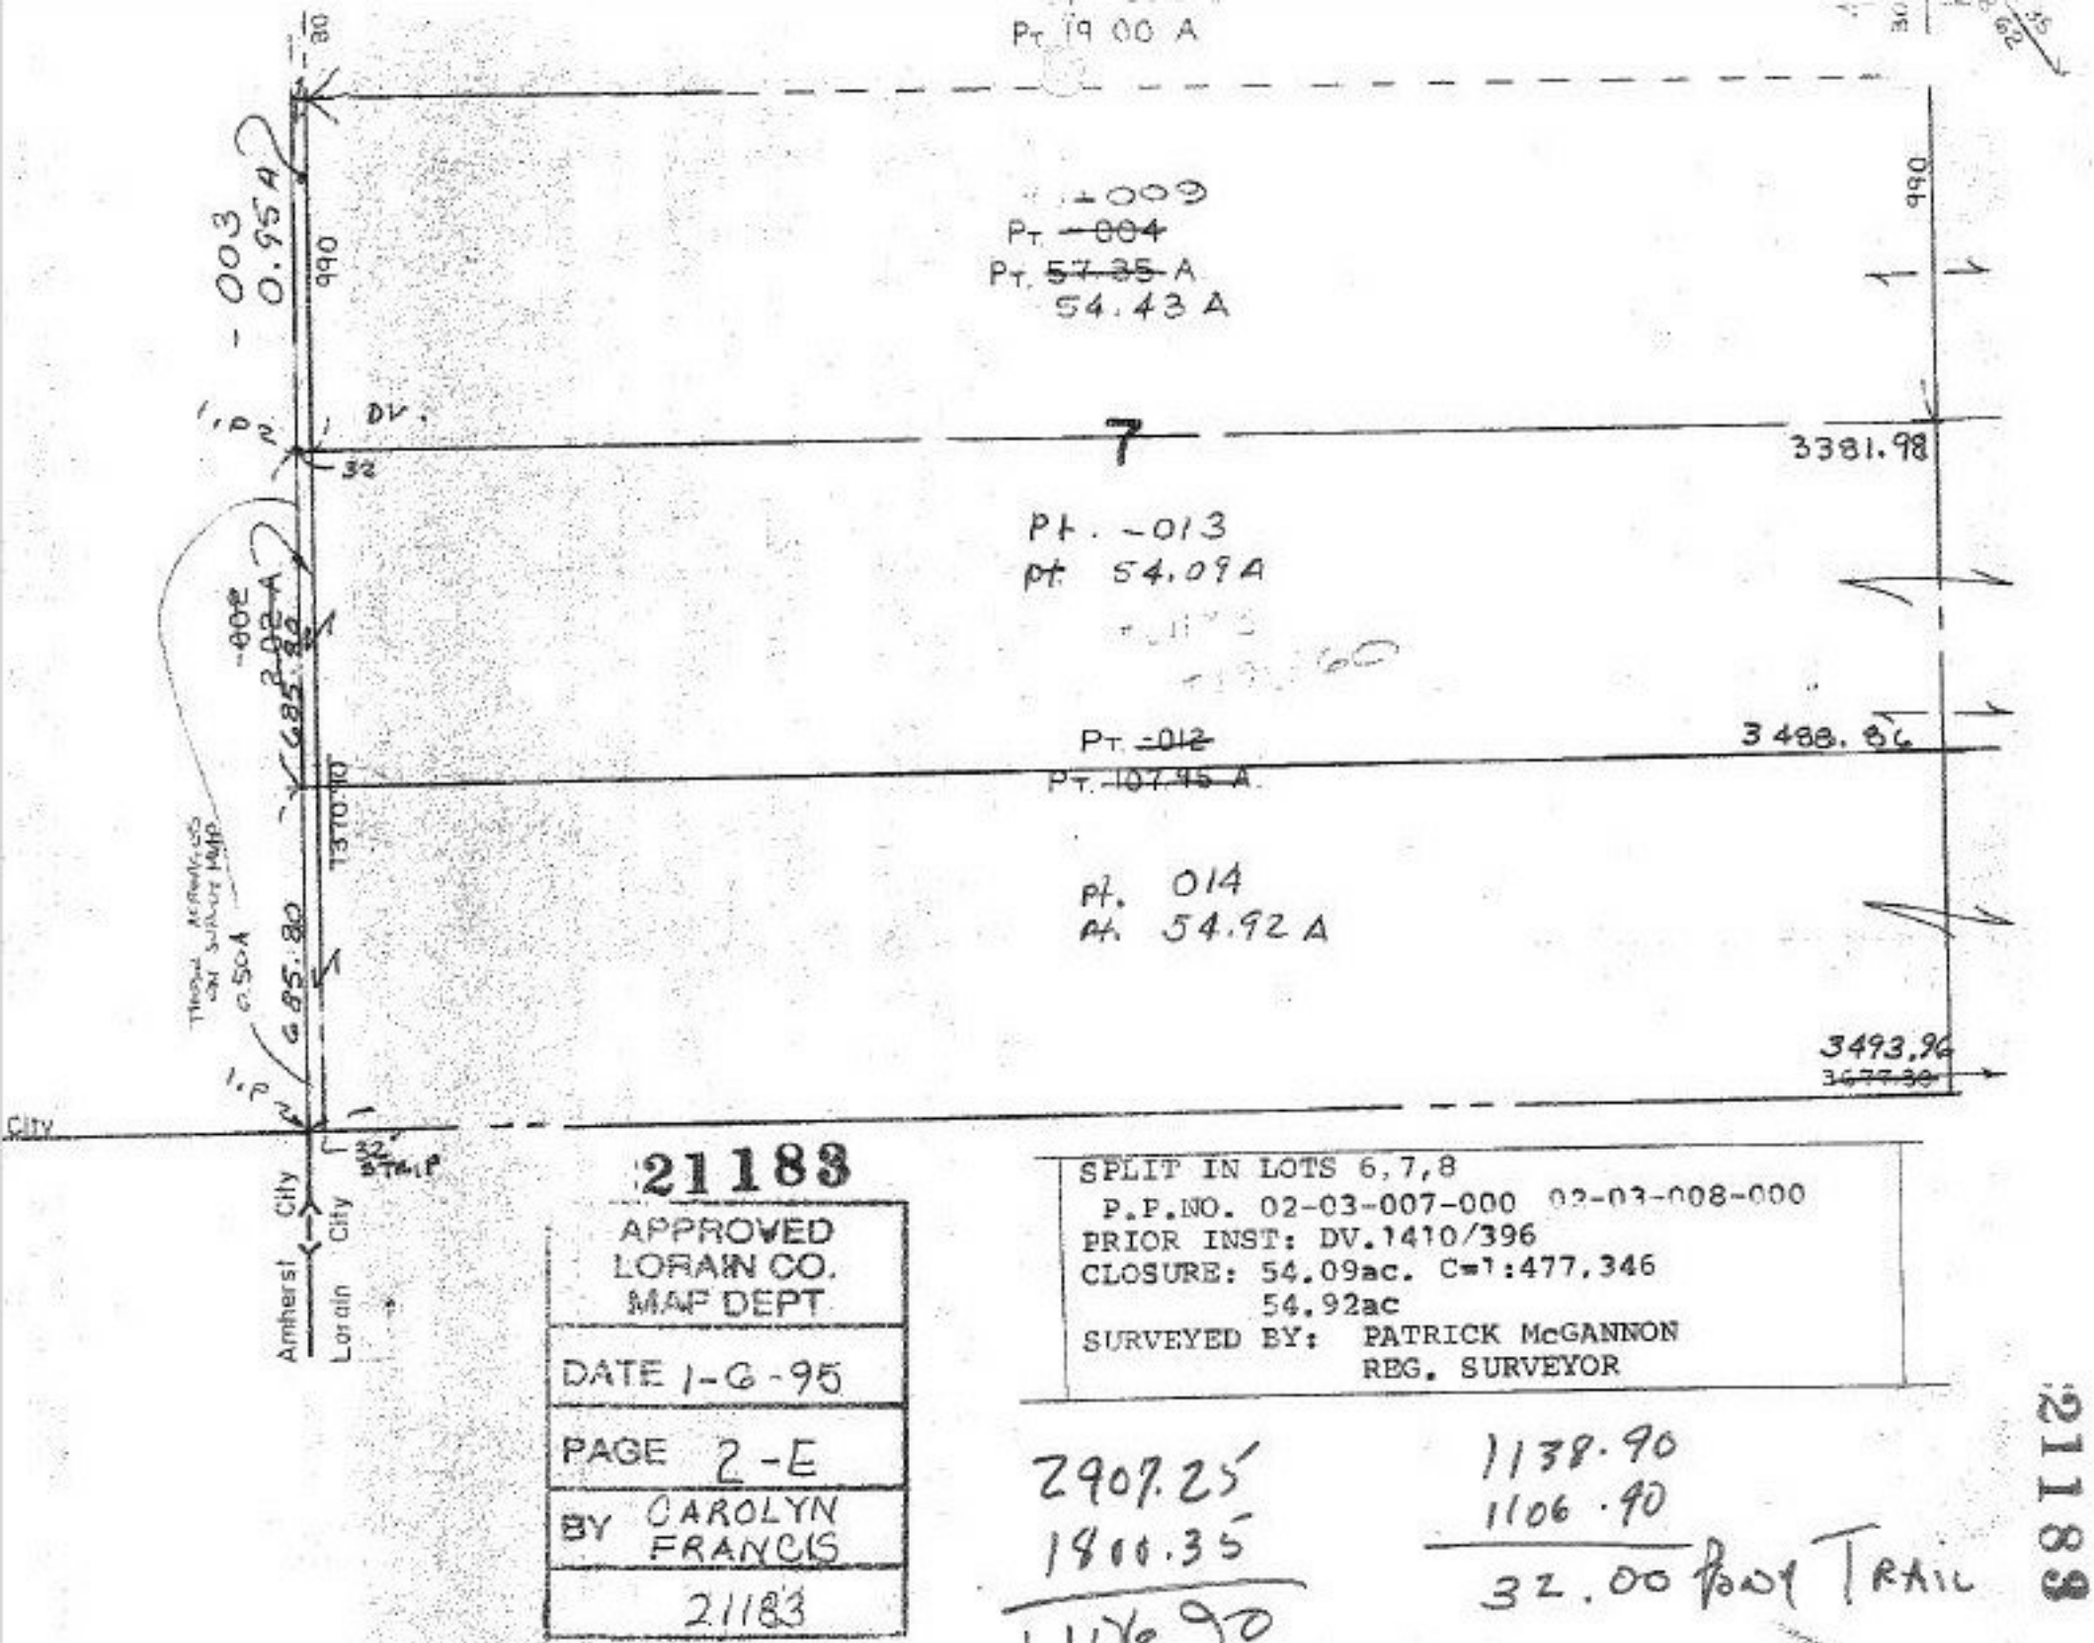

21183

APPROVED LORAIN CO. MAP DEPT
DATE 1-6-95
PAGE 2-E
BY CAROLYN FRANCIS
21183

SPLIT IN LOTS 6,7,8
P.P.NO. 02-03-007-000 02-03-008-000
PRIOR INST: DV.1410/396
CLOSURE: 54.09ac. C=1:477,346
54.92ac
SURVEYED BY: PATRICK McGANNON
REG. SURVEYOR

2907.25
1800.35
1106.90

1138.90
1106.90
32.00 Foot Trail

21183