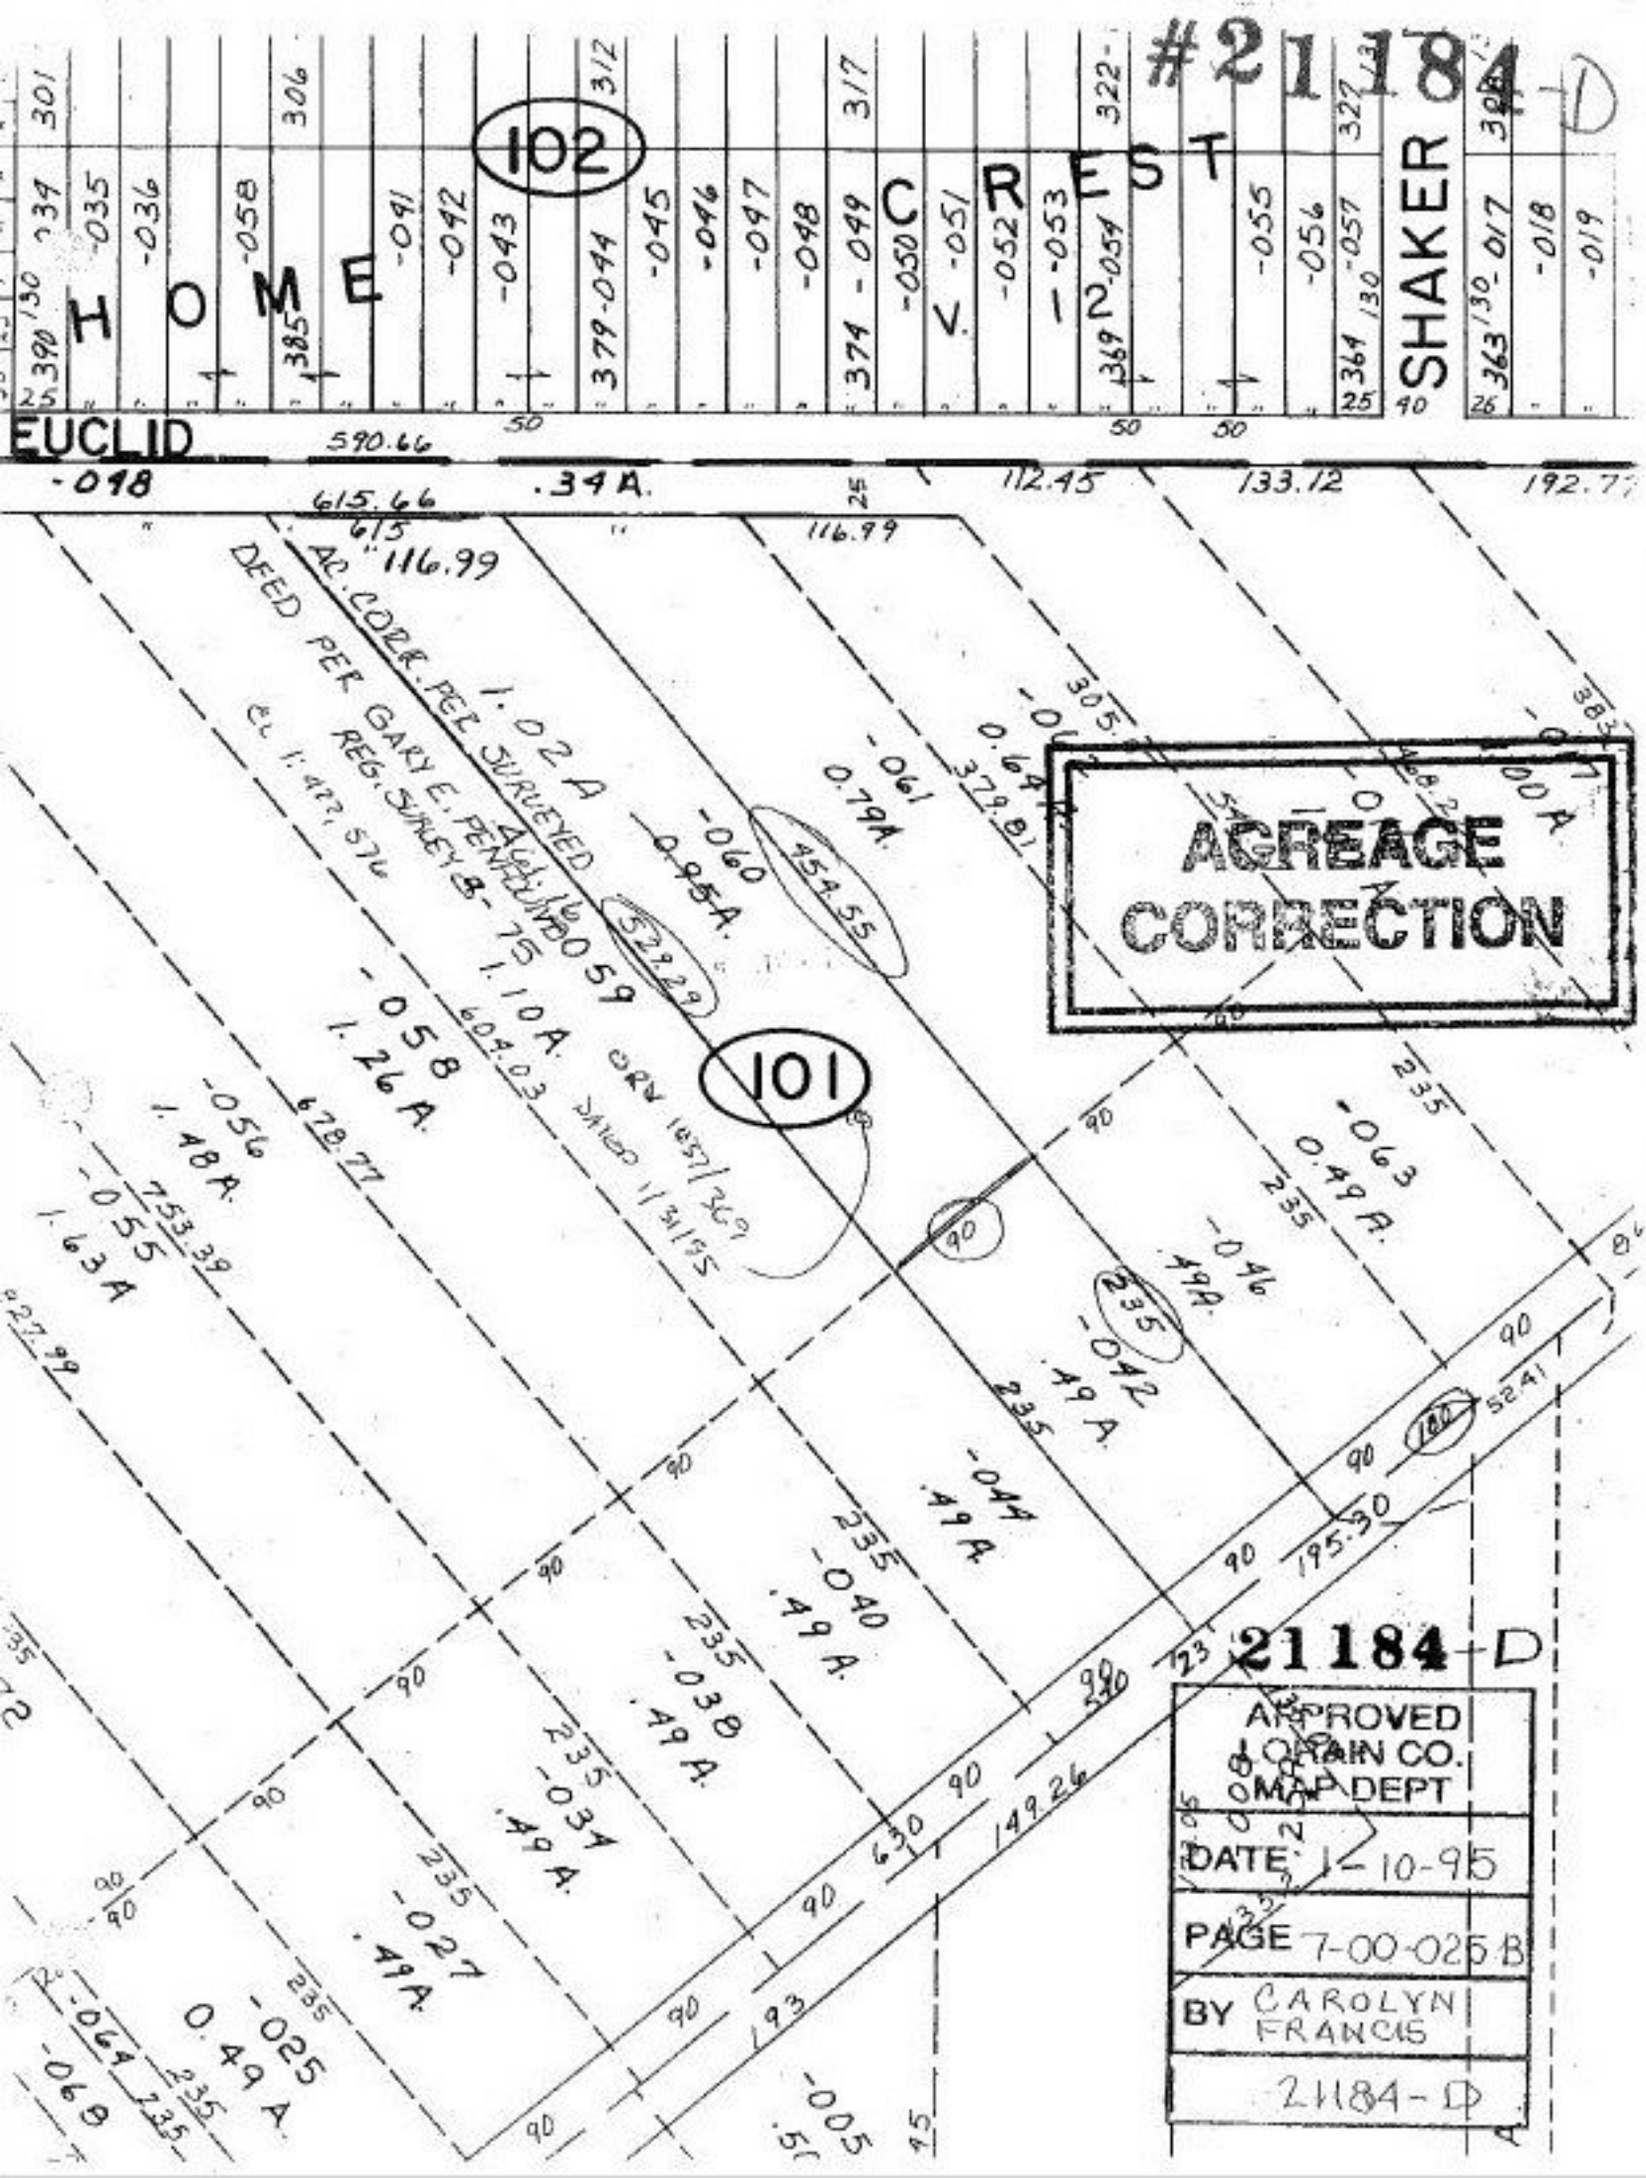
#21184-D
HOME CREST V. 12
SHAKER
EUCLID
102
101
590.66
615.66
116.99
.34 A.
112.45
133.12
192.77
AC. CORR. PER SURVEYED
DEED PER GARY E. PENFOUND
REG. SURVEY 8-75
1.02 A
1.10 A.
1.26 A.
1.48 A.
1.63 A
0.95 A.
0.79 A.
0.49 A.
.49 A.
AGREAGE CORRECTION
21184-D
APPROVED
LORAIN CO.
MAP DEPT
DATE 1-10-95
PAGE 7-00-025 B
BY CAROLYN FRANCIS
21184-D