


165
-033
.31A.

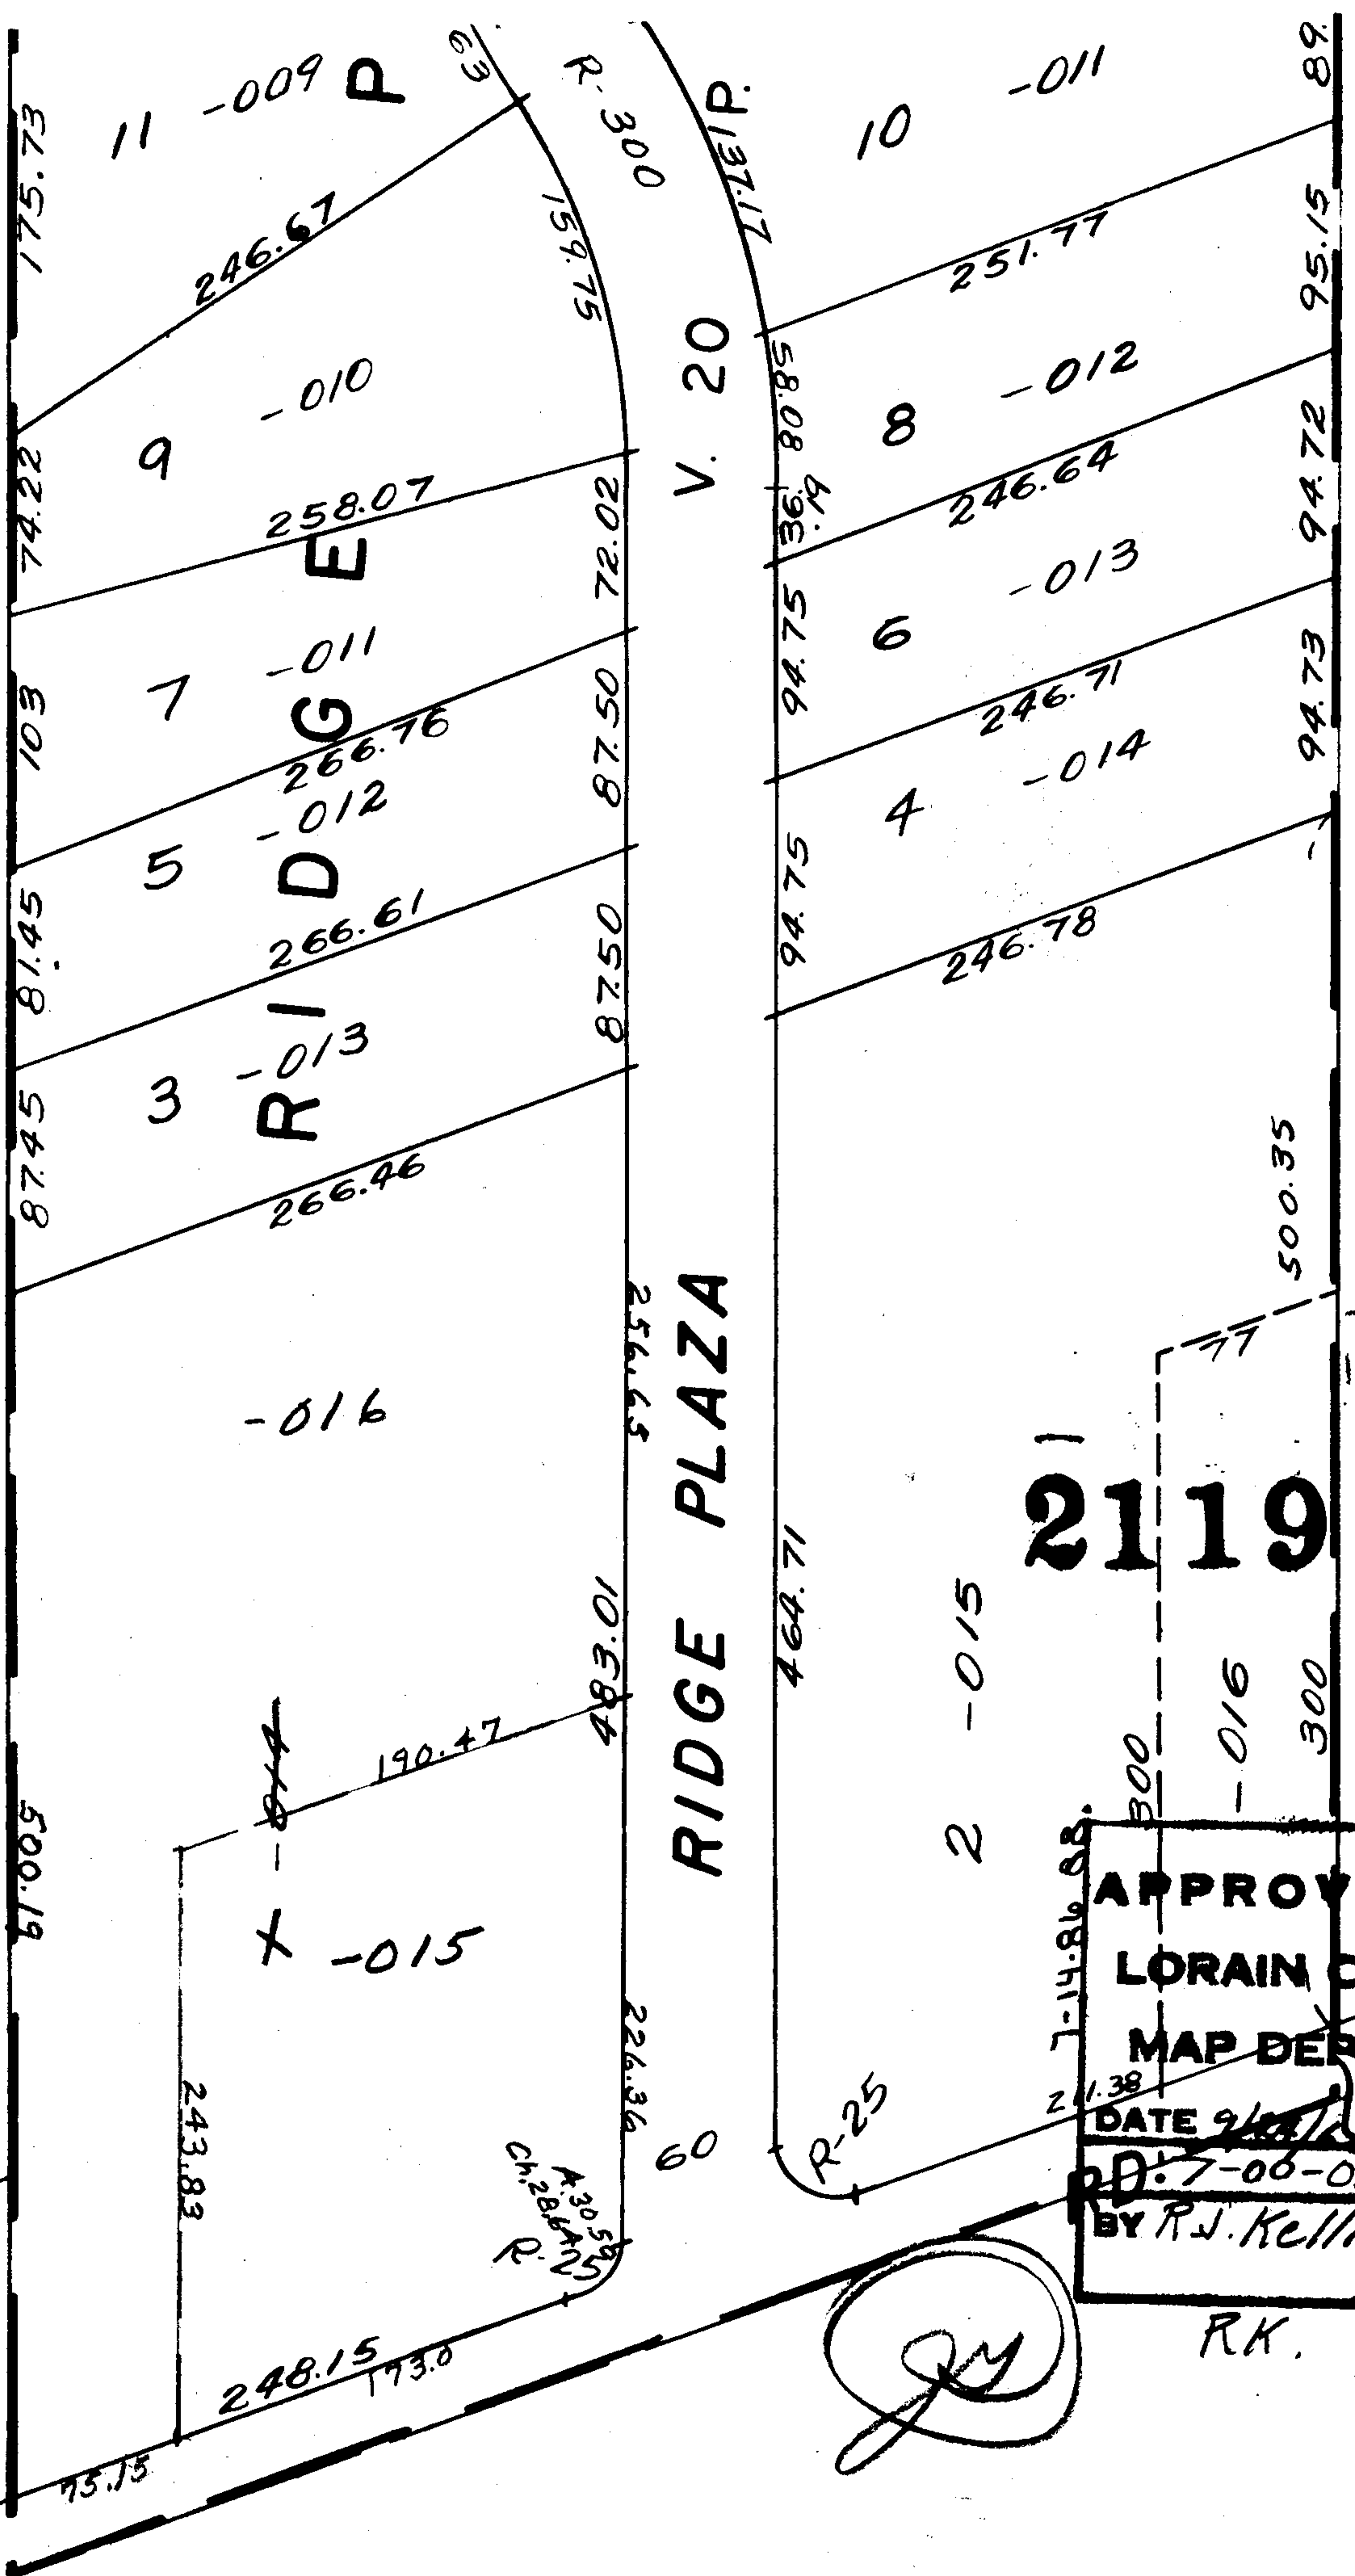

2119

APPROVED
LORAIN CO.
MAP DEPT.
DATE 9/15/20
BY R.J. Kelling

RK.

(Handwritten signature)

SEE 7-00-021-