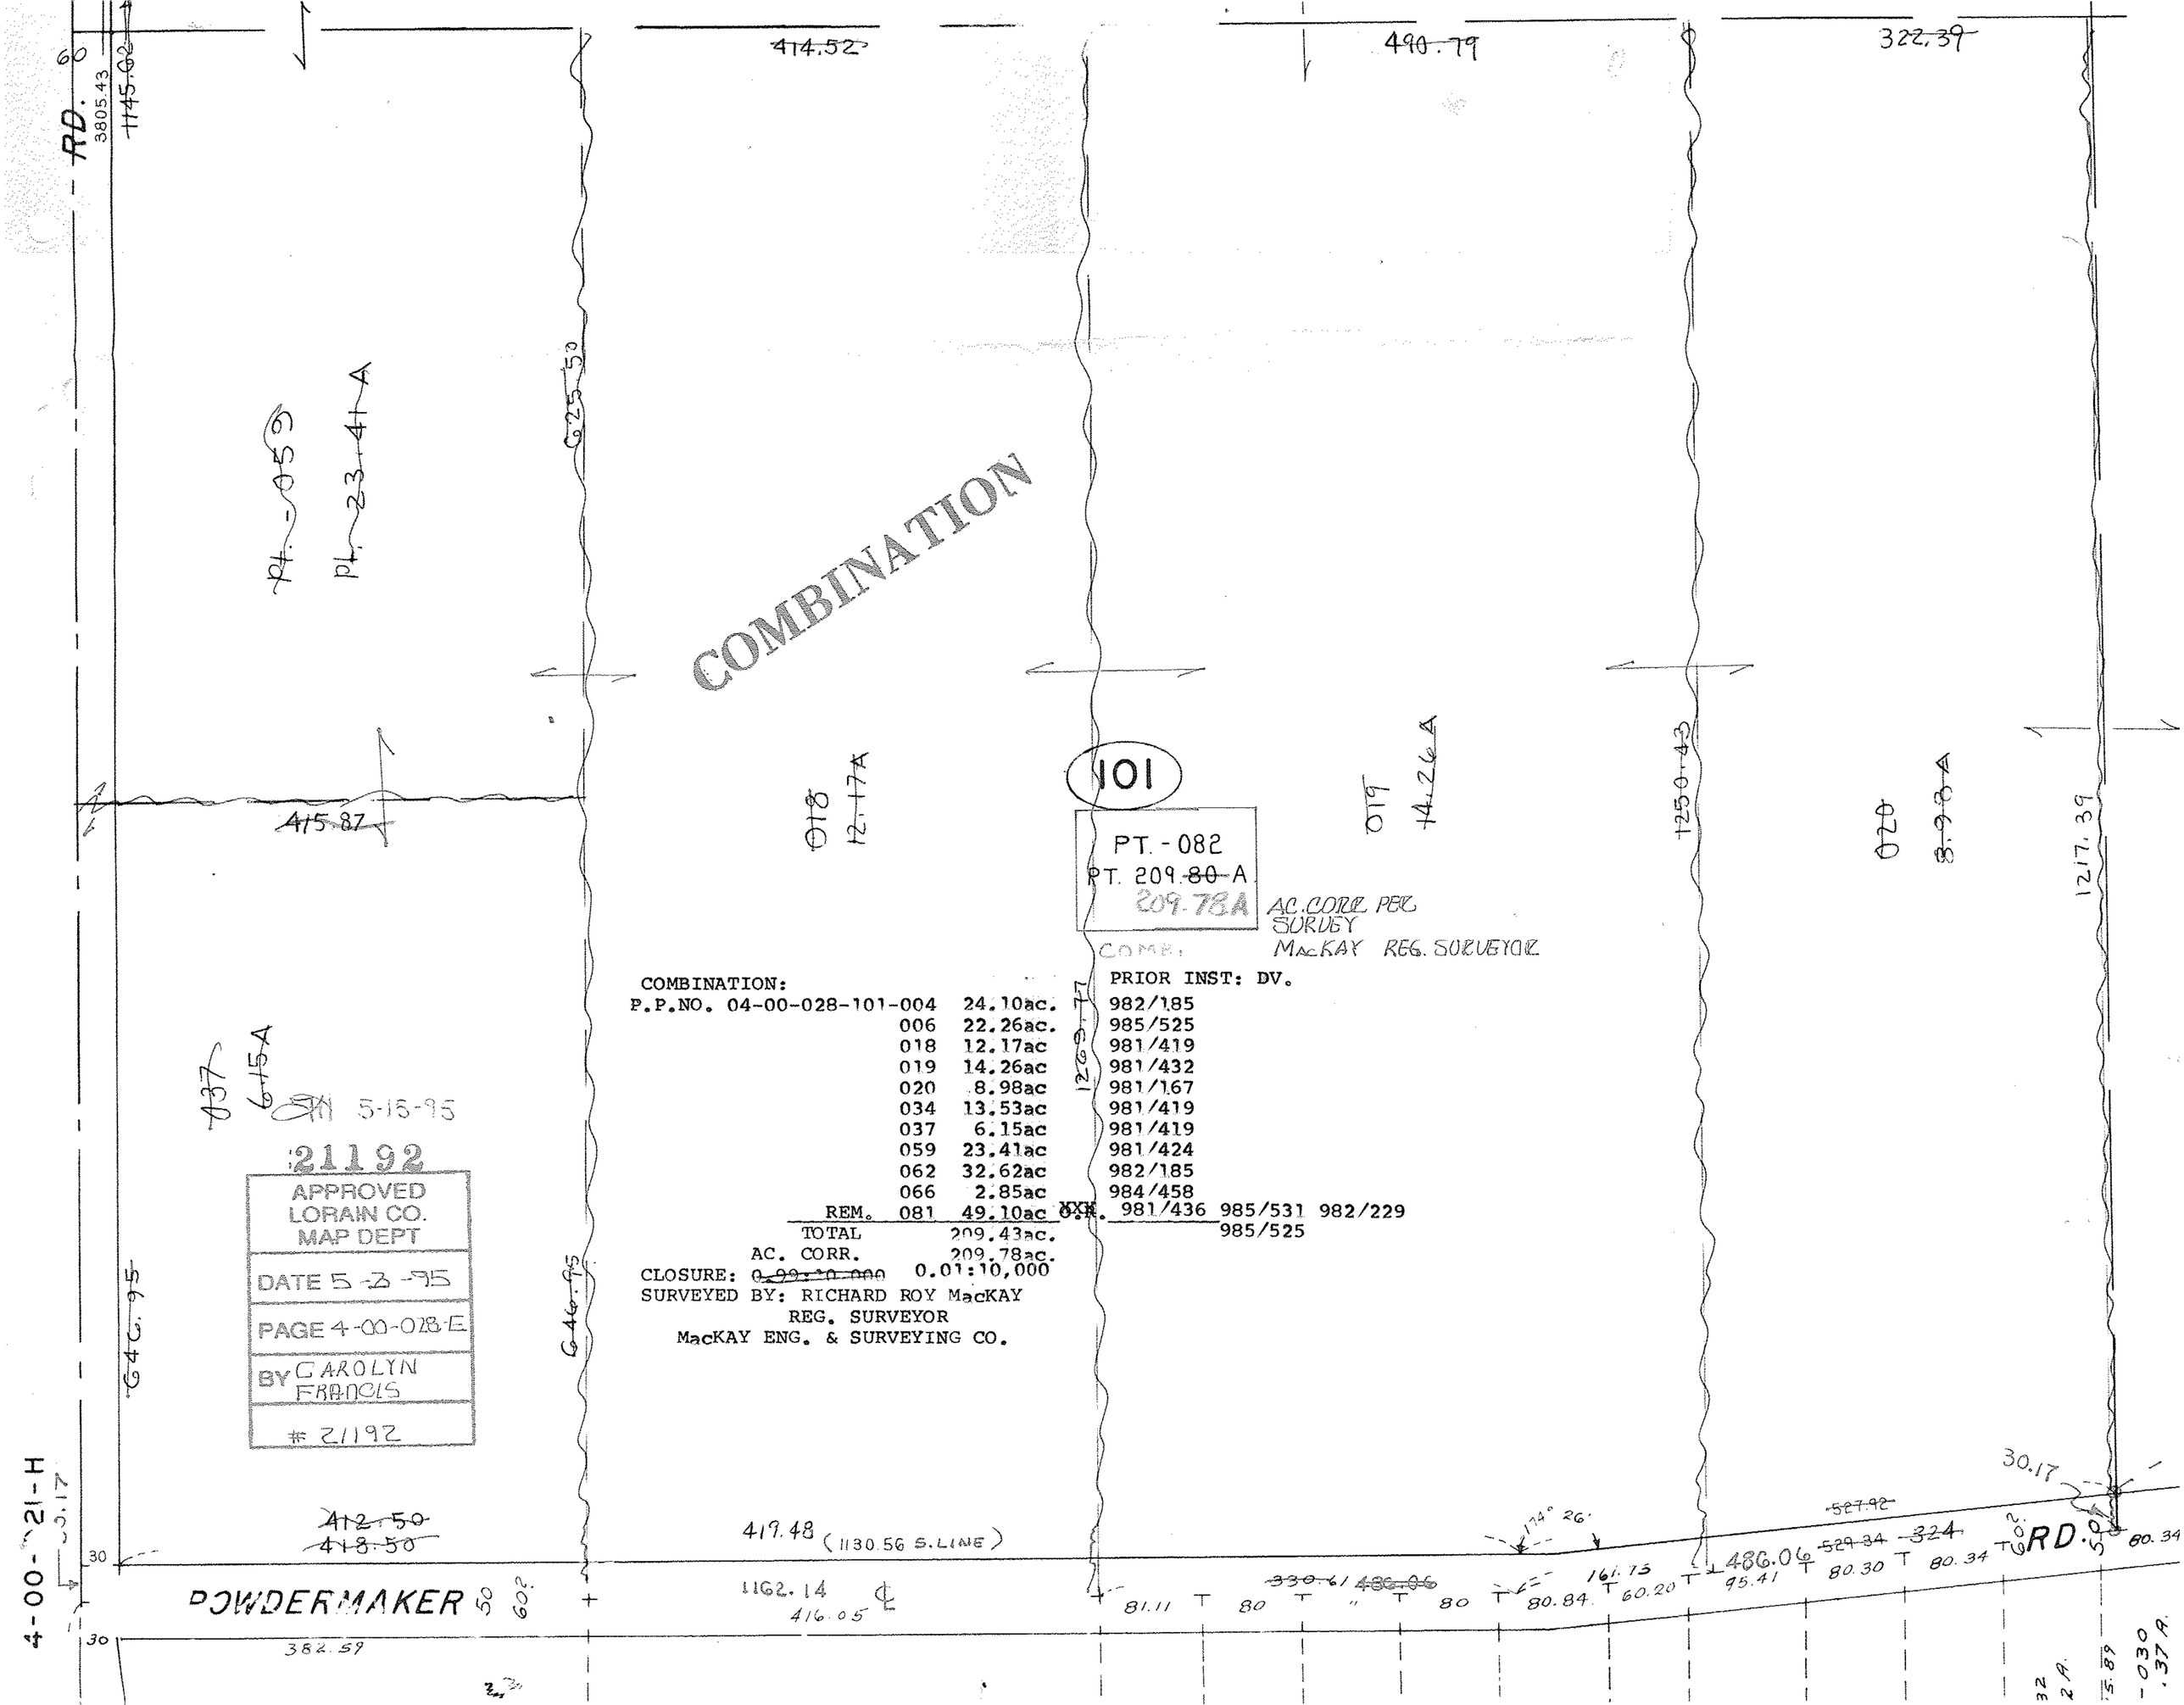

COMBINATION:

			PRIOR INST: DV.
P.P.NO. 04-00-028-101-004	24.10ac.		982/185
006	22.26ac.		985/525
018	12.17ac		981/419
019	14.26ac		981/432
020	8.98ac		981/167
034	13.53ac		981/419
037	6.15ac		981/419
059	23.41ac		981/424
062	32.62ac		982/185
066	2.85ac		984/458
REM. 081	49.10ac	XXX.	981/436 985/531 982/229 985/525
TOTAL	209.43ac.		
AC. CORR.	209.78ac.		

CLOSURE: ~~0.99:10,000~~ 0.01:10,000

SURVEYED BY: RICHARD ROY MacKAY
REG. SURVEYOR
MacKAY ENG. & SURVEYING CO.