


SEE 4-H - PUT IN LINE BREAK LINE -

- PUT IN LINE BREAK LINE -

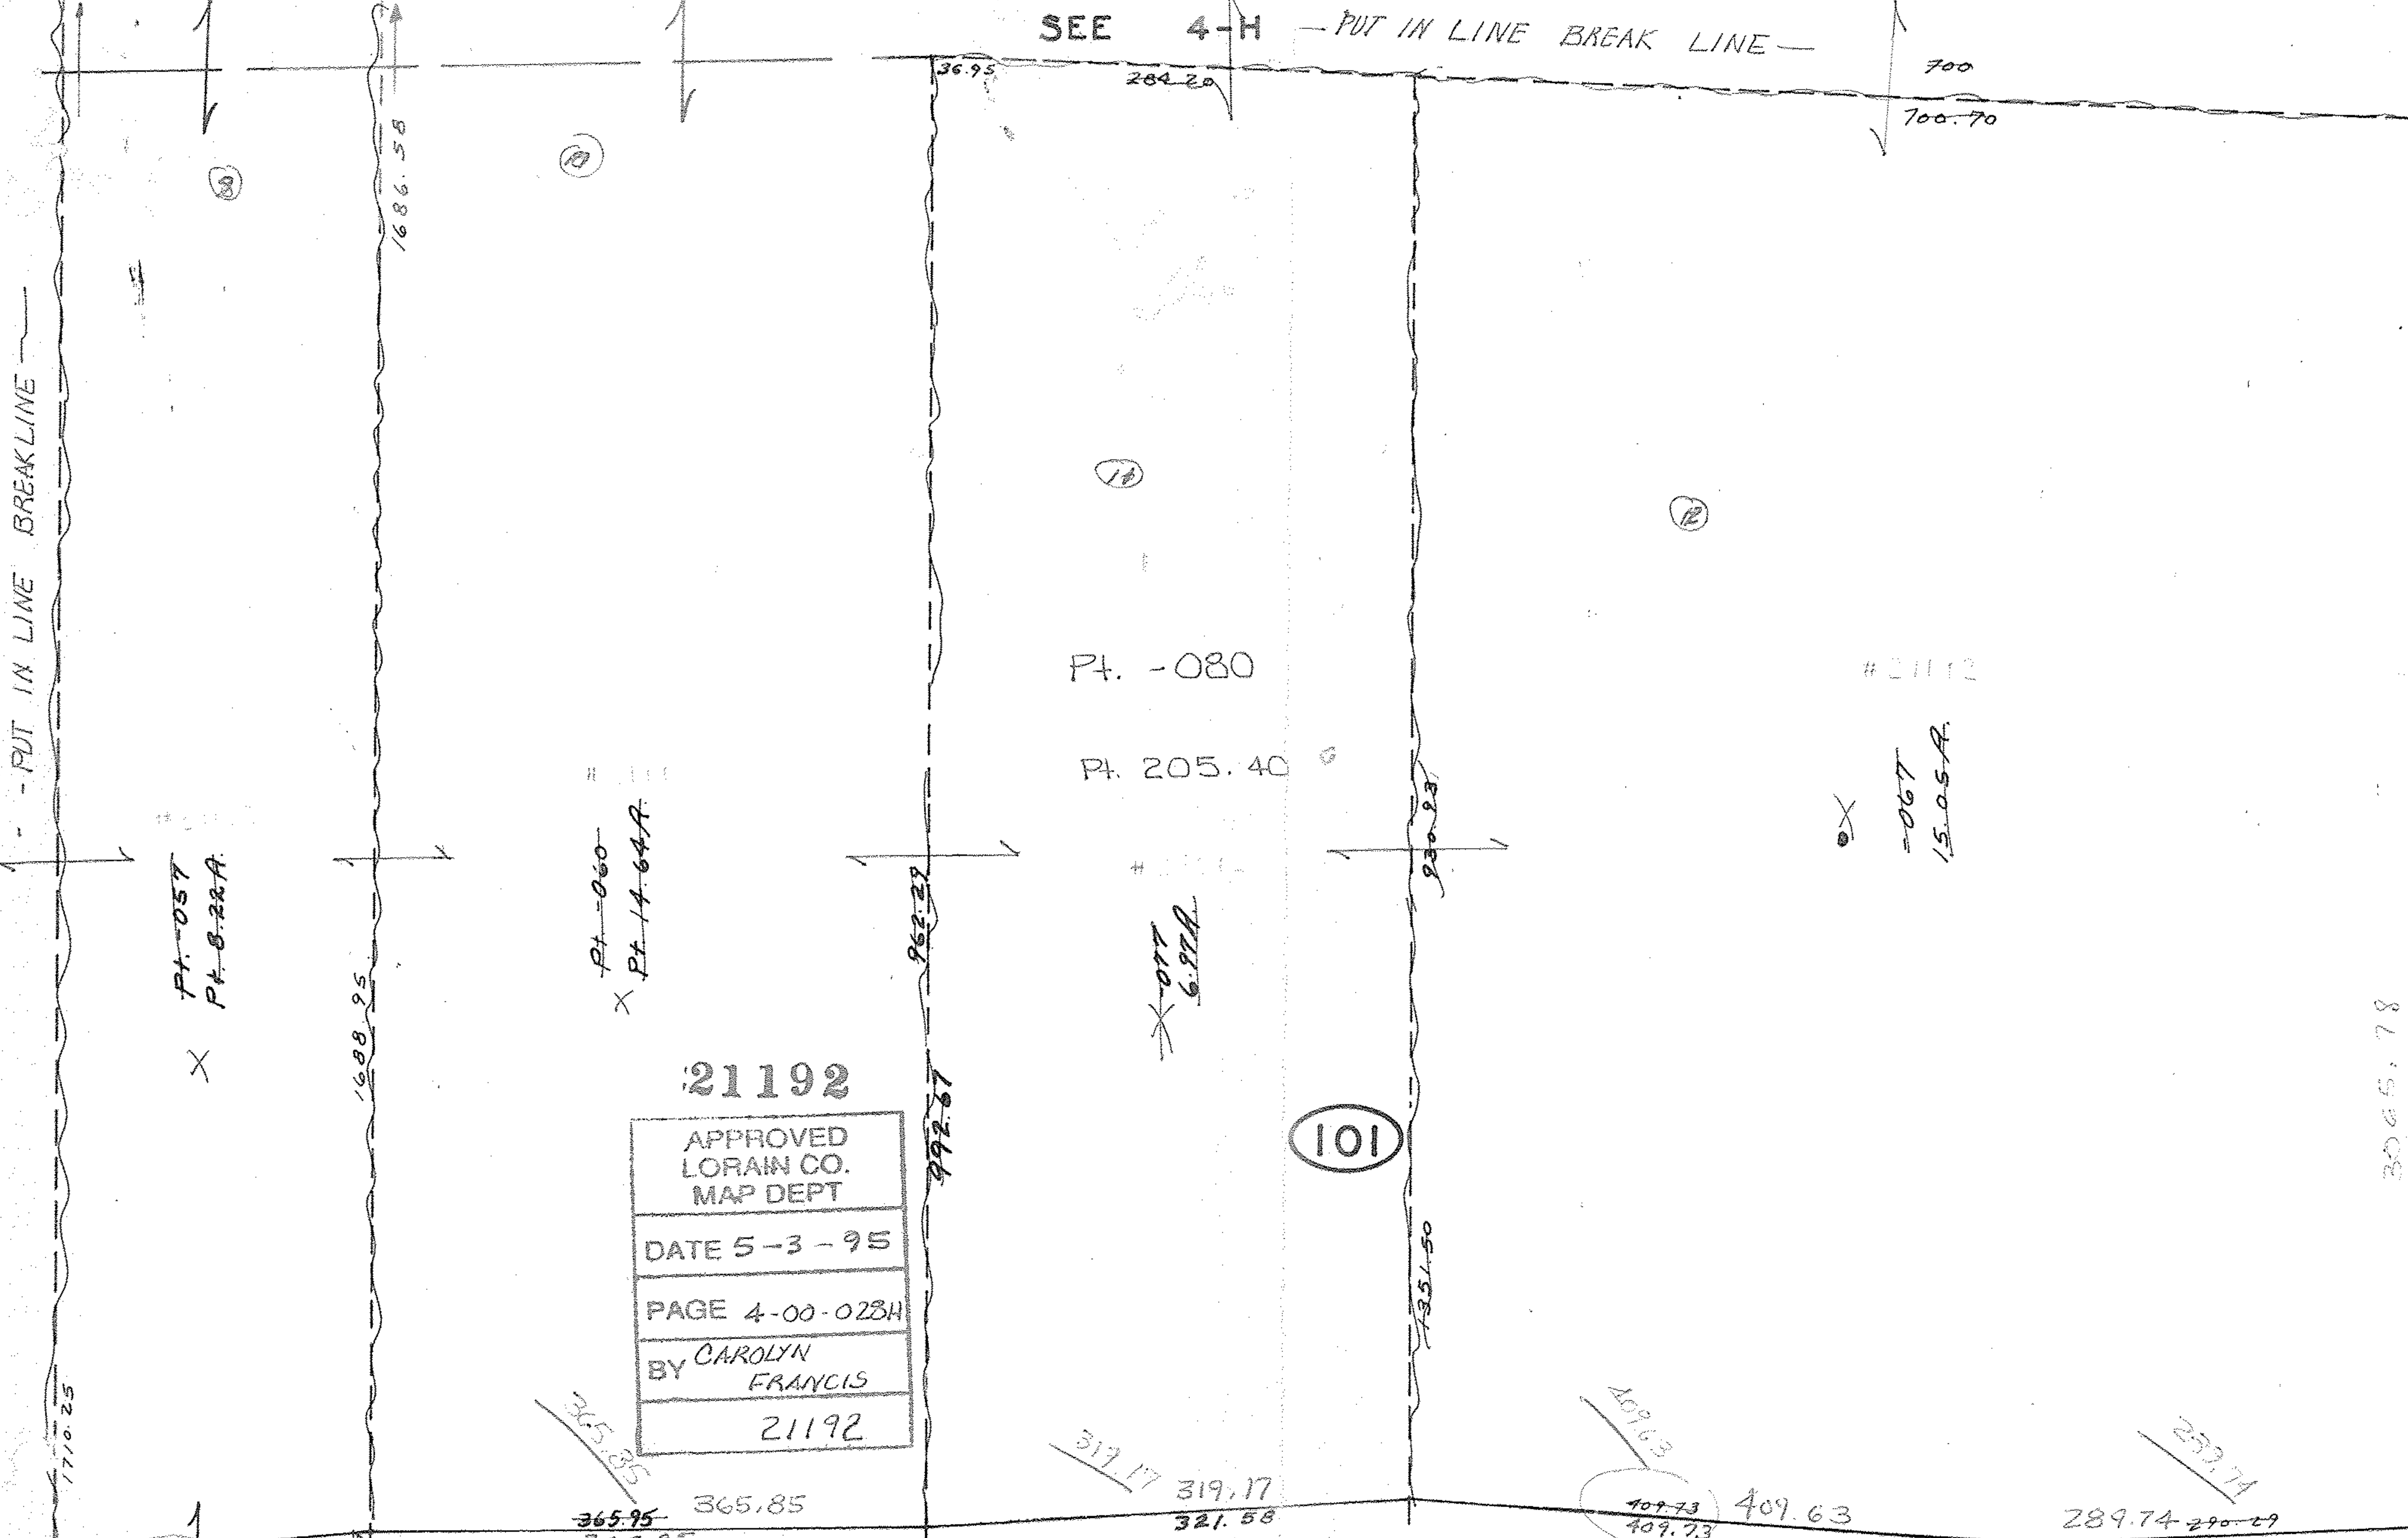

21192

APPROVED
LORAIN CO.
MAP DEPT

DATE 5-3-95

PAGE 4-00-028H

BY CAROLYN
FRANCIS

21192

CHESTER

SERVICE RD.

RD.

211.79

365.95 365.85

319.17 319.17

409.63 409.63

289.74 290.29

-056
25A

-053
.58A

-048
.59A

-072

1.19A

4-00-028

3065.78

211.92