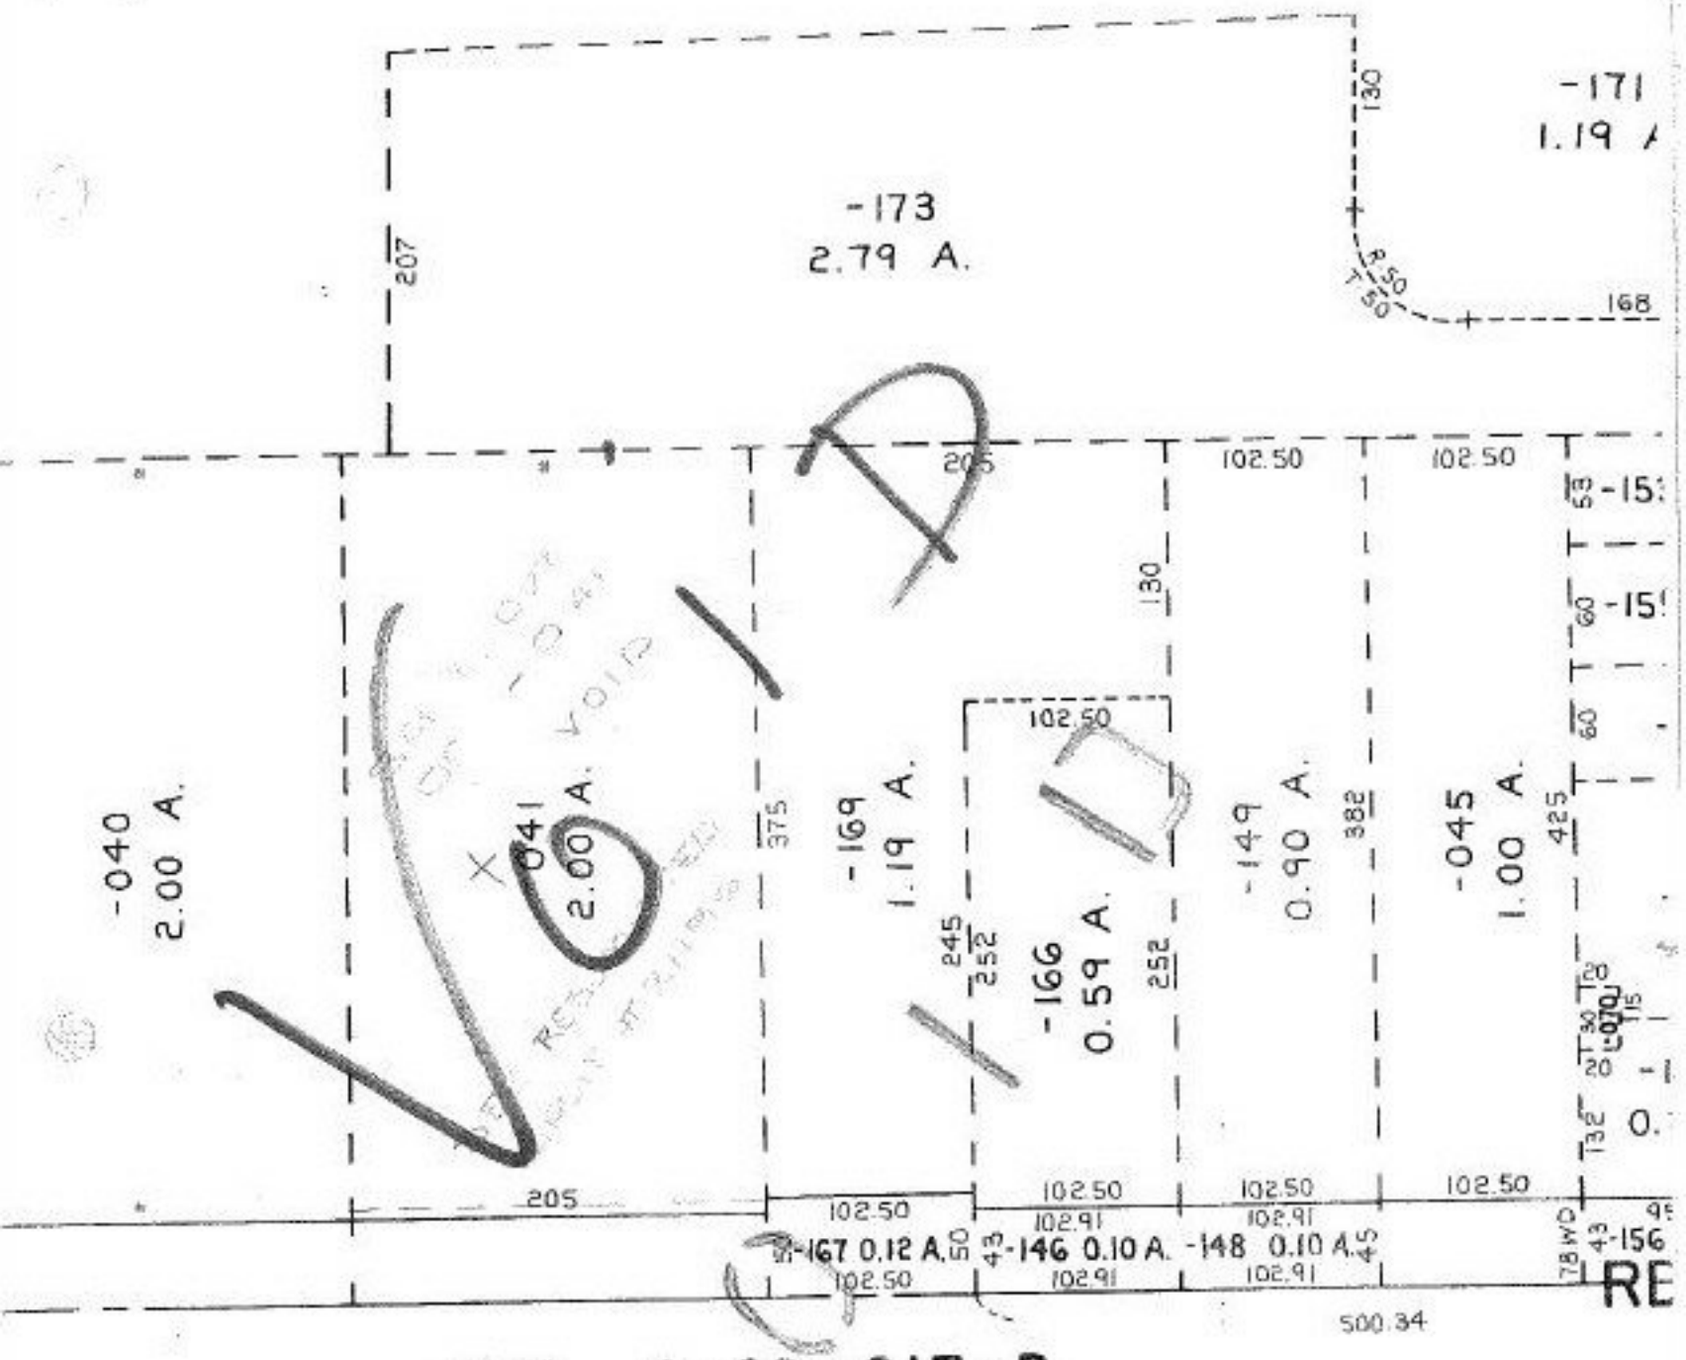

SEE 4-00-017-B

4-24-95

VOID

21193

APPROVED LORAIN CO. MAP DEPT
DATE 1-10-95
PAGE 4-00-018-J
BY CAROLYN FRANCIS
#21193

VON LAKE CITY

E 1" = 100'