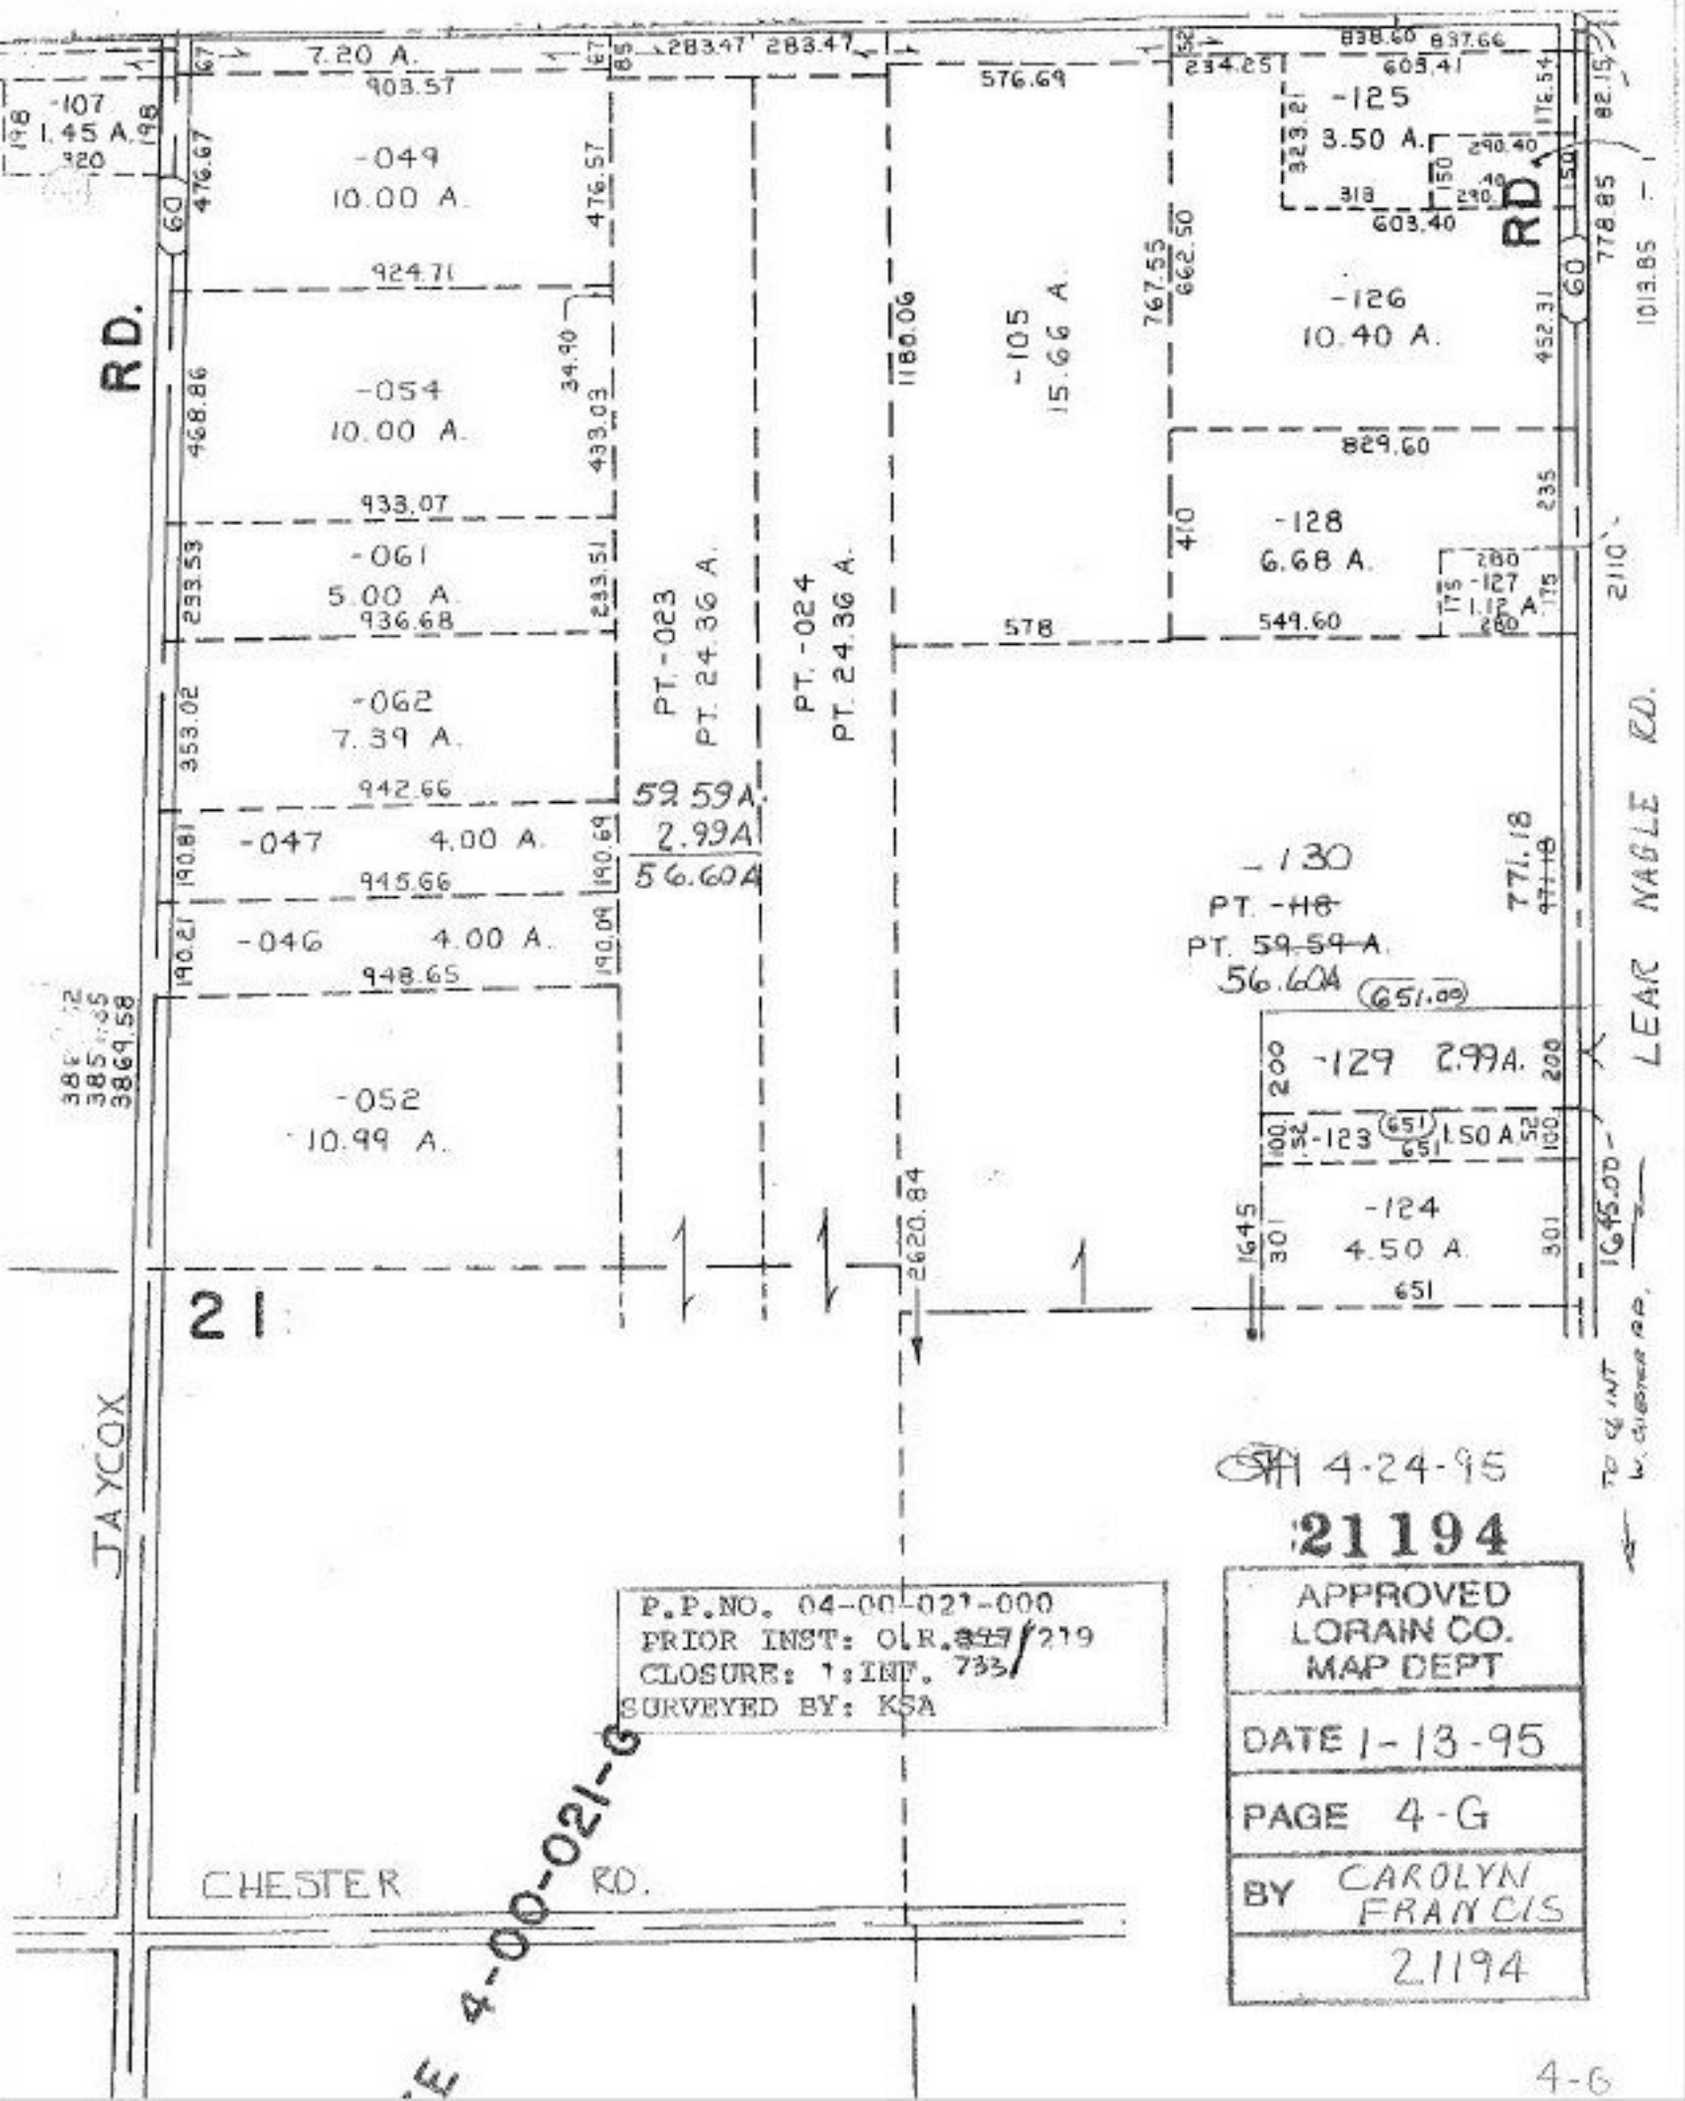

P.P.NO. 04-00-021-000
PRIOR INST: O.R. 857/219
CLOSURE: 1:INT. 733/
SURVEYED BY: KSA

4-24-95

21194

APPROVED LORAIN CO. MAP DEPT
DATE 1-13-95
PAGE 4-G
BY CAROLYN FRANCIS
21194