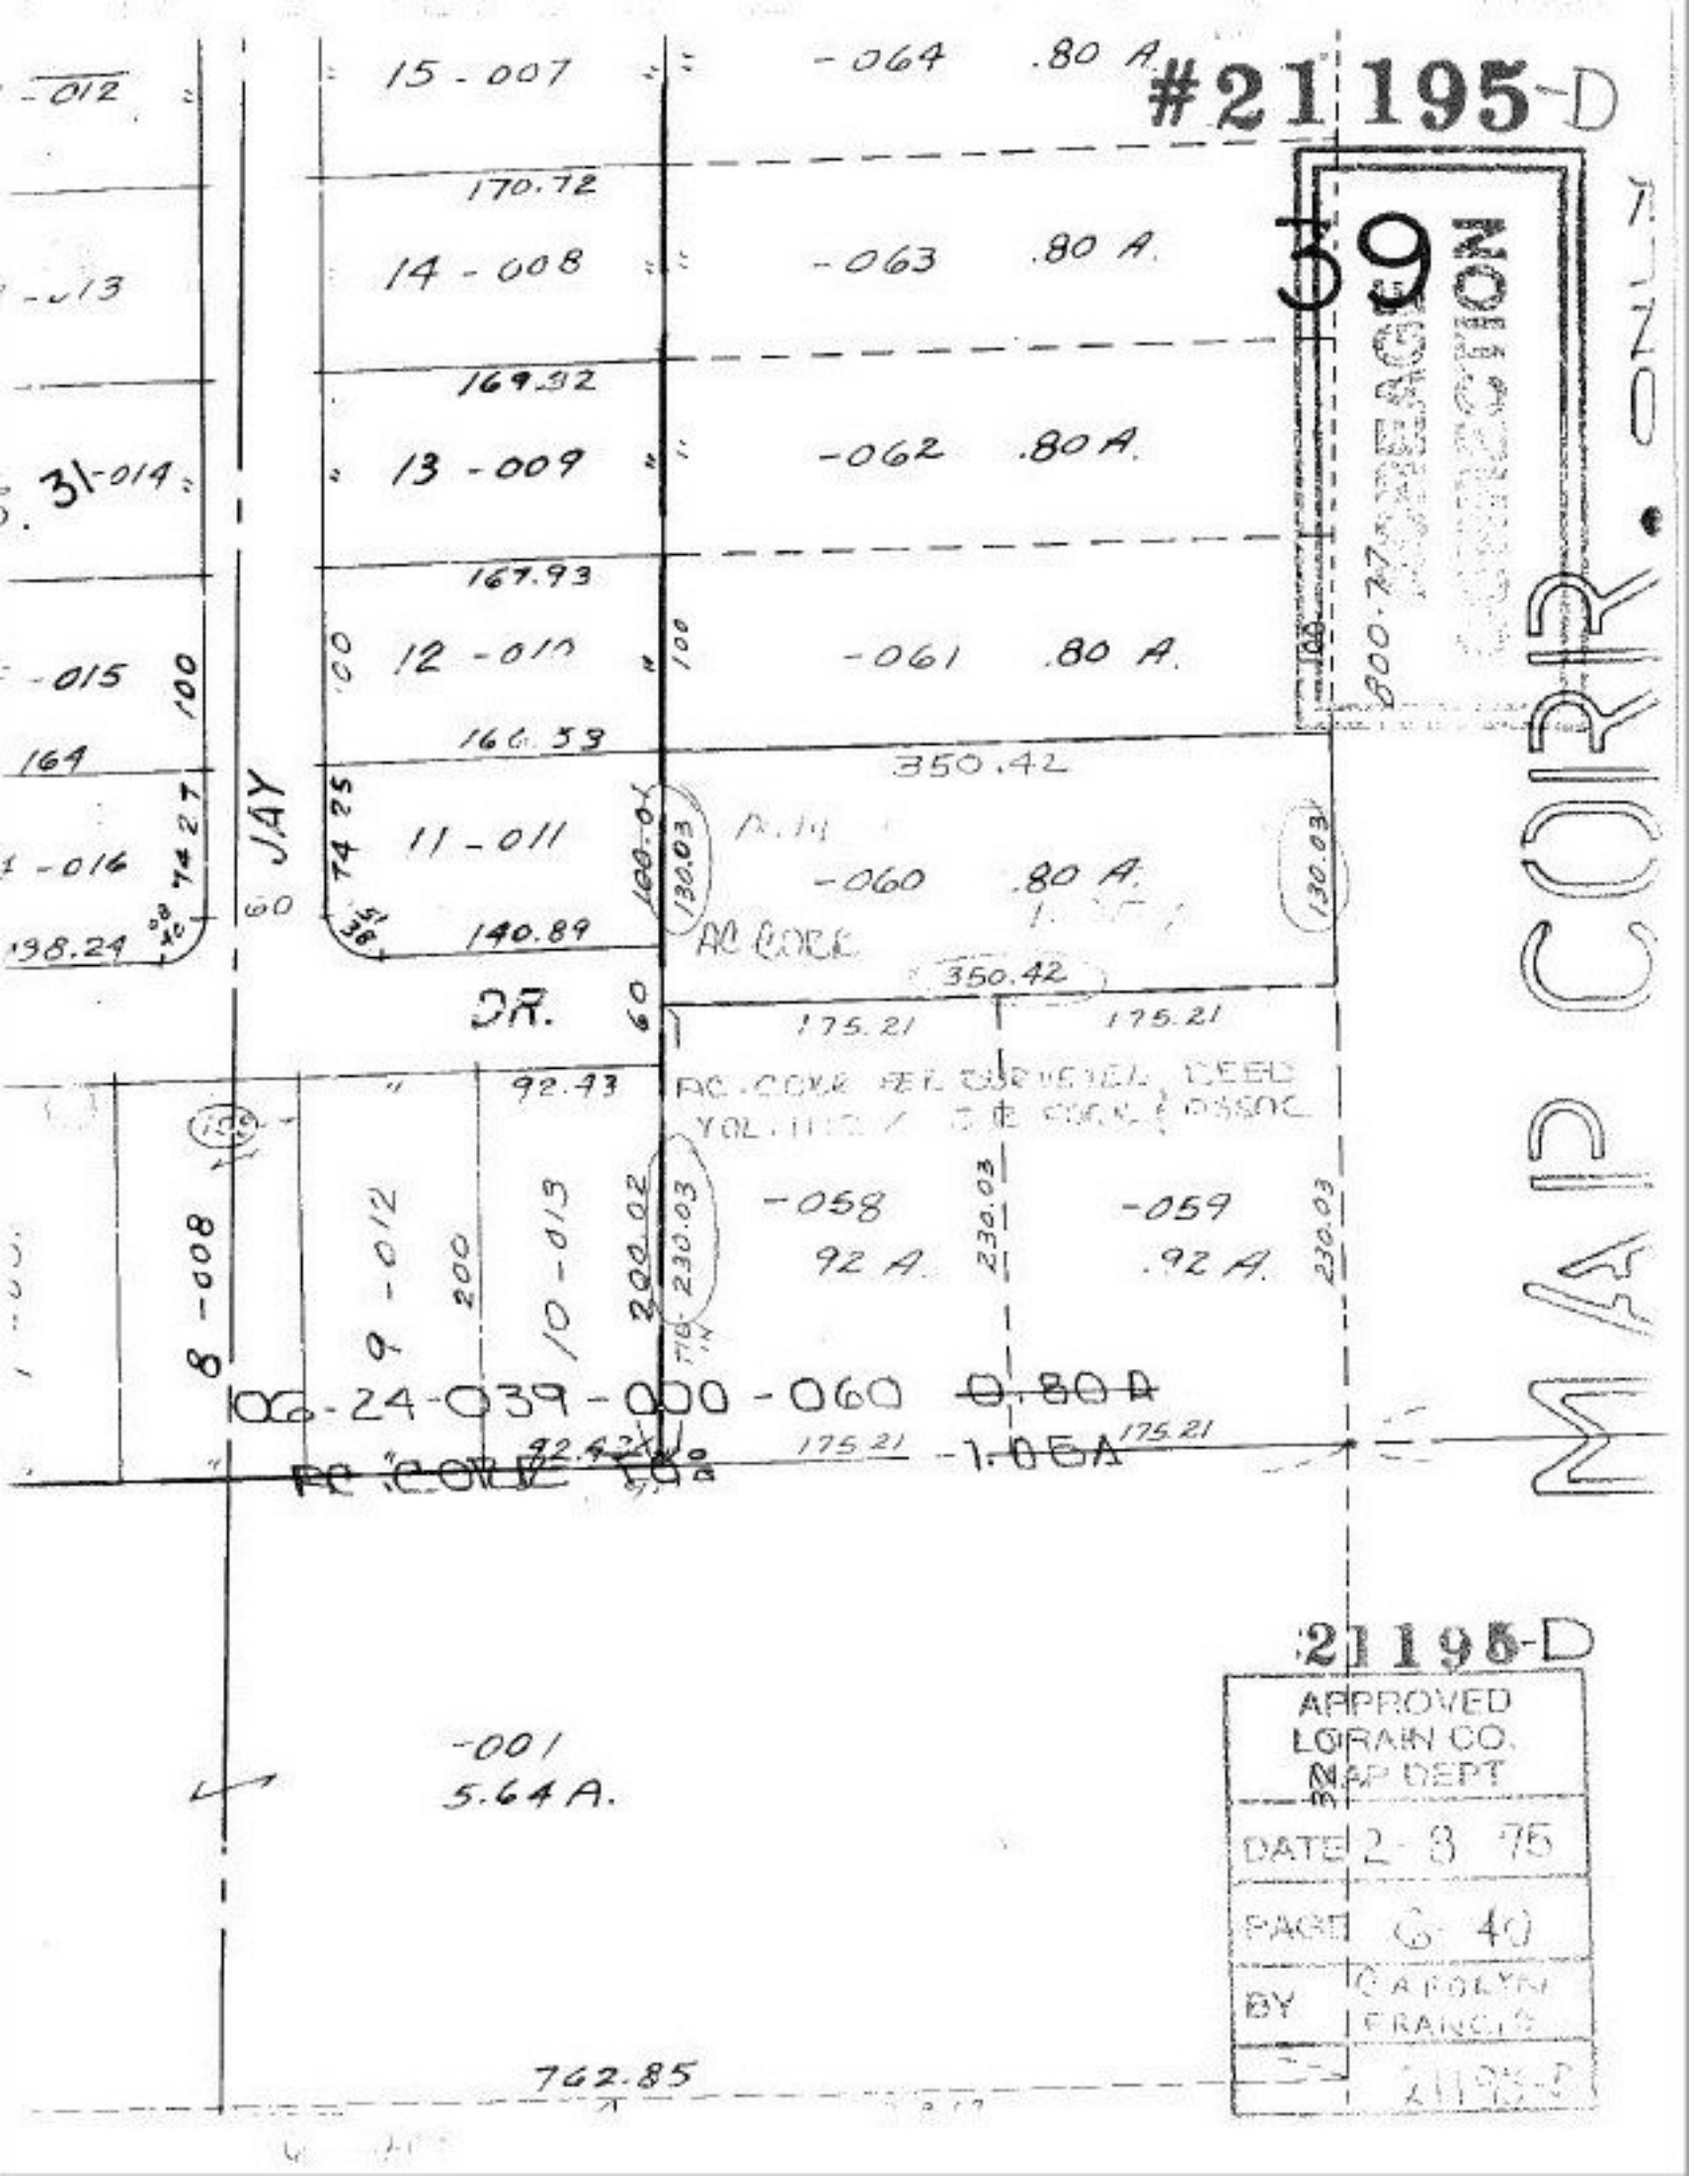
#21195-D
39
ACREAGE CORRECTION
MAP CORR. ONLY
15-007
-064 .80 A.
170.72
14-008
-063 .80 A.
169.32
13-009
-062 .80 A.
167.93
12-010
-061 .80 A.
166.53
350.42
11-011
-060 .80 A.
140.89
AC CORR
350.42
175.21
175.21
92.43
JAY
DR.
8-008
9-012
10-013
-058
92 A.
-059
.92 A.
106-24-039-000-060 ~~0.80 A~~
-1.05A
-001
5.64 A.
762.85
21195-D
APPROVED
LORAIN CO.
MAP DEPT
DATE 2-8-75
PAGE 6-40
BY CAROLYN FRANCIS
21195-D