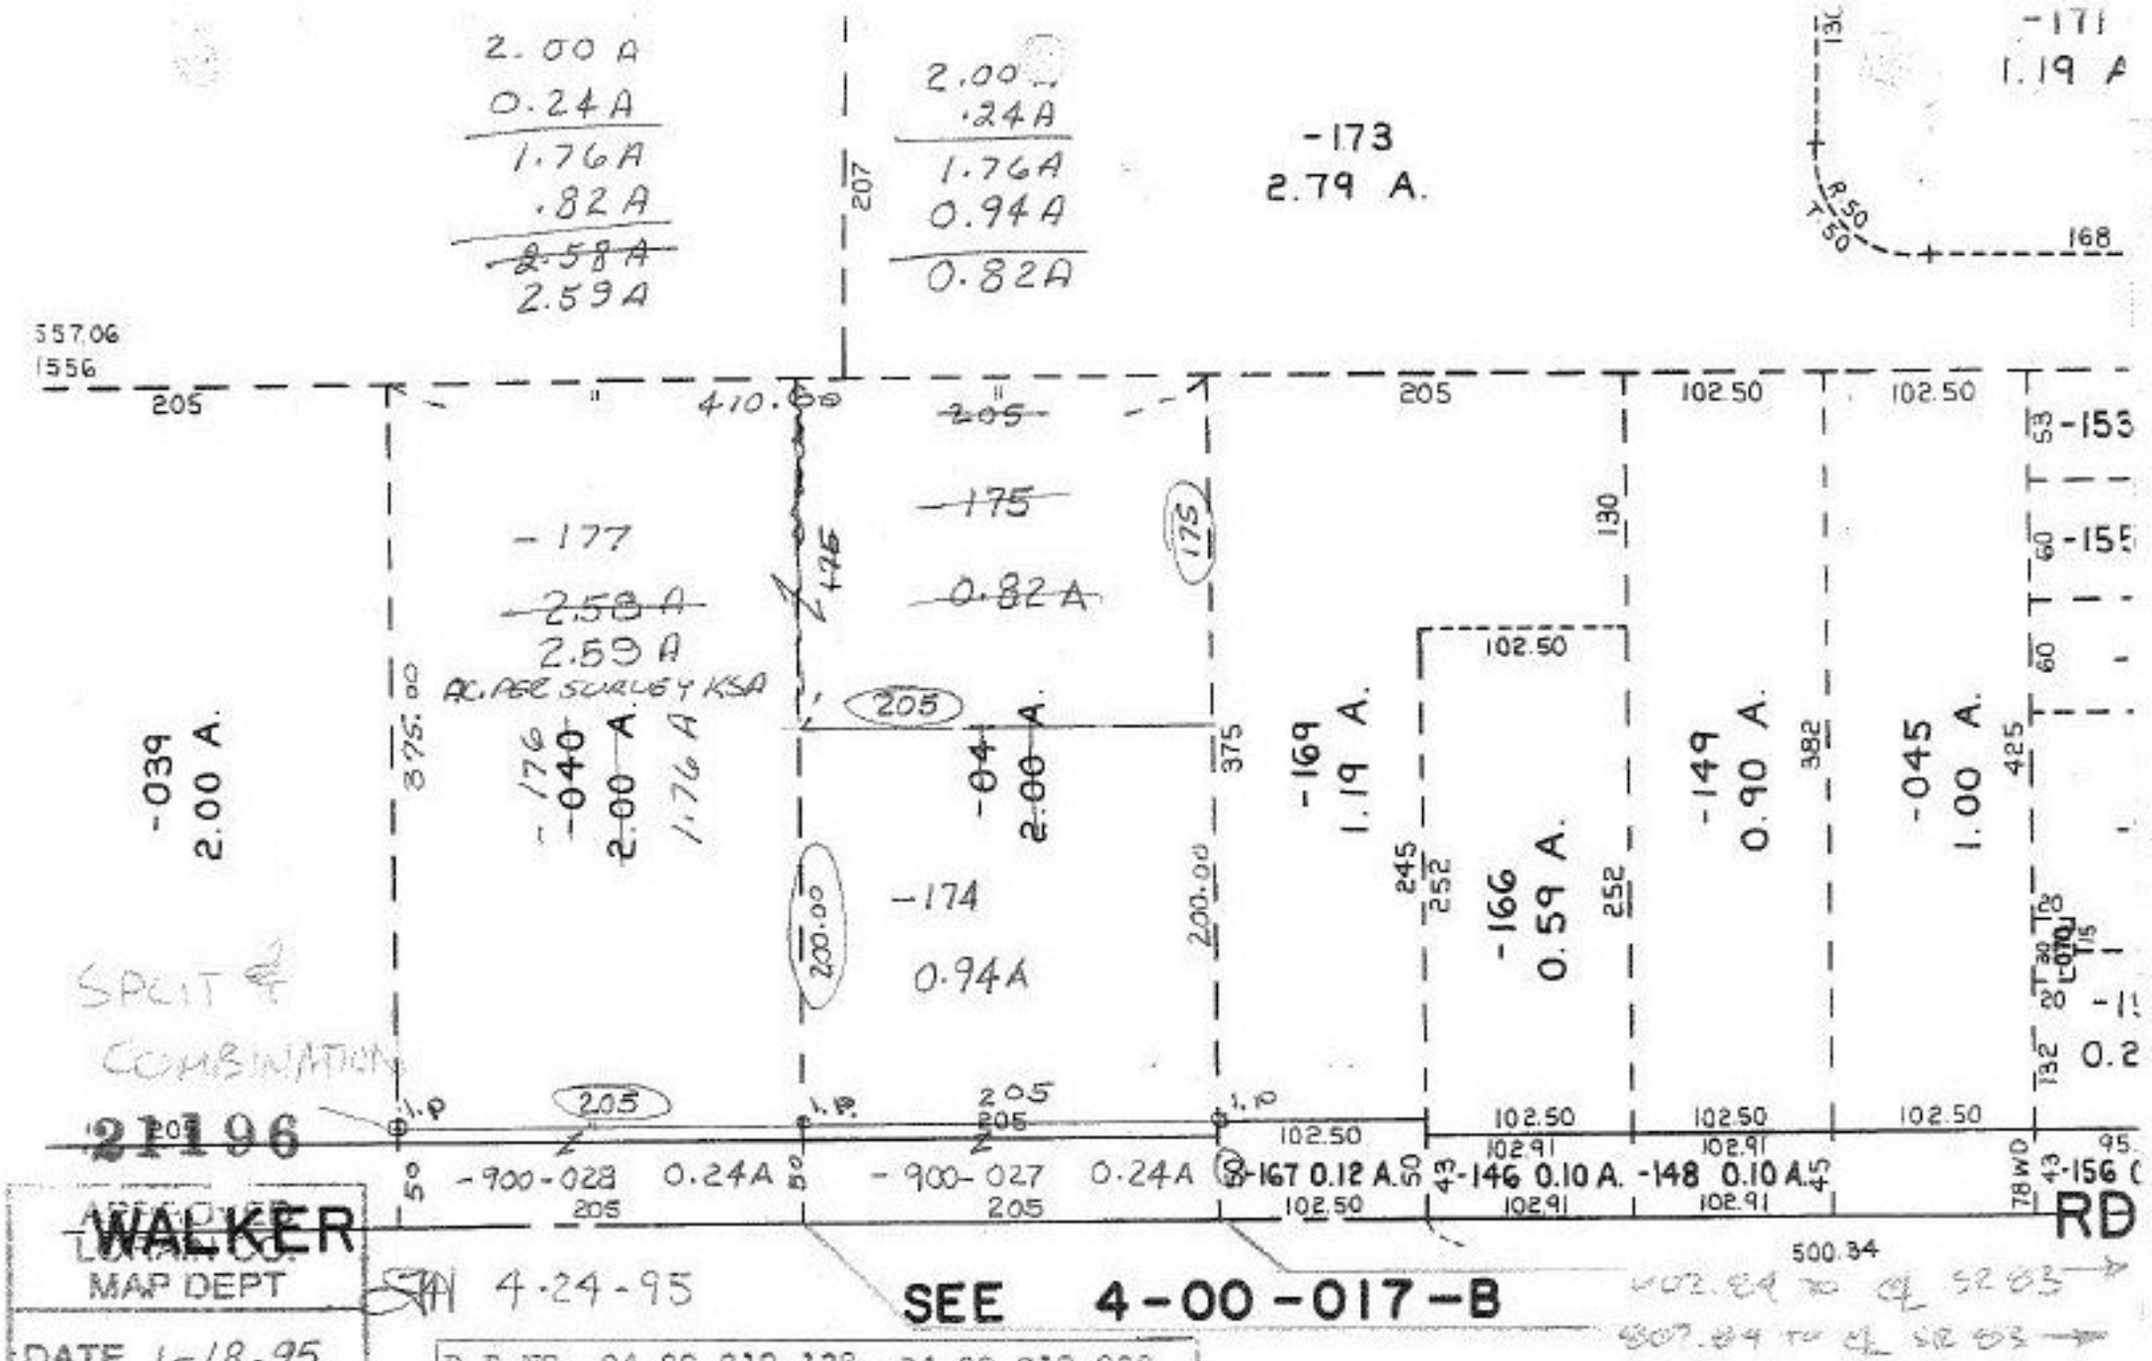


WALKER
APPROVED
LORAIN CO.
MAP DEPT

DATE 1-18-95

PAGE 4-00-018-J

BY CAROLYN FRANCIS

21196

P.P.NO. 04-00-019-128- 04-00-018-900-
PRIOR INST: O.R.1030/117 O.R.63/356
CLOSURE: 1:INF. SURVEYED BY: KSA