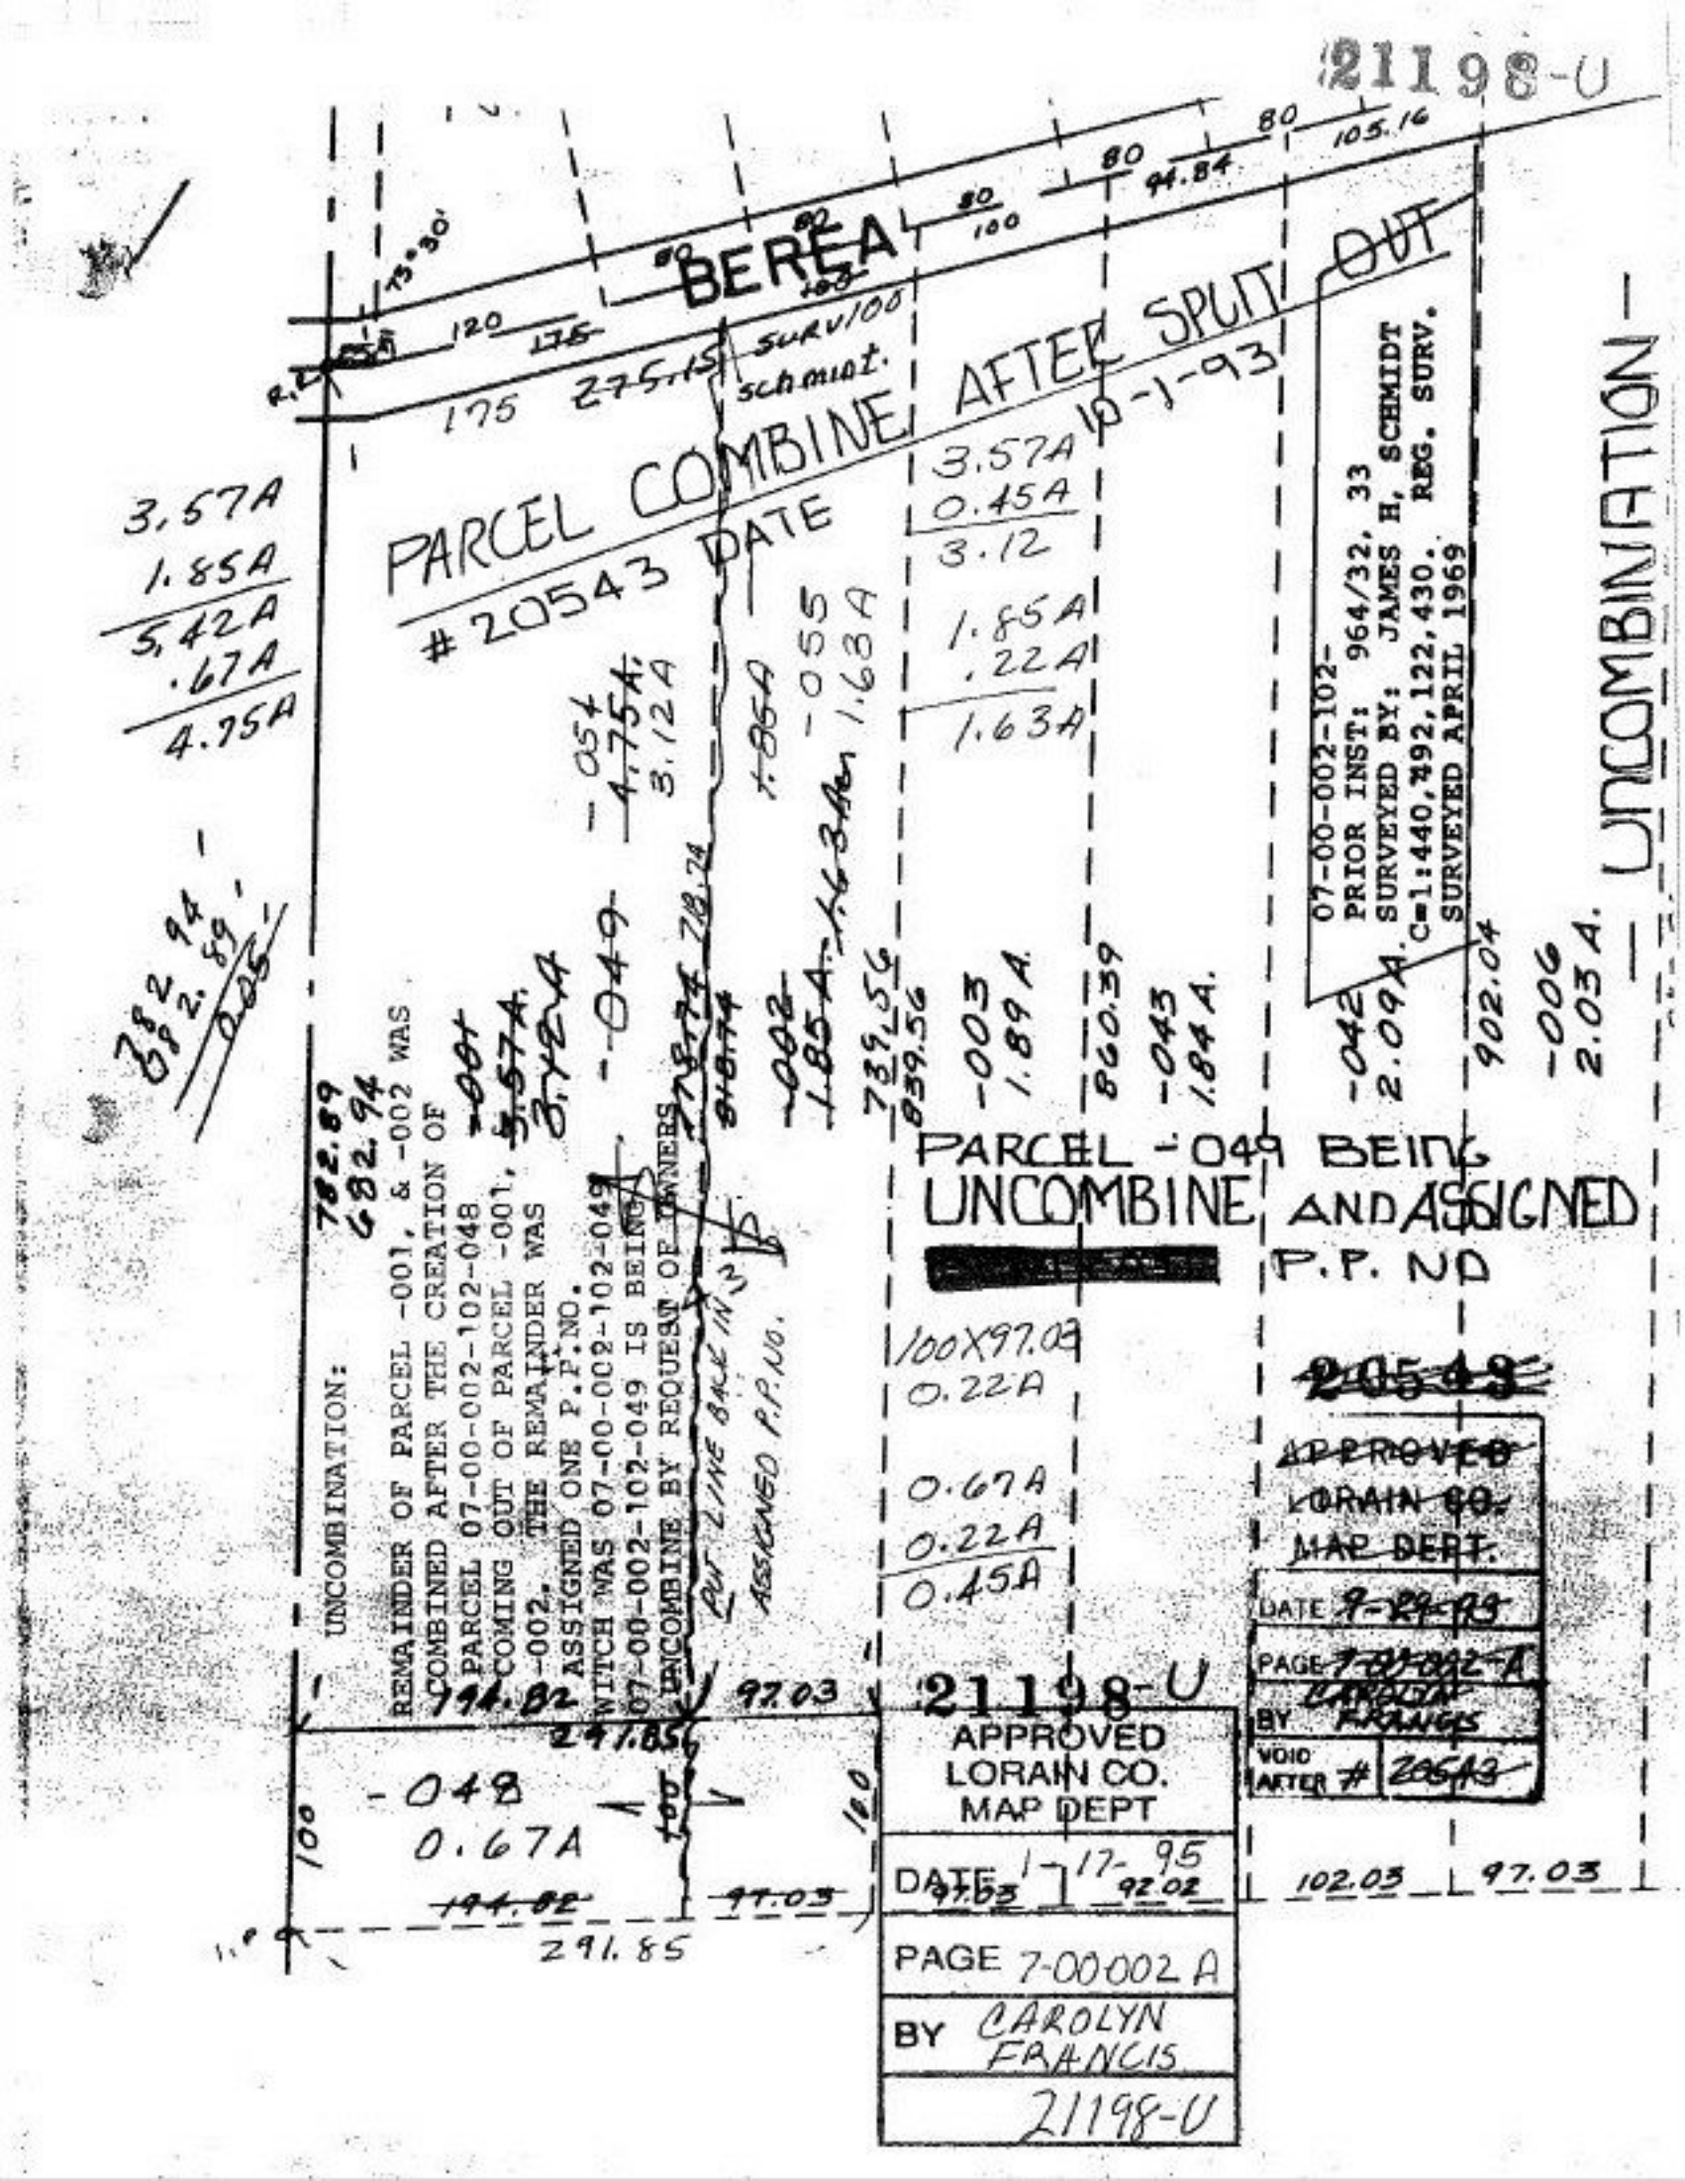
21198-U
BEREA
PARCEL COMBINE AFTER SPLIT OUT
#20543 DATE 10-1-93
UNCOMBINATION
UNCOMBINATION:
REMAINDER OF PARCEL -001, & -002 WAS COMBINED AFTER THE CREATION OF PARCEL 07-00-002-102-048
COMING OUT OF PARCEL -001, -002. THE REMAINDER WAS ASSIGNED ONE P.P.NO. WITCH WAS 07-00-002-102-049
07-00-002-102-049 IS BEING UNCOMBINE BY REQUEST OF OWNERS
PUT LINE BACK IN
ASSIGNED P.P.NO.
07-00-002-102-
PRIOR INST: 964/32, 33
SURVEYED BY: JAMES H, SCHMIDT
C=1:440,792,122,430. REG. SURV.
SURVEYED APRIL 1969
PARCEL -049 BEING UNCOMBINE AND ASSIGNED P.P. NO
-048
0.67A
-049
-042
2.09A.
-043
1.84A.
-003
1.89A.
-006
2.03A.
APPROVED LORAIN CO. MAP DEPT.
DATE 9-29-93
PAGE 7-00-002-A
BY CAROLYN FRANCIS
VOID AFTER # 20543
APPROVED LORAIN CO. MAP DEPT
DATE 1-17-95
PAGE 7-00-002 A
BY CAROLYN FRANCIS
21198-U