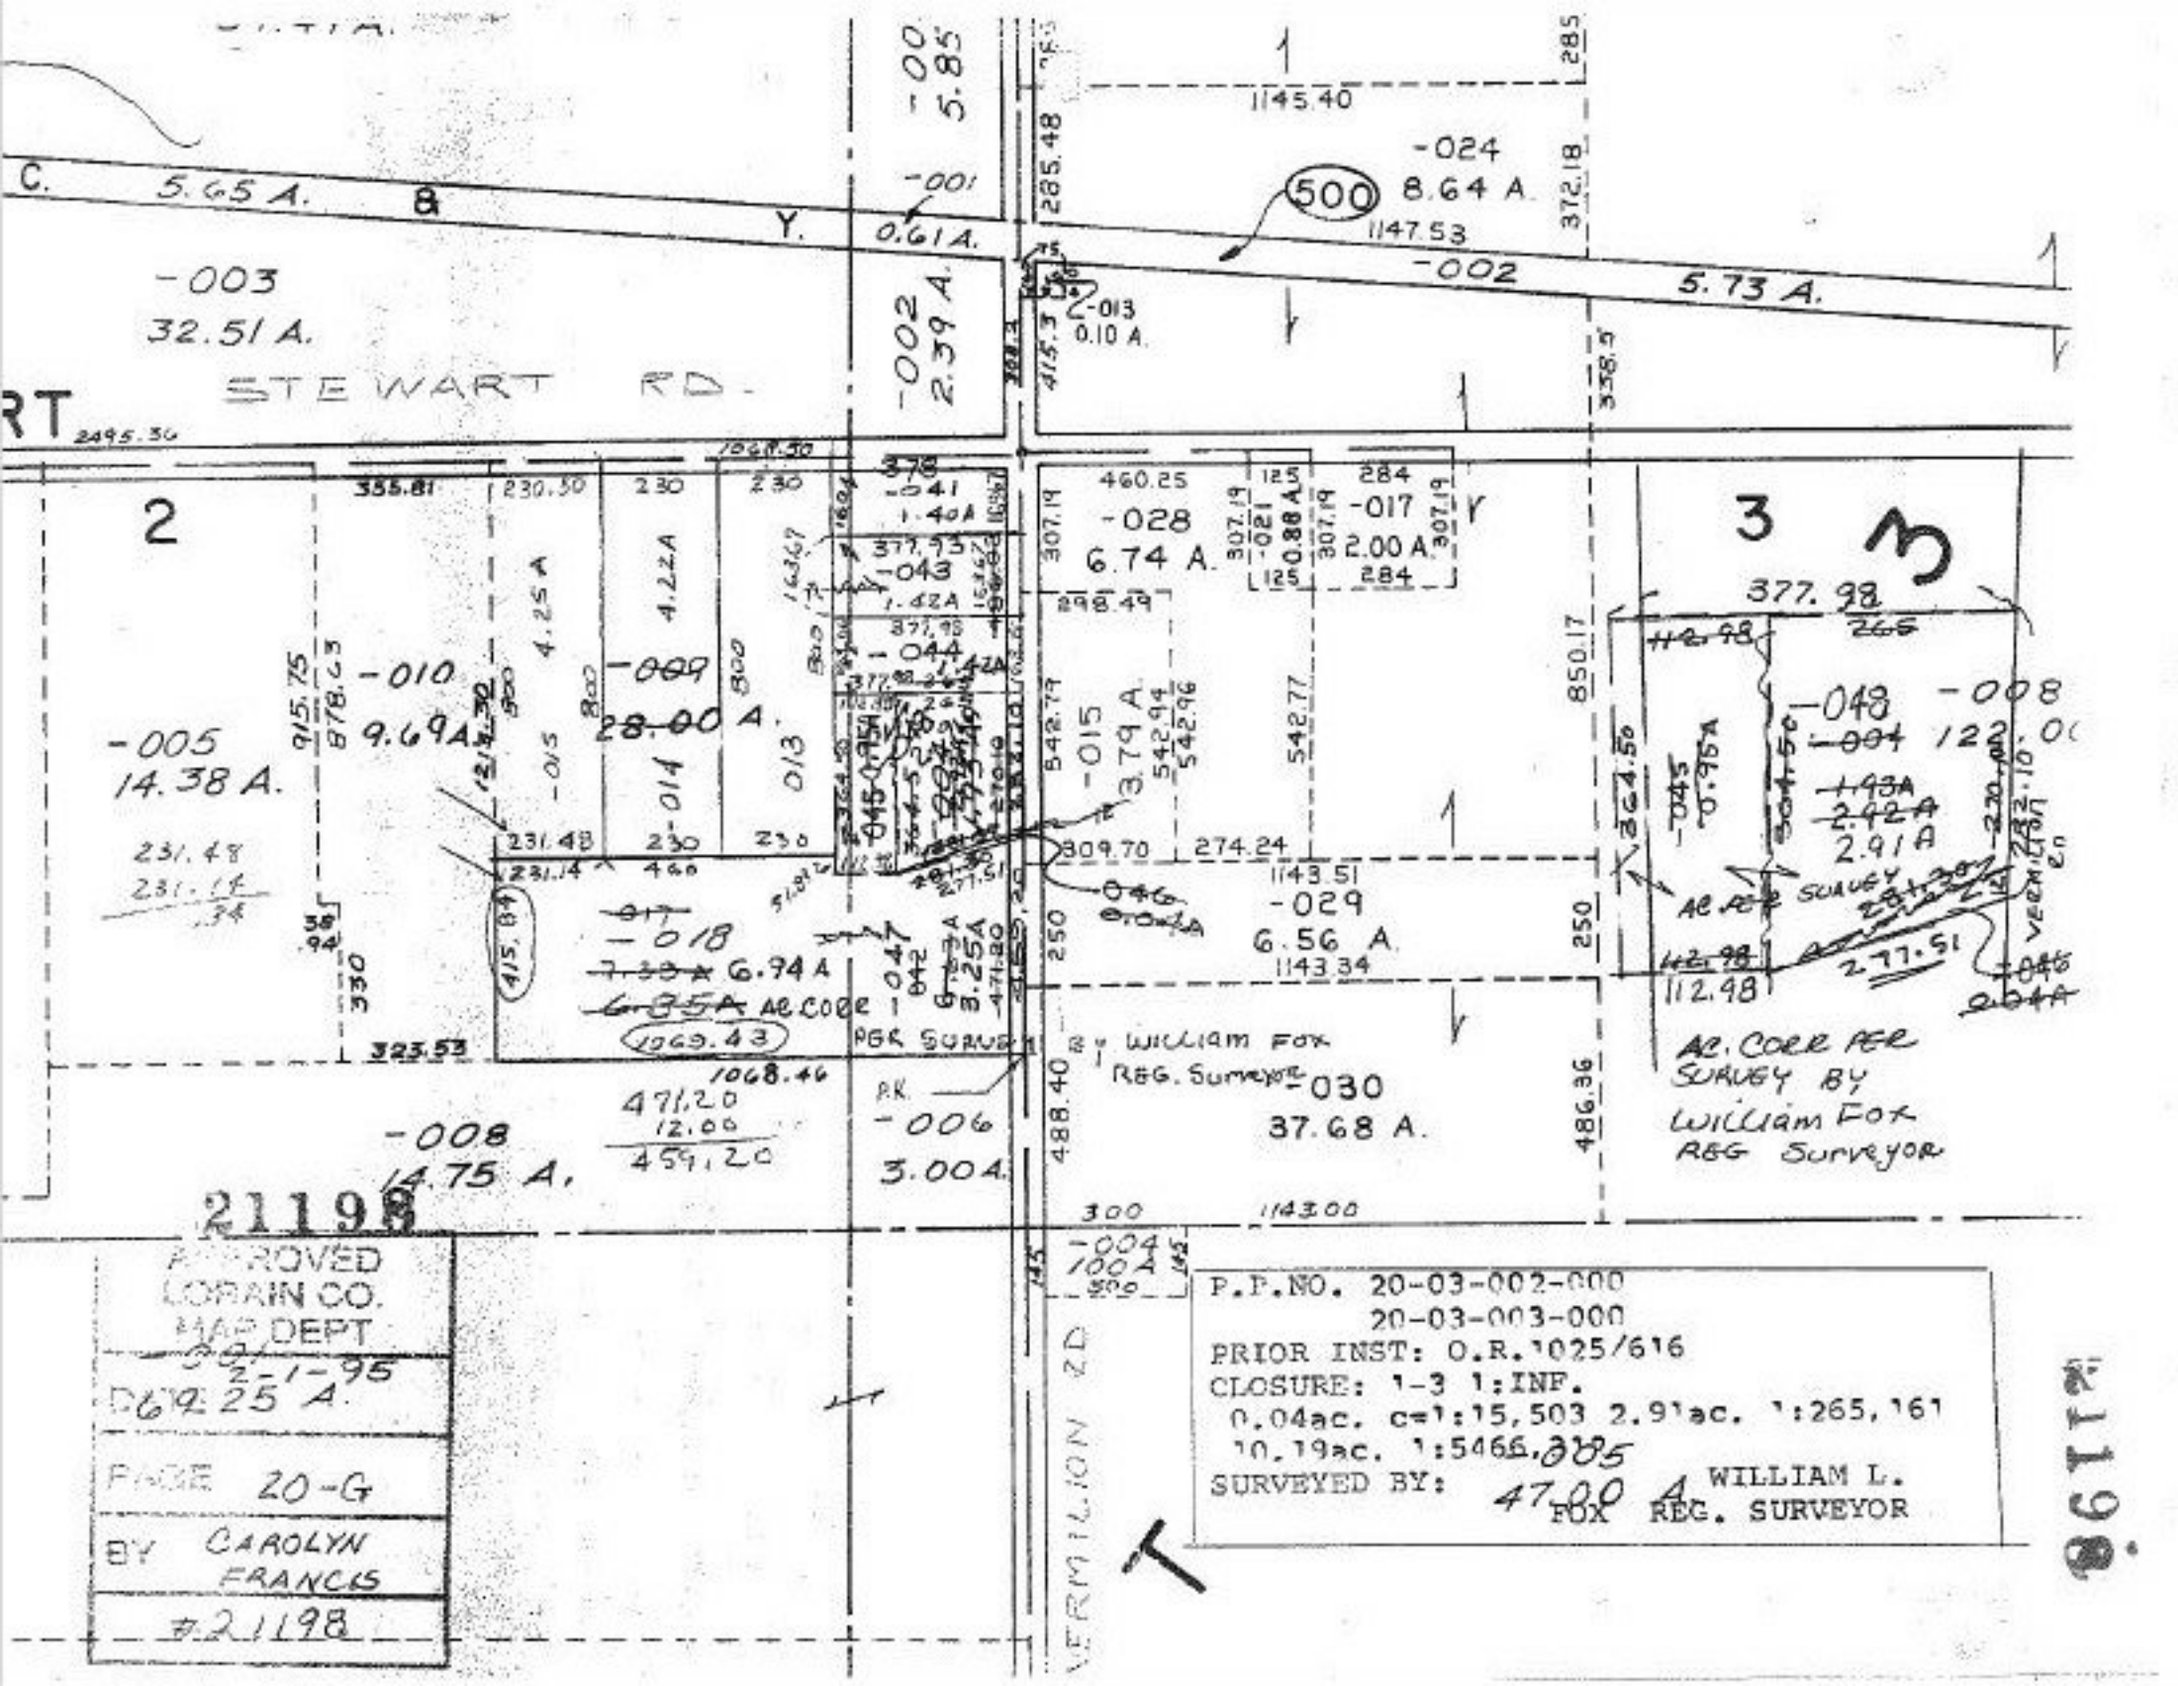
STEWART RD.
-003
32.51 A.
-002
2.39 A.
-001
0.61 A.
-002
5.73 A.
-013
0.10 A.
-024
8.64 A.
500
1145.40
1147.53
-010
9.69 A.
-005
14.38 A.
-009
28.00 A.
-014
-015
3.79 A.
-028
6.74 A.
-017
2.00 A.
-021
0.88 A.
-041
1.40 A.
-043
1.42 A.
-044
1.42 A.
-045
0.95 A.
-046
0.04 A.
-048
-004
1.22
1.93 A.
2.42 A.
2.91 A.
-018
6.74 A.
-047
3.25 A.
-029
6.56 A.
-030
37.68 A.
-008
14.75 A.
-006
3.00 A.
-004
1.00 A.
AC. CODE PER SURVEY BY WILLIAM FOX REG. SURVEYOR
2
3
377.98
850.17
486.36
488.40
1143.34
1143.51
1143.00
471.20
12.00
459.20
1068.46
1069.43
323.53
231.48
231.14
355.81
230.50
P.P.NO. 20-03-002-000
20-03-003-000
PRIOR INST: O.R. 1025/616
CLOSURE: 1-3 1:INF.
0.04ac. c=1:15,503 2.91ac. 1:265,161
10.19ac. 1:5466,385
SURVEYED BY: 47.00 A. WILLIAM L. FOX REG. SURVEYOR
APPROVED
LORAIN CO.
MAP DEPT
2-1-95
D69.25 A.
PAGE 20-G
BY CAROLYN FRANCIS
#21198
21198
